
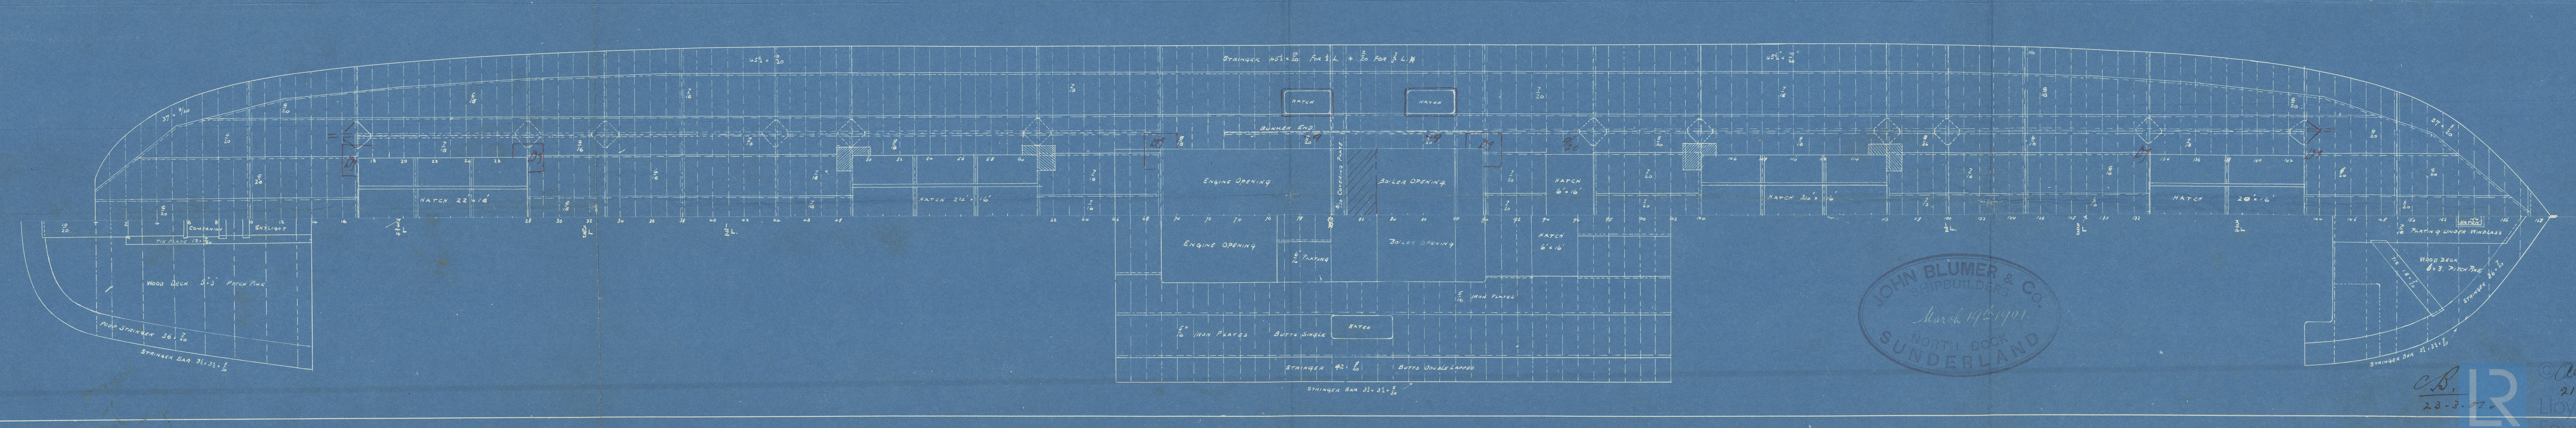


23. 3. 07  
 26. 9. 07 Hood  
*Handwritten notes:*  
 24/9/07  
 26. 9. 07 Hood  
 24/9/07

**— PROFILE AND DECK PLAN No 164. —**  
 SCALE  $\frac{1}{8}$  INCH = ONE FOOT.

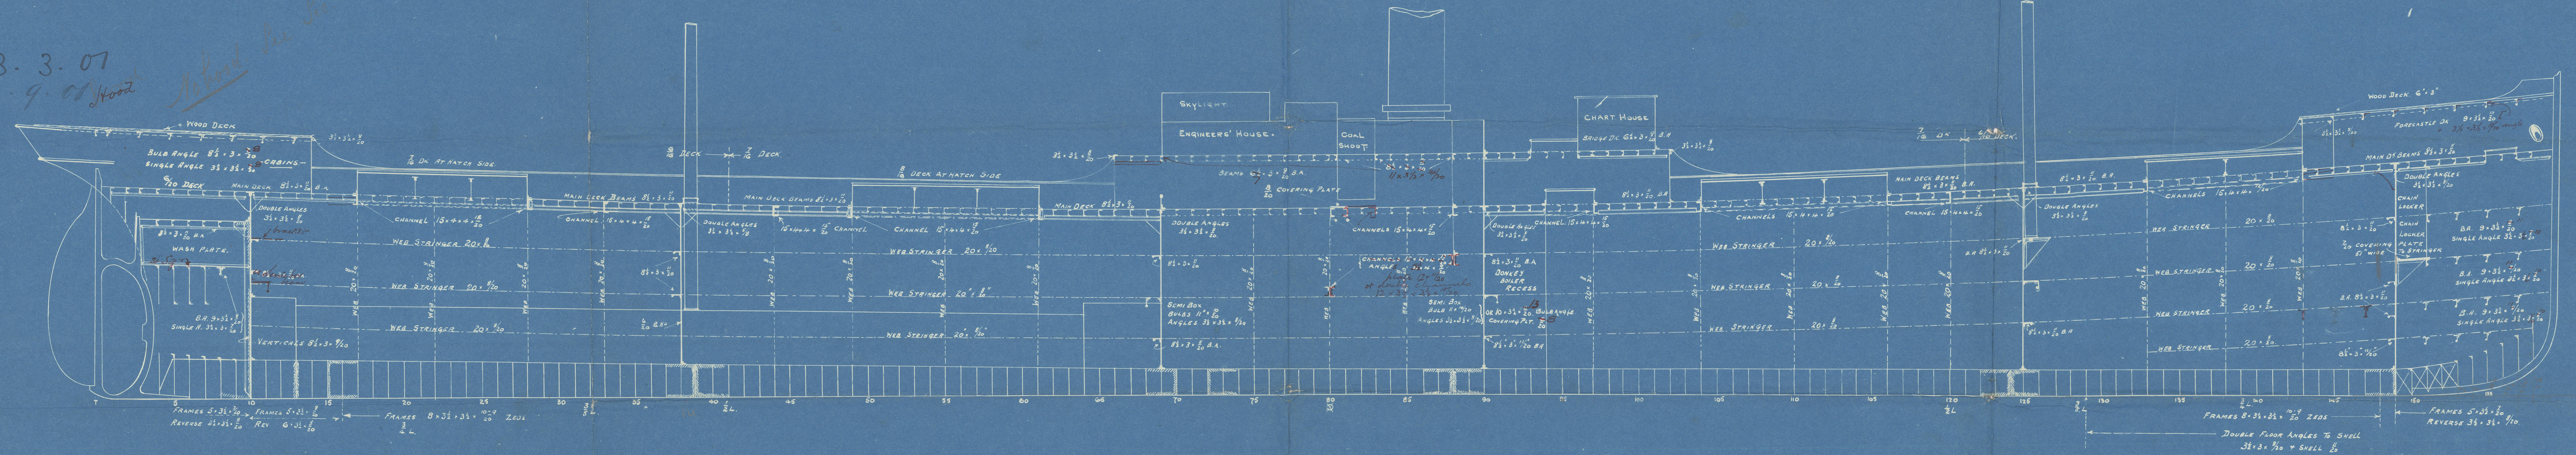

**JOHN BLUMER & CO.**  
 SHIPBUILDERS  
 March 1907  
 NORTH DOCK  
 SUNDERLAND

*Handwritten:*  
 23-3-07  
 Lloyd's Register  
 Foundation



Blumer's  
No 164  
PROFILE



S.S. "Poldhu",  
Sunderland. No. 20821



© 2020

Lloyd's Register  
Foundation

W1273-0137