

N^{OS.} 337 ROSEWORTH
MIDSHIP SECTION. STANDARD VESSEL TYPE "H."

SCALE: - $\frac{1}{2}$ INCH = ONE FOOT.

DIMENSIONS LENGTH B.P. 303'-0" BREADTH MLD. 42'-9" DEPTH MLD. 23'-0"

CLASS 100. F.I. LLOYDS AND
B.S.* BRITISH CORPORATION

20/6/18
20/6/18

No. 4398 Date, 20/11/16 Ex Data


W1275-0243

Dunlop Bremner & Co Ltd
No 334.

Midship Section
(as built).

S. S. Roseworth

Grk Rep No 17575.

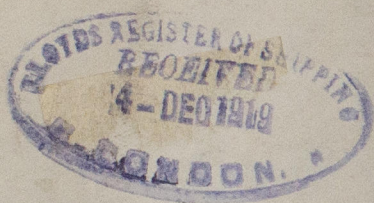

RETAIN



© 2021

Lloyd's Register
Foundation

W1275-0243