


28. 2. 06

N^{os} 798-9-800


ELEVATION

TO CLASS 100A1 LLOYDS

SCALE 1/4" = 1 FOOT.

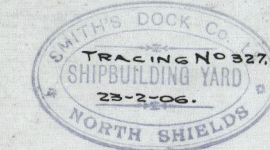

For attention to position of
Collision bulkhead & sink
forecastle see amended
profile dated 8/1/06.

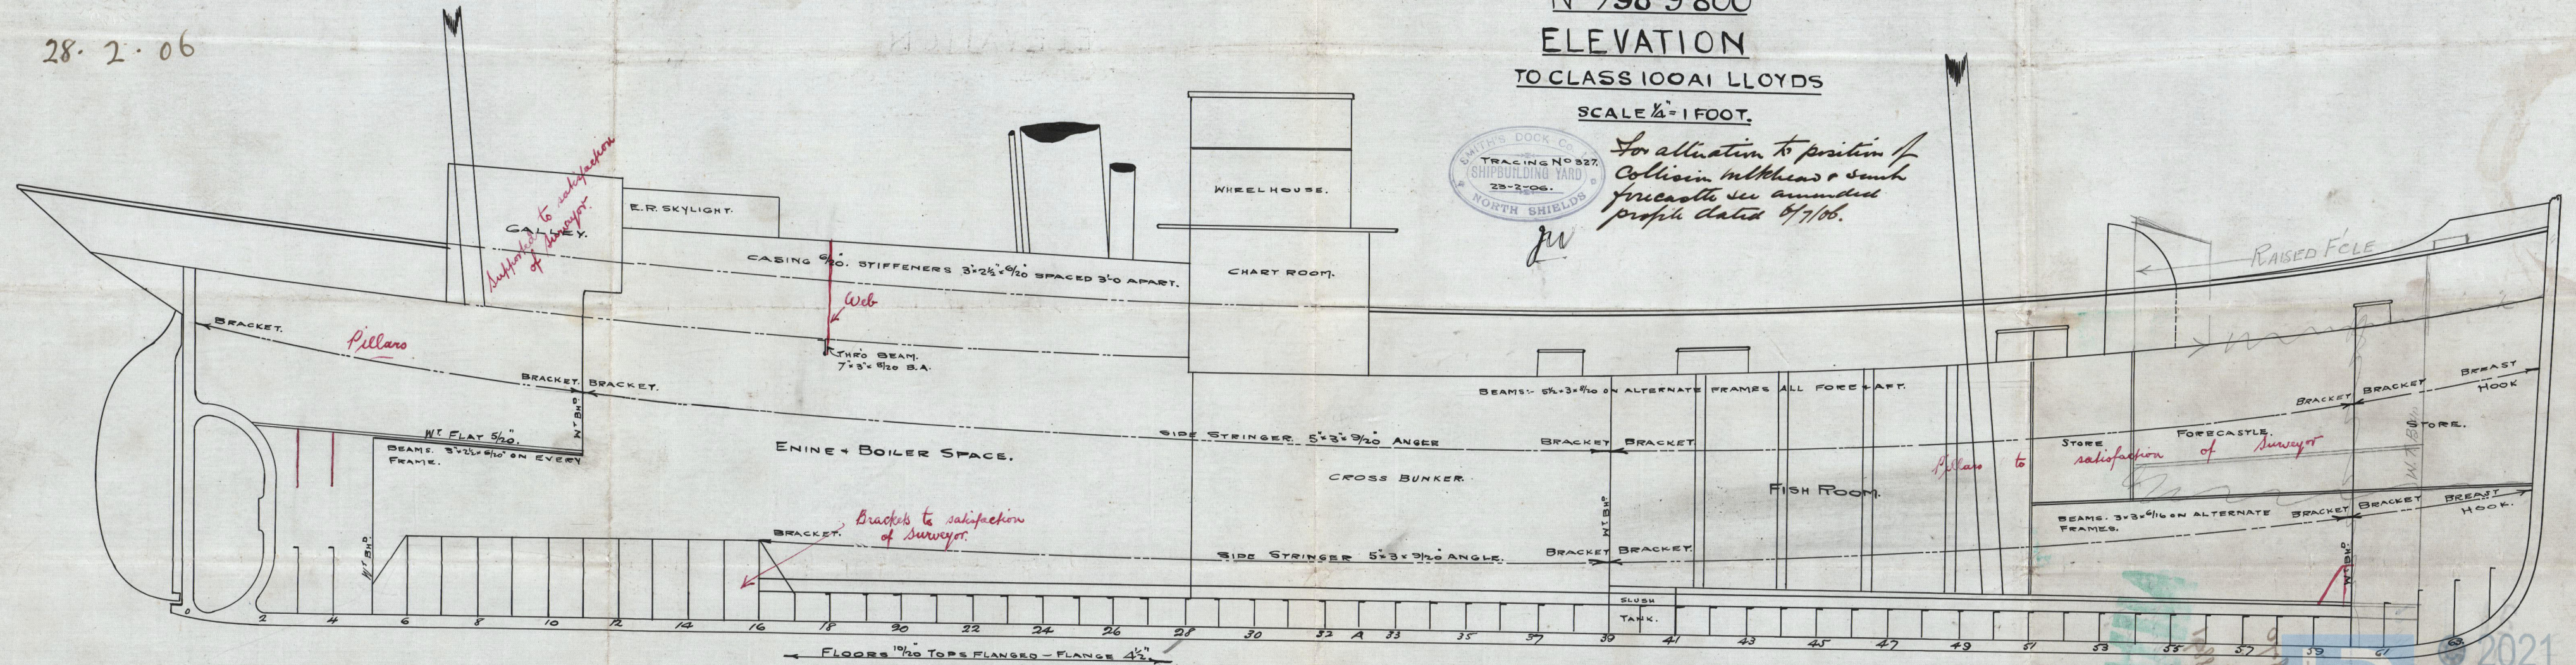

2021

Lloyd's Register
Foundation


W1275-0271

2107 1000
008 000 001 001
2107 1000
008 000 001 001

SMITHS DOCK CO. LD.

Nos 798, 99, & 800

PROFILE

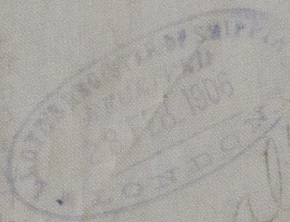

alterations

D.122

S.S. India *

Newcastle Report

No 51434

S.S. Persia

No 51870

S.S. Arabia

No 51889

File with T. Christie
(of India)

Lloyd's Register
Foundation