



28. 2. 06

NUMERALS:-
1/2 BREADTH-----10.71.
DEPTH-----12.83.
1/2 GIRTH-----18.55.
1ST NUMBER-----42.09.
LENGTH-----115.87.
2ND NUMBER-----4576.96.
 $\frac{L}{B} = 5.41. \quad \frac{L}{D} = 9.03.$

-N^{OS} 798-9-800.-

-MIDSHIP-SECTION.-

-OF 3.-

-STEEL-SCREW-TRAWLERS.-



-TO CLASS 100A1. LLOYDS.-

-DIMS:-117'-0 BP x 21'-6 EXT x 12'-4 DEPTH. MLD.-

-SCALE 1/2" = 1 FOOT.-

-EQUIPMENT.-

ANCHOR-----5 CWTs EX. STOCK
"-----4 1/2 " " "
"-----2 1/2 " " "
90 FATHOMS-----1" STUD LINK CHAIN.
60 "-----5 1/2" HAWSER.
60 "-----4" WARP.

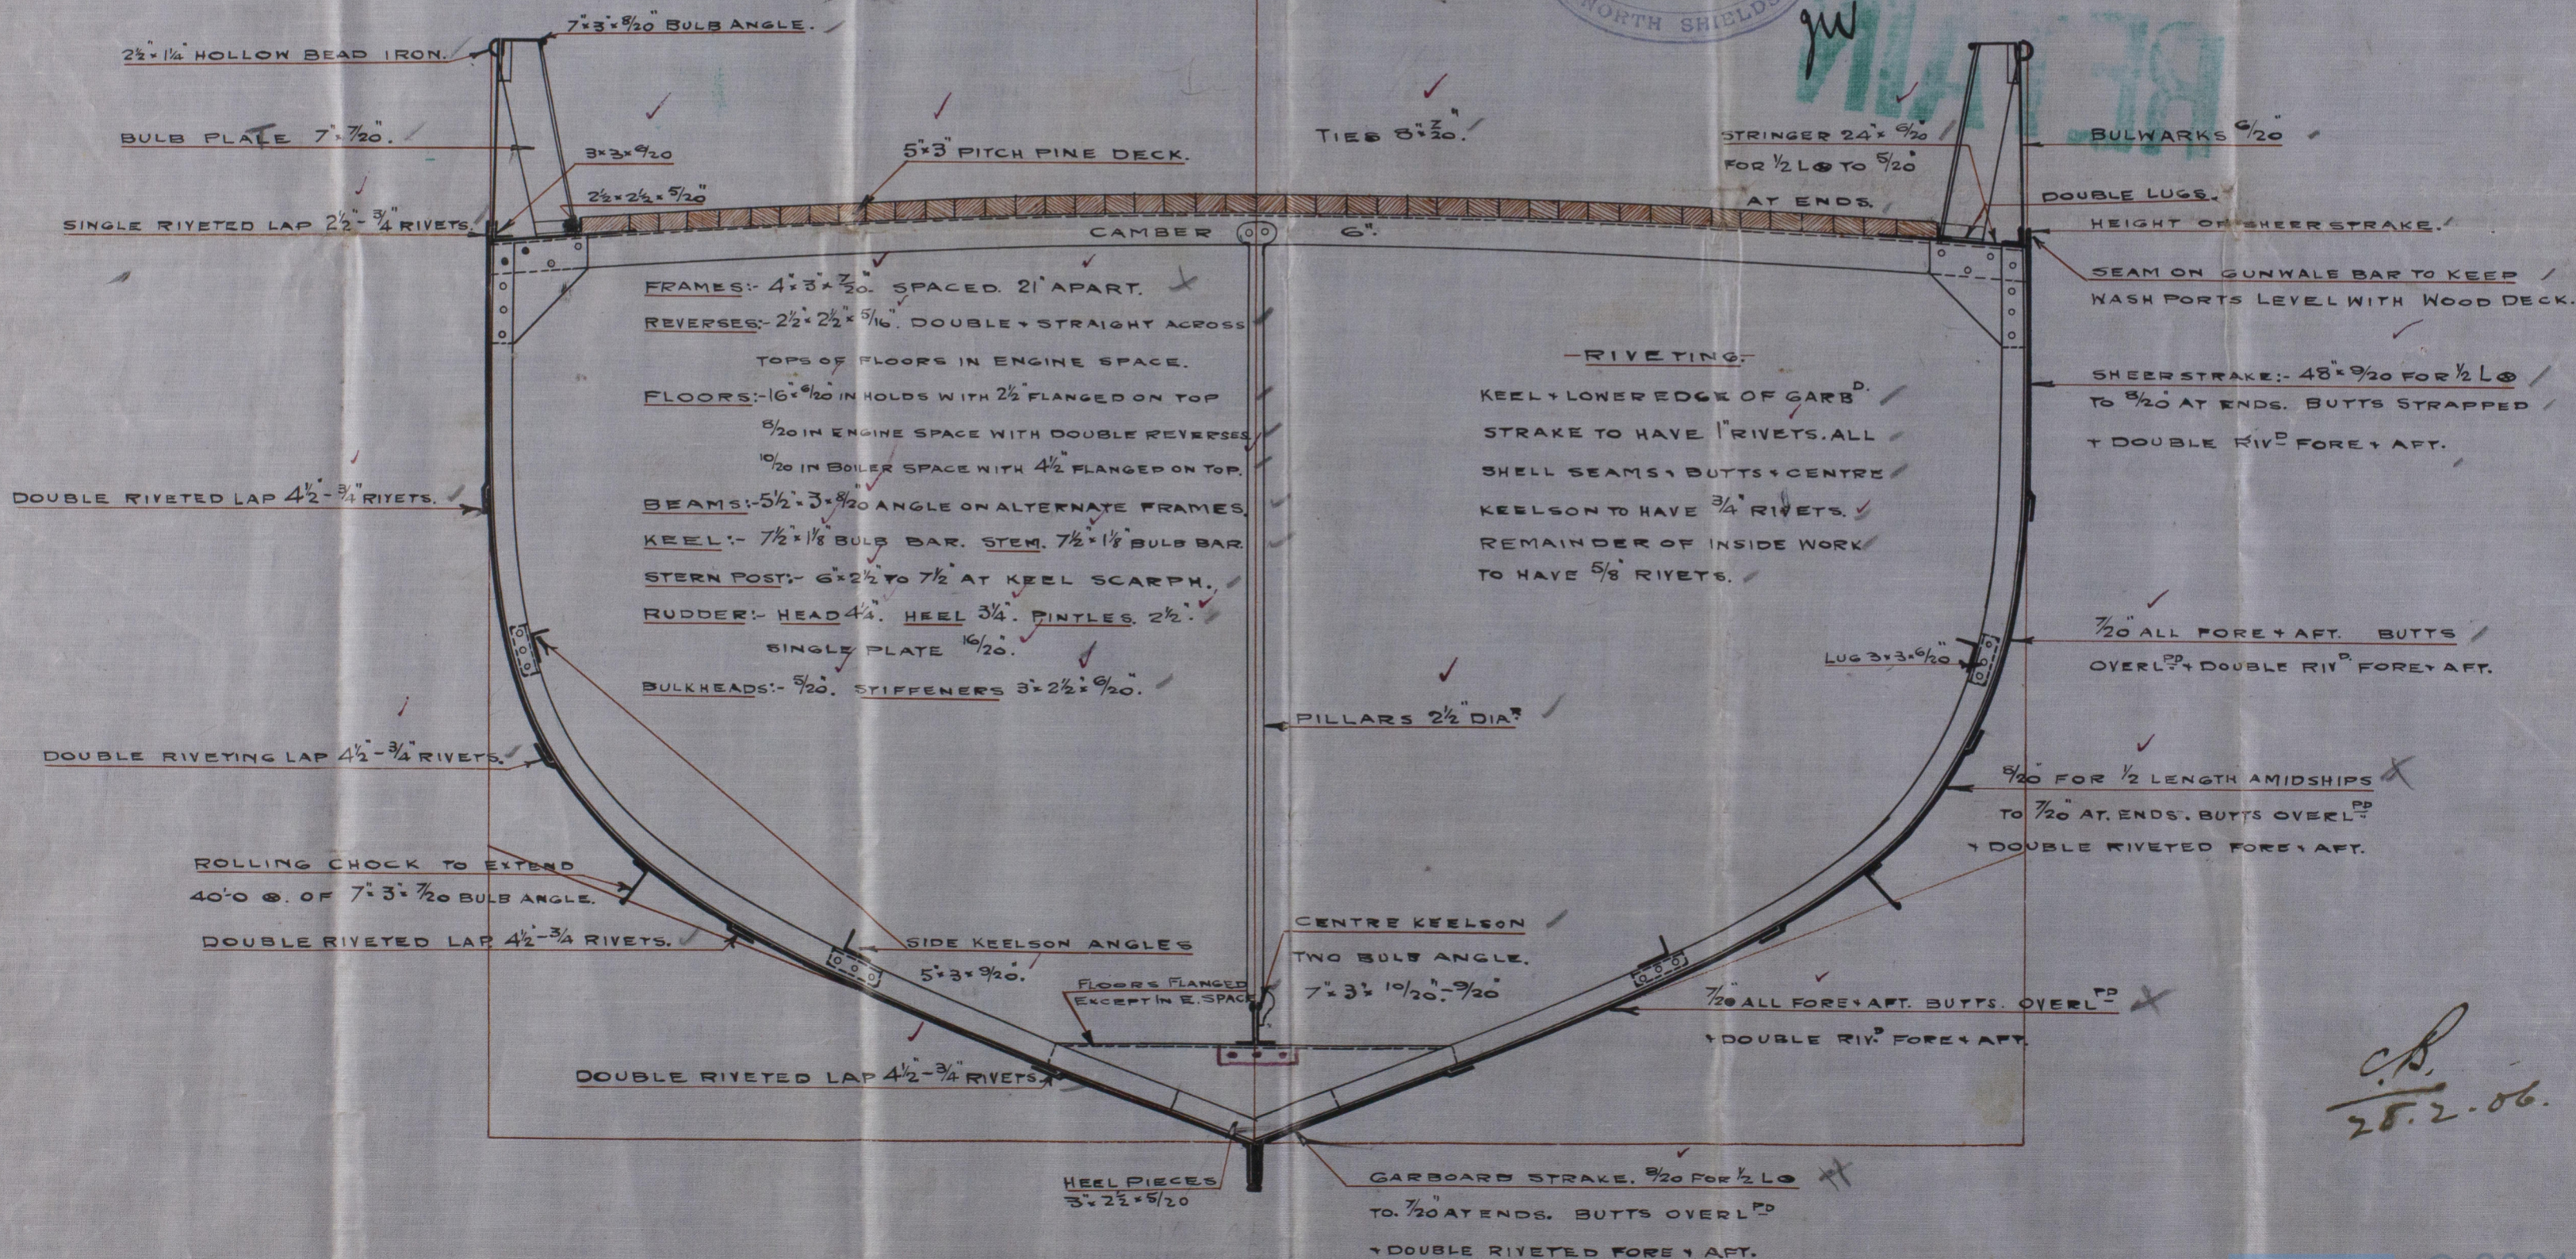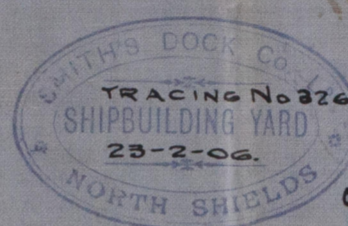

C.B.
28.2.06.




© 2021


Lloyd's Register
Foundation

W1275-0272

SMITHS DOCK CO
N^os 798, 99 & 800
MIDSHIP SECTION

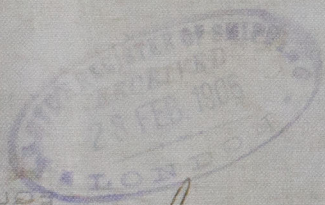

D. 122

S.I. India 

Newcastle Report

N^o 51.734

s/s Persia

New Rpt. N^o 51.870

s/s Arabia

New Rpt N^o 51.8891.

*File with Tr. 'Christie's'
(ex India)*



© 2021

Lloyd's Register
Foundation

W1275-0272