


Screw Shaft - T.S.S. "Bahia Blanca"

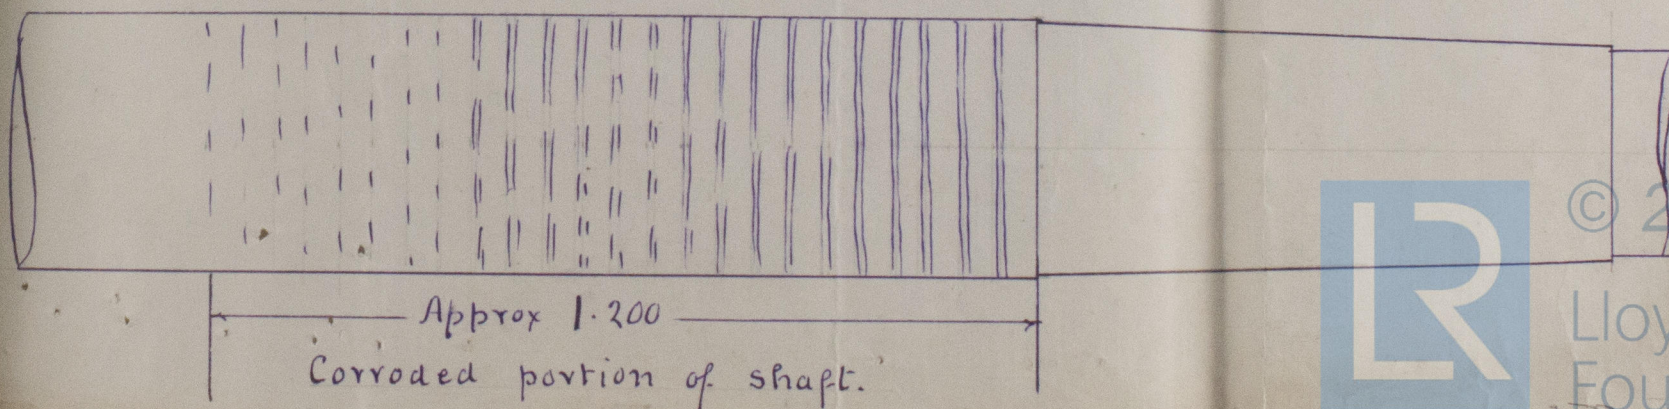

© 2020

Lloyd's Register Foundation

W122-0088