

For the information of Surveyors and the Committee only.

Received at

Office

19

Lloyd's Register of Shipping.

(Report on Vessel No. 43930

Port

Hull

Alabama

No.

SHIP FORGINGS OR CASTINGS.

I have to report that the undermentioned Iron or Steel Forgings or Castings, manufactured by Messrs J. S. Forster & Son Ltd. of Sunderland for the Vessel No. 1114, being built by Messrs Buchanan & Son Ltd. of Selby have been inspected by me as set forth below and found to be, so far as can be seen, Sound.

In Forgings or Castings.

Lloyd's


No. 6799

10 28.3.33

J. Dale
Sunderland

	STERN FRAME.	RUDDER FRAME.	STEM.
Material	Scrap iron		
Made	Forged & Smithed		
Size	5 1/2 x 2		
Process on Inspection	Forging & Smithing		
When Inspected	28.3.33		
CASTINGS.			
Tests on Standard Test Pieces.			
Tensile Test—			
Stress per square inch			
Elongation per cent.			
Bending Test—			
Deflection before fracture			
Impact Test—			
Height from ground			
Hardening Test—			
Made according to Rules and found satisfactory			

SKETCHES OF FRAMES SHOWING POSITION AND DESCRIPTION OF WELDS OF FORGINGS.

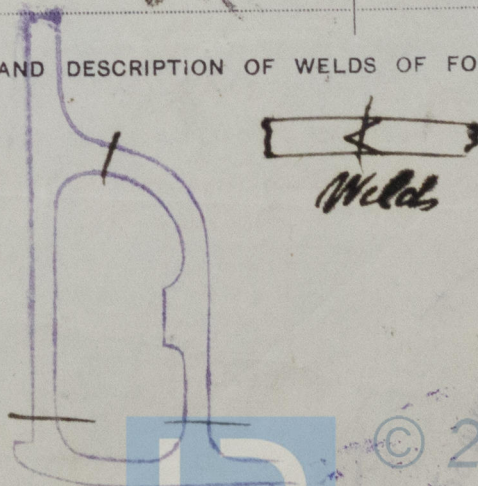

Fee (if any chargeable) £

To be paid at

If of Iron, state whether scrap or puddled Iron. If of Steel, state whether made on the Open Hearth process.

20. T.













© 2020

Lloyd's Register Foundation

The words FORGINGS or CASTINGS should be struck out as may be required.