






M.V. "KANAN MARU".

Nagasaki Report No.1789.

CONSTRUCTION  
PROFILE & D<sup>K</sup> PLAN.  
SCALE  $\frac{1}{6}$  INCH TO 1 FOOT.  
(335'-0" x 48'-6" x 24'-0")  
(FINISHED PLAN.)

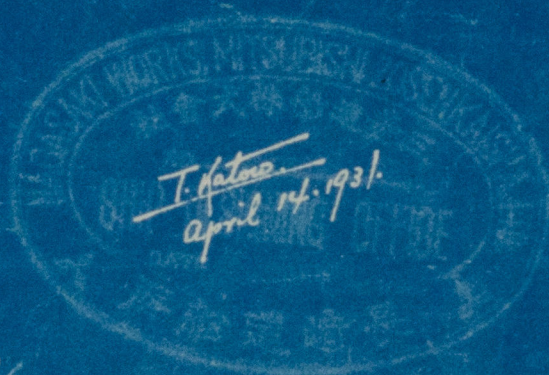


W1278-0154



RETAIN



Lloyd's Register  
Foundation

W1278-0154