


N^o 764. - *des. for No. 765-6 (as built 11/17/12)*
LONGITUDINAL SECTION & DECK PLANS OF STEAMER.
FOR CARRYING PETROLEUM IN BULK.


SCALE 1" = 1 FOOT.

FREEBOARD PARTICULARS
SHEER FORWARD 1/4" AT ENDS
AFT 1/4" AT ENDS
FORWARD 1/4" AT 1/2 LENGTH
AFT 1/4" AT 1/2 LENGTH
COEF. OF UNDER DECK TONNAGE .79
UNDER DECK TONNAGE 2800

 

Palmer's S. C. Gd.
S.P. No 765

Profile & deck plans.

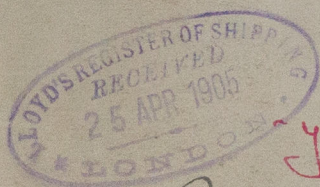

Yusepan

From the no

hwc. 48737.

W128-0089



© 2019

Lloyd's Register
Foundation