


THIS SKETCH TO BE A FLY SHEET TO MIDSHIP
SECTION OF N^o 764 NOW ALSO MARKED N^{os} 765 & 6

Lloyd's Camp
13.1.02.

PROPOSED MODIFICATION
OF BOTTOM FRAMING

N^{os} 765 & 6

$\frac{1}{2}$ INCH SCALE

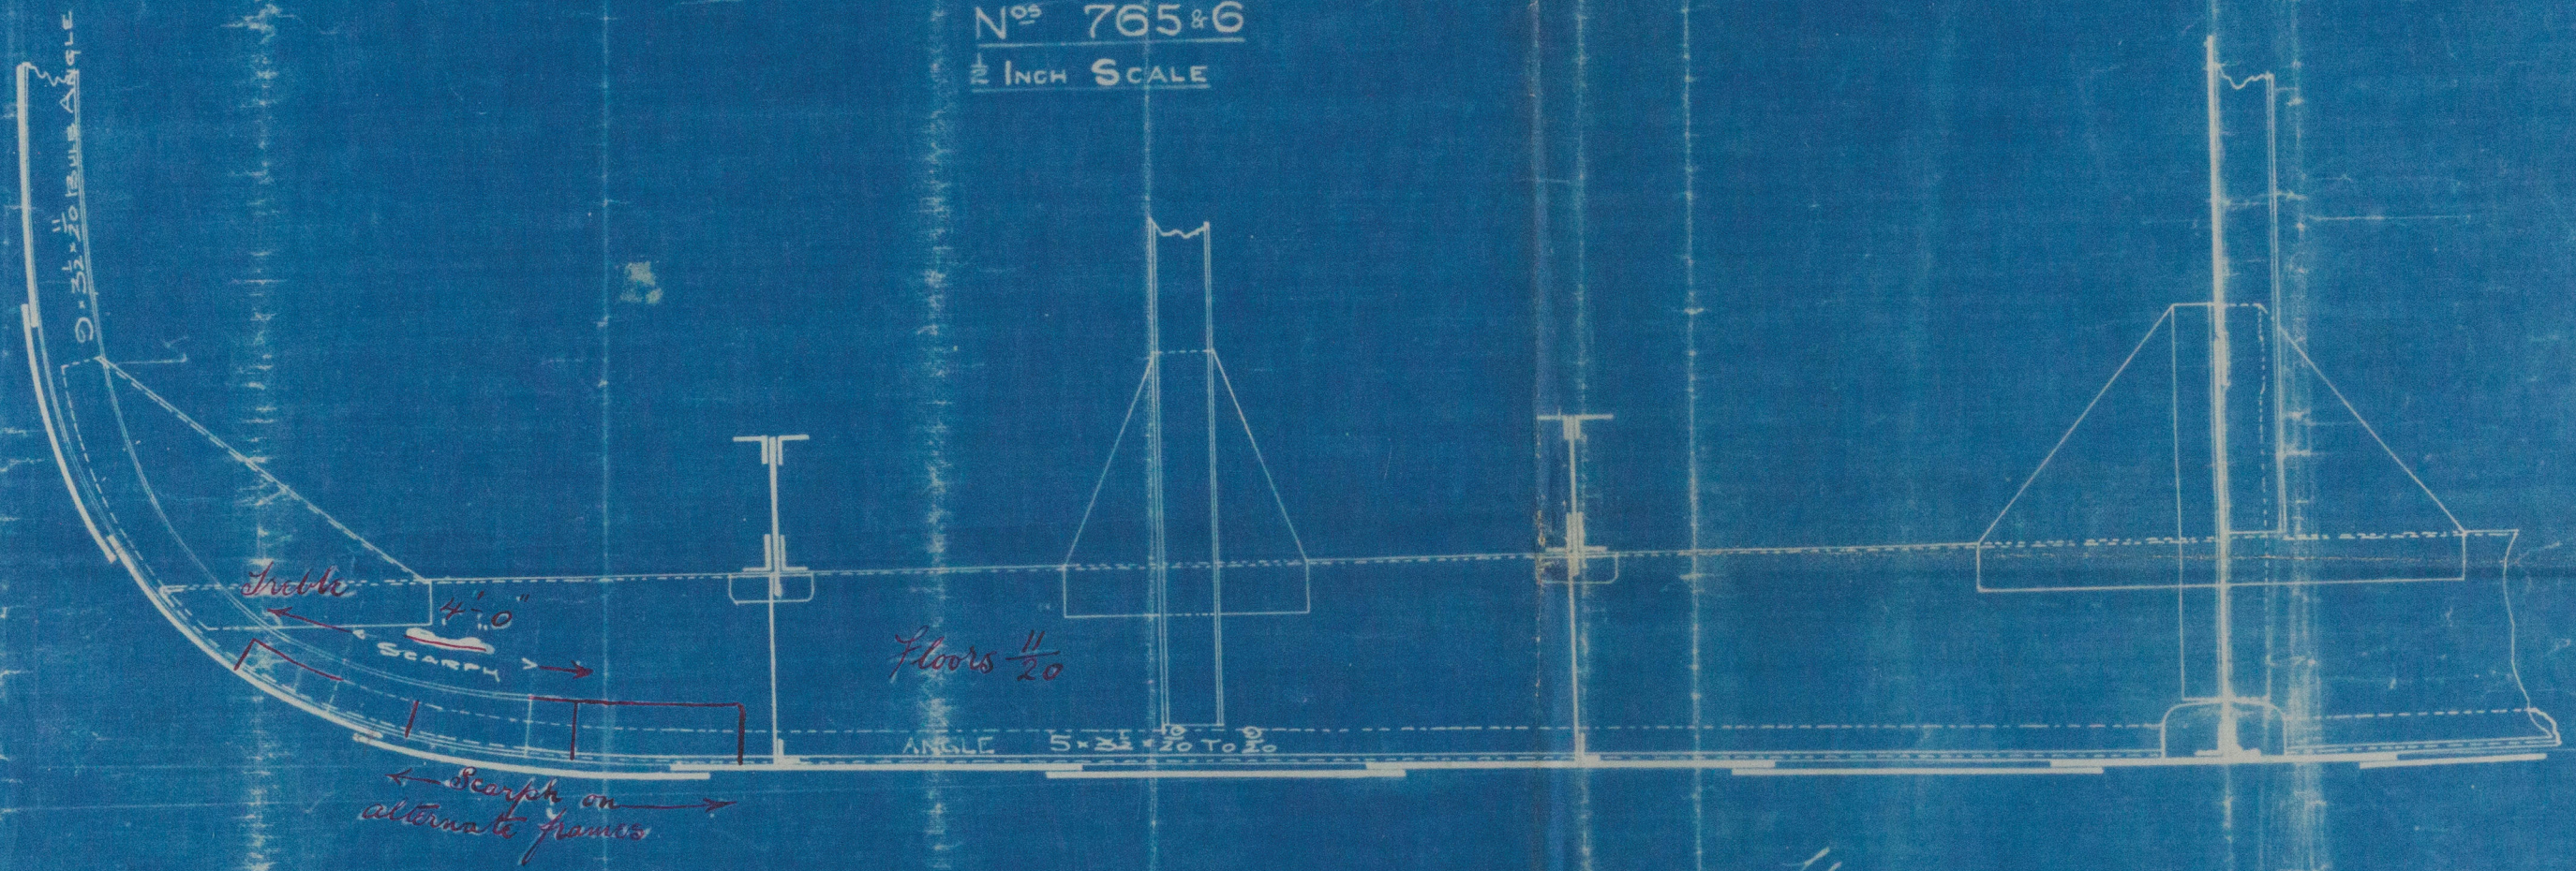

approved by Lloyd's
11/1/02



© 2013

Lloyd's Register
Foundation

1600-8914

3rd Deck 1/20 In range of Oil Tanks Seams & Butts
Double riveted Clear of Oil Space 1/20 Seams & Butts

43703 266-9 3852
6 426-0 53561 Equipment No.

- Prometheus

W128-0094



© 2019

Lloyd's Register
Foundation