


Wallsend Shipway & Eng Co 777
Amended plan of main boilers
220 lbs.

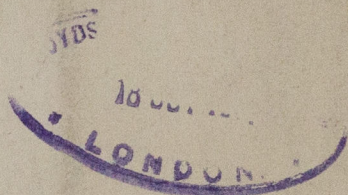

S.S. "SAN FLORENTINO"

NEWCASTLE ON TYNE.

Report No. 71799



W1128-0121



© 2019

Lloyd's Register
Foundation