

10.6.15
3.8.15
10.7.15
4.9.15
12/11/15
21.3.16


Boat - Deck.

S.S. to carry oil in bulk.


326'-10" x 48'-6" x 27'-0".

Class 100 AI & Lloyd's.


Scale 1/8" = 1 Foot.

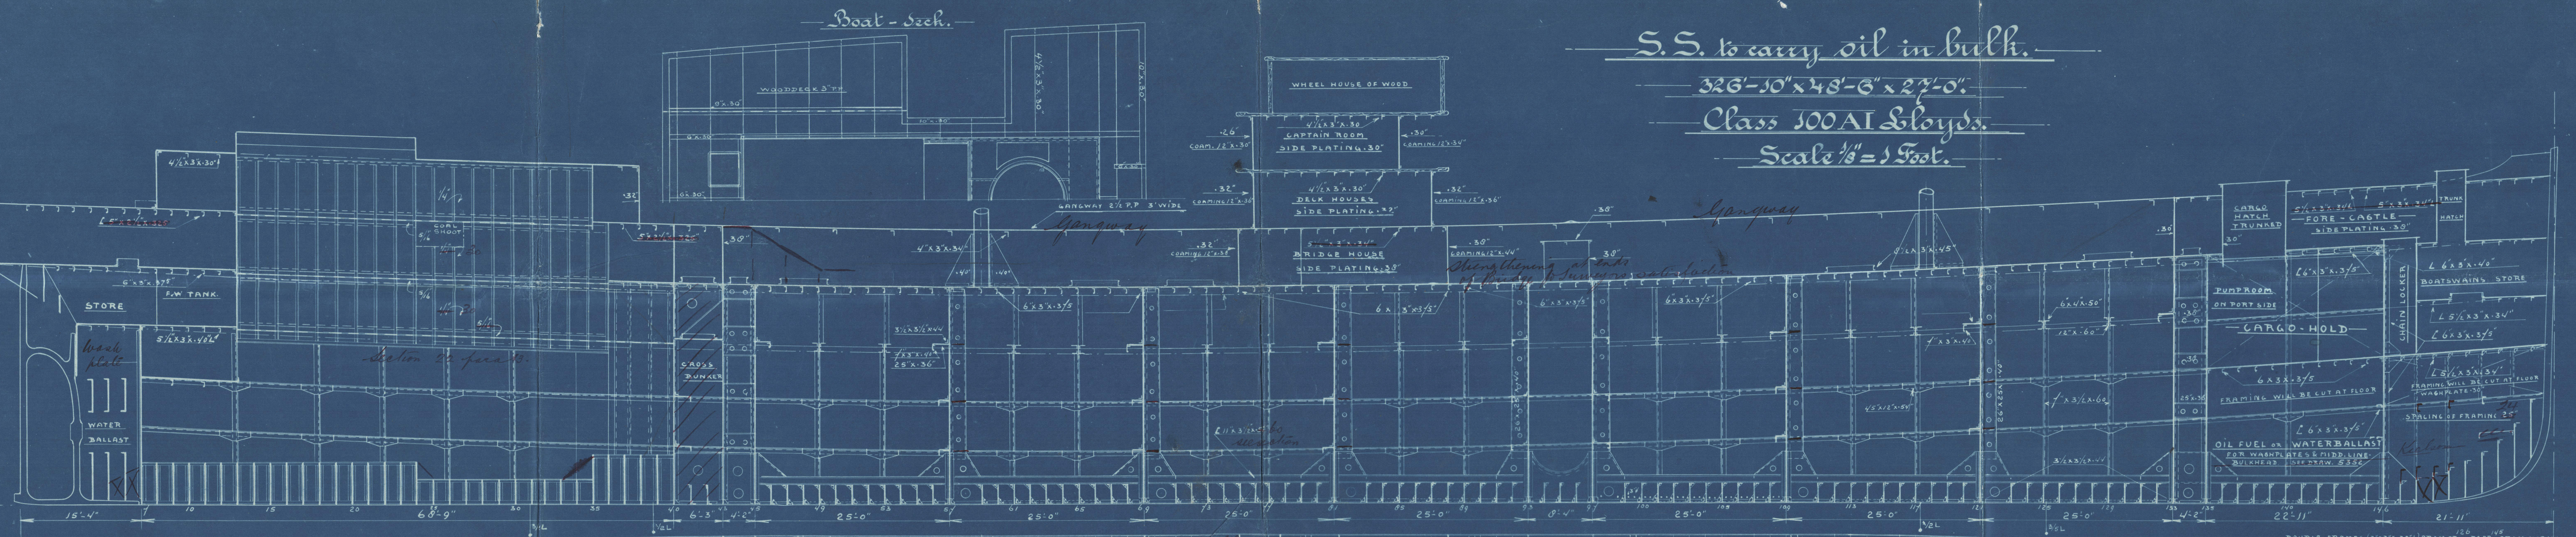

Upper Deck.

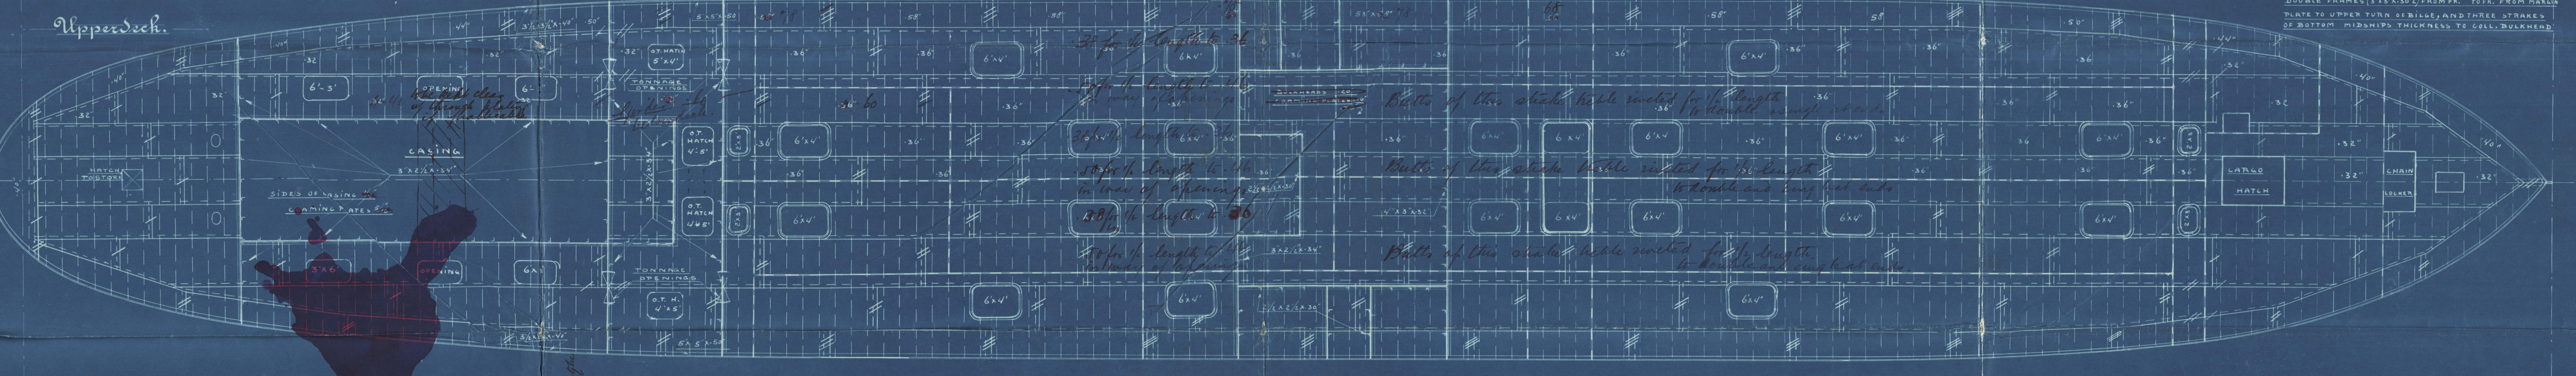


Section below Main Deck.

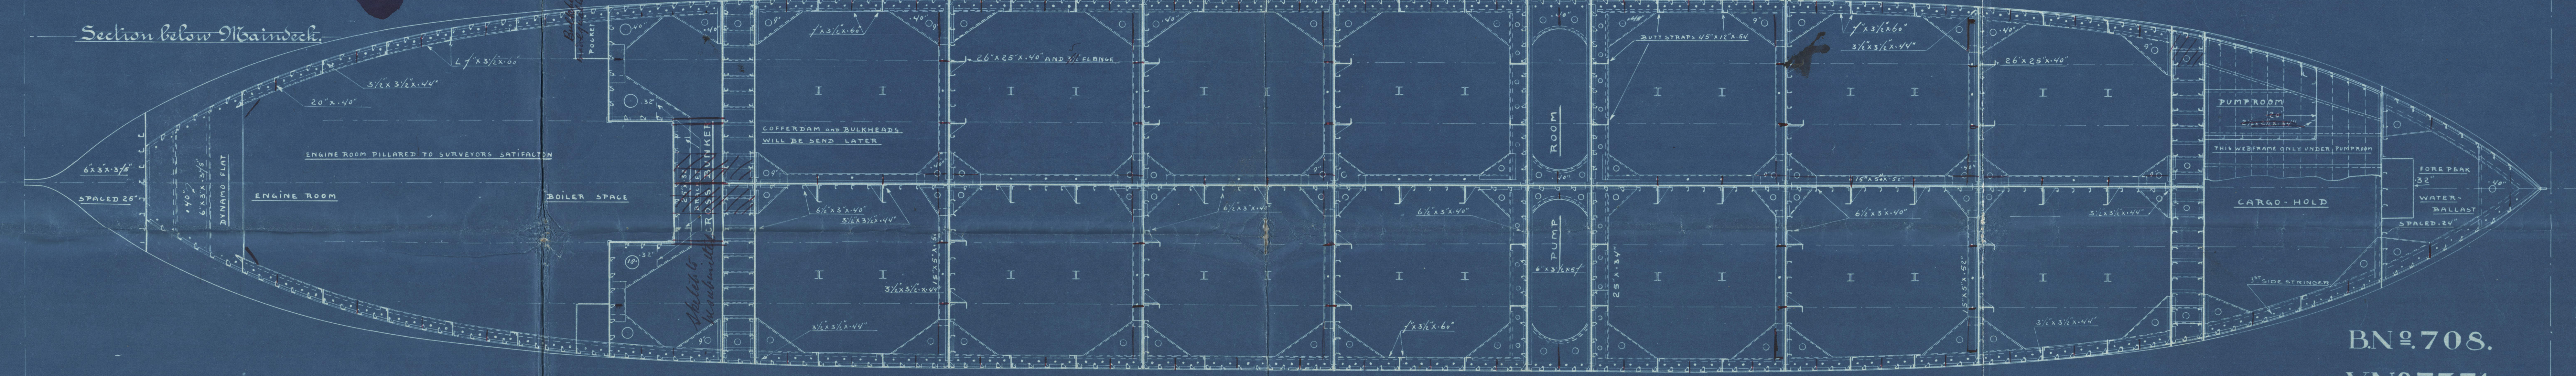


Main Deck.




Poop Deck.

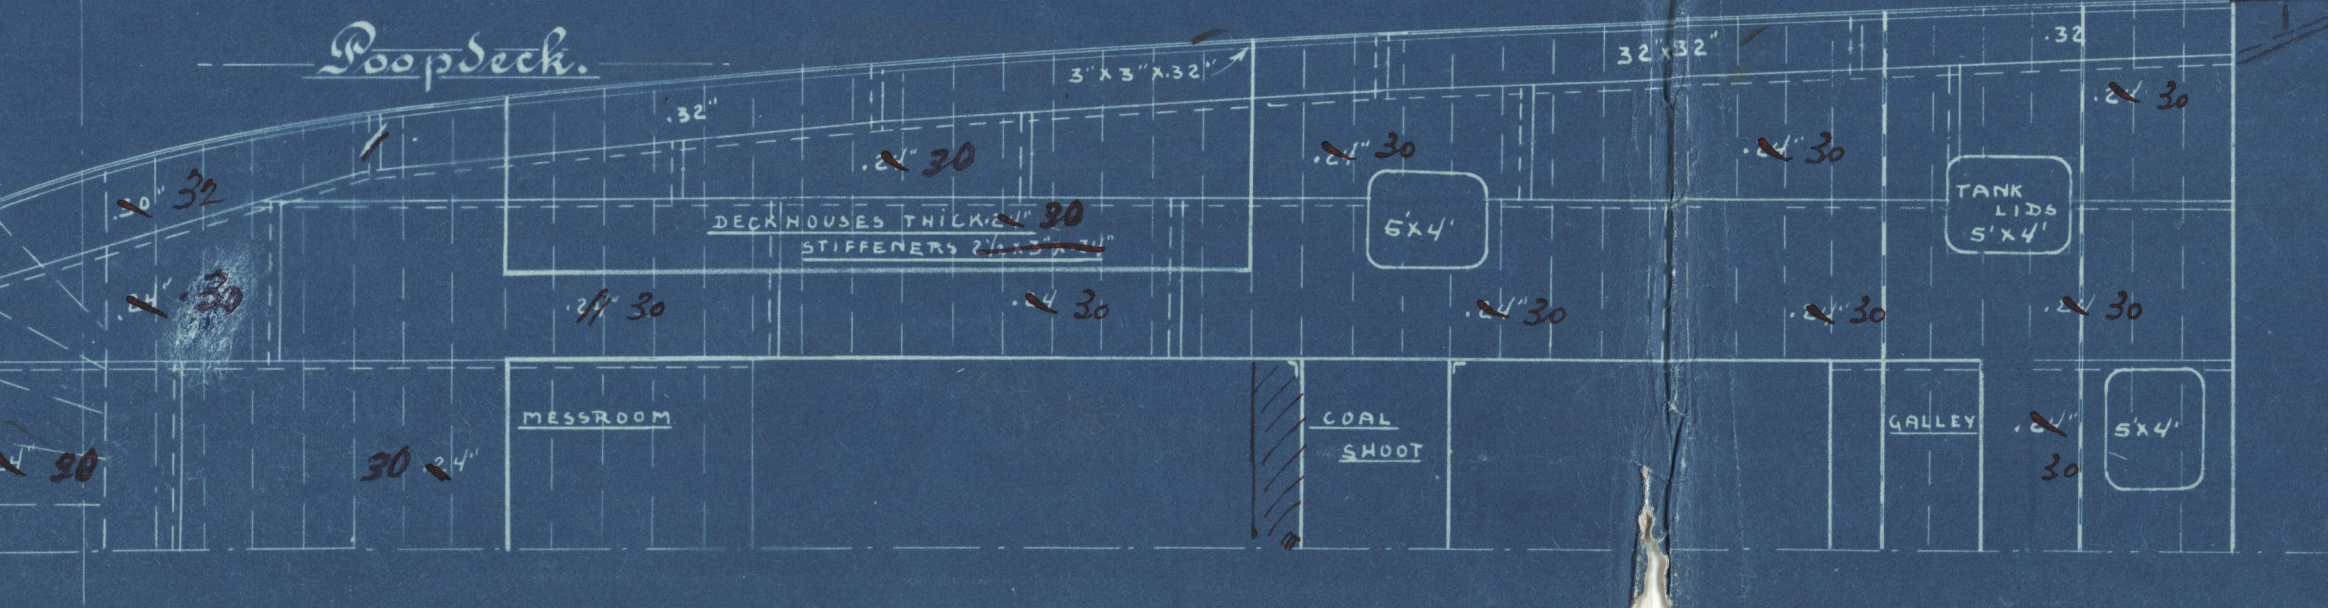

Bridge Deck.

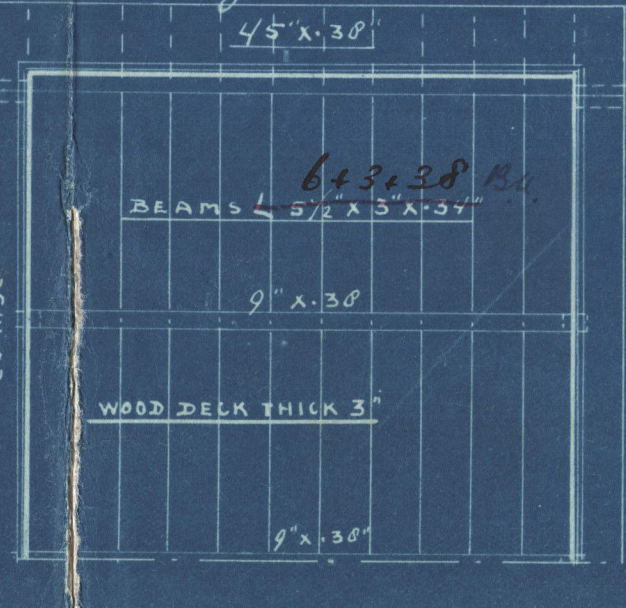


Forecastle Deck.

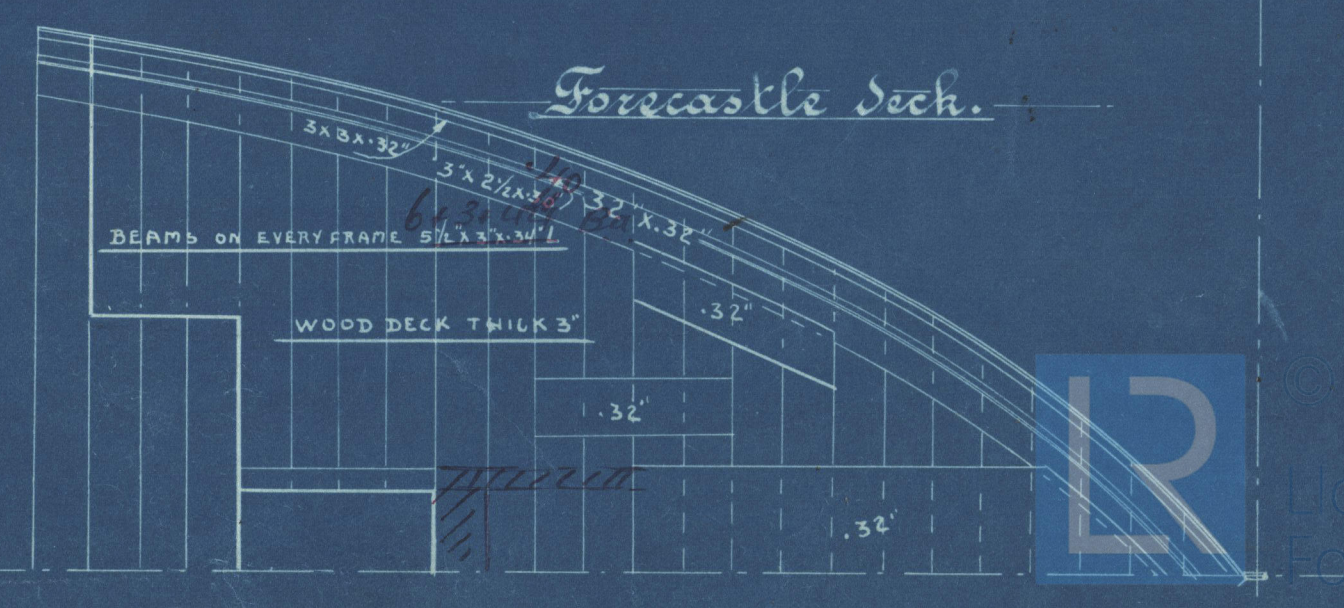


BN 708.

VN 5351.

20-5-1915.

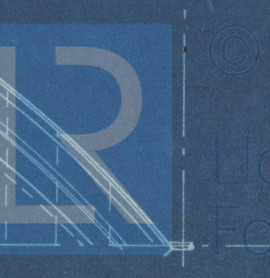



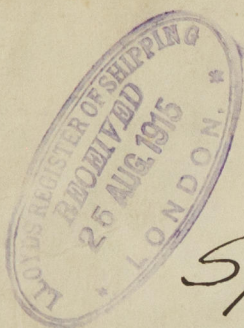


S/S Iris

Profile and Decks.

Rotterdam

Report 10710^a

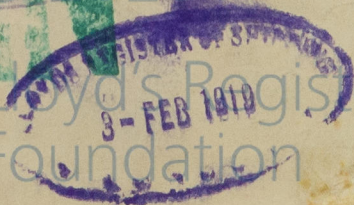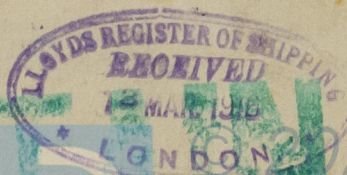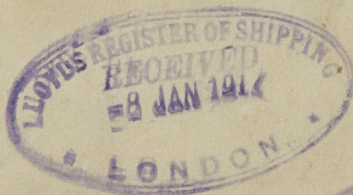

W1280-0040

Lloyd's Register
Foundation