

# M. S. SANSEI MARU.

## MIDSHIP SECTION.

SCALE 1/2 IN. TO ONE FT.

TO CLASS TEISHINSHO RULE 1ST. CLASS VESSEL

& LLOYD'S 100 A. I.

NOTE :

BULB ANGLES TO BE 1927 GERMAN STANDARD SECTION

PRINCIPAL	DIMENSIONS
LENGTH BETWEEN P. P.	335'-0"
BREADTH MOULDED	48'-6"
DEPTH	TO UPPER DK. 24'-0.57"
	BRIDGE DK. 31'-9.57"
HEIGHT BETWEEN UPPER & 2ND DKS.	7'-6"
	& BR. 7'-9"
	& POOP. FCL. DKS. 7'-6"
OF DECK HOUSE	7'-6"

### SCANTLING NUMERAL

L	335.0 (336.25)	7 DIA. AT FR. SPACE 27"
B	48.5 ( )	DECK PLATING TO BEAM
D	24.05 ( )	UPPER DK. 7/8 RIV. 3/4 DIA. AT ENDS 7 D APART. 6 D FOR ALT. FR. BEAM
1ST. LONGITUDINAL NUMERAL	8057. ( )	2ND. 5/8 DIA. APART THROUGHOUT
2ND.	24304. ( )	BRIDGE 3/4 DIA.
1/2 TO UPPER DK.	13.92 ( )	INNER BOTTOM TO REV. FR.
BR.	10.53 ( )	RIV. 3/4 DIA. THROUGHOUT. SPACED 7 DIA. APART
d	21'-6"	EXCEPT IN MOTOR RM. WHERE 7/8 RIV. 6 DIA. APART

### EQUIPMENT NUMERAL




2ND LONG. NUMERAL	24.304.0 (24394.44)
BRIDGE	80.0 x 7.75 x 3/4
POOP & FCL.	31.5 x 30.5 x 7.5 x 3/4
DECK HOUSE	47.5 x 22.5 x 22.5 x 7.5 x 1/2
EQUIPMENT	25.464.9 (25561.14)
1-BOWER ANCHOR (STOCKLESS)	32 CWT. 1 QUB. 1 LBS.
1- " " " " " "	52 " " " " " "
1- " " " " " "	44 " " " " " "
STREAM	(COMMON) 12 " 1 " 20 "
270 FATHOMS	2" STUD CHAIN CABLE
40	4/2 STEEL WIRE FOR STREAM ANCHOR
120	4 " " " " " " " " " " " "
4 COILS OF 90 FATHOMS OF 7" MANILA FOR HAWSER & WARP	

### FORGING & CASTING :-

STEM	12" x 2 1/2" FORGED STEEL, LOWER PARTS CAST STEEL
STERN POST	CAST STEEL AS PER PLAN
RUDDER POST	" " " " " " " " " " " "
RUDDER STOCK	FORGED STEEL
RUDDER	OERTZ RUDDER
STRINGER PL.	51" x 80" - 36" x 38"
	1-20" AT BRIDGE ENDS
	36" IN
STRINGER & SHELL ANG.	160 x 160 x 22 - 90 x 90 x 10

### ROWS IN BUTTS

BRIDGE DK. STRINGER PL.	3	ENDS
" " PLATE	2	
UPPER DK. STRINGER PL.	4	3-2
" " PLATE	3	3-1
2ND DK. STRINGER PL.	2	
" " PLATE	1	
BRIDGE SIDE PLATE	3	
SHEER STRAKE	4	3
STRAKE BELOW SHEER STRAKE	4	3-2
SIDE PLATING	3	3-2
BOTTOM PLATING	3	3-2
INNER BOTTOM MIDDLE STRAKE	3	2
" " OTHER	2	1
MARGIN PLATE	3	3
CENTRE GIRDER	3	3
KEEL PLATE	3	3

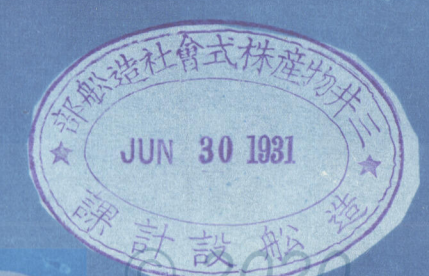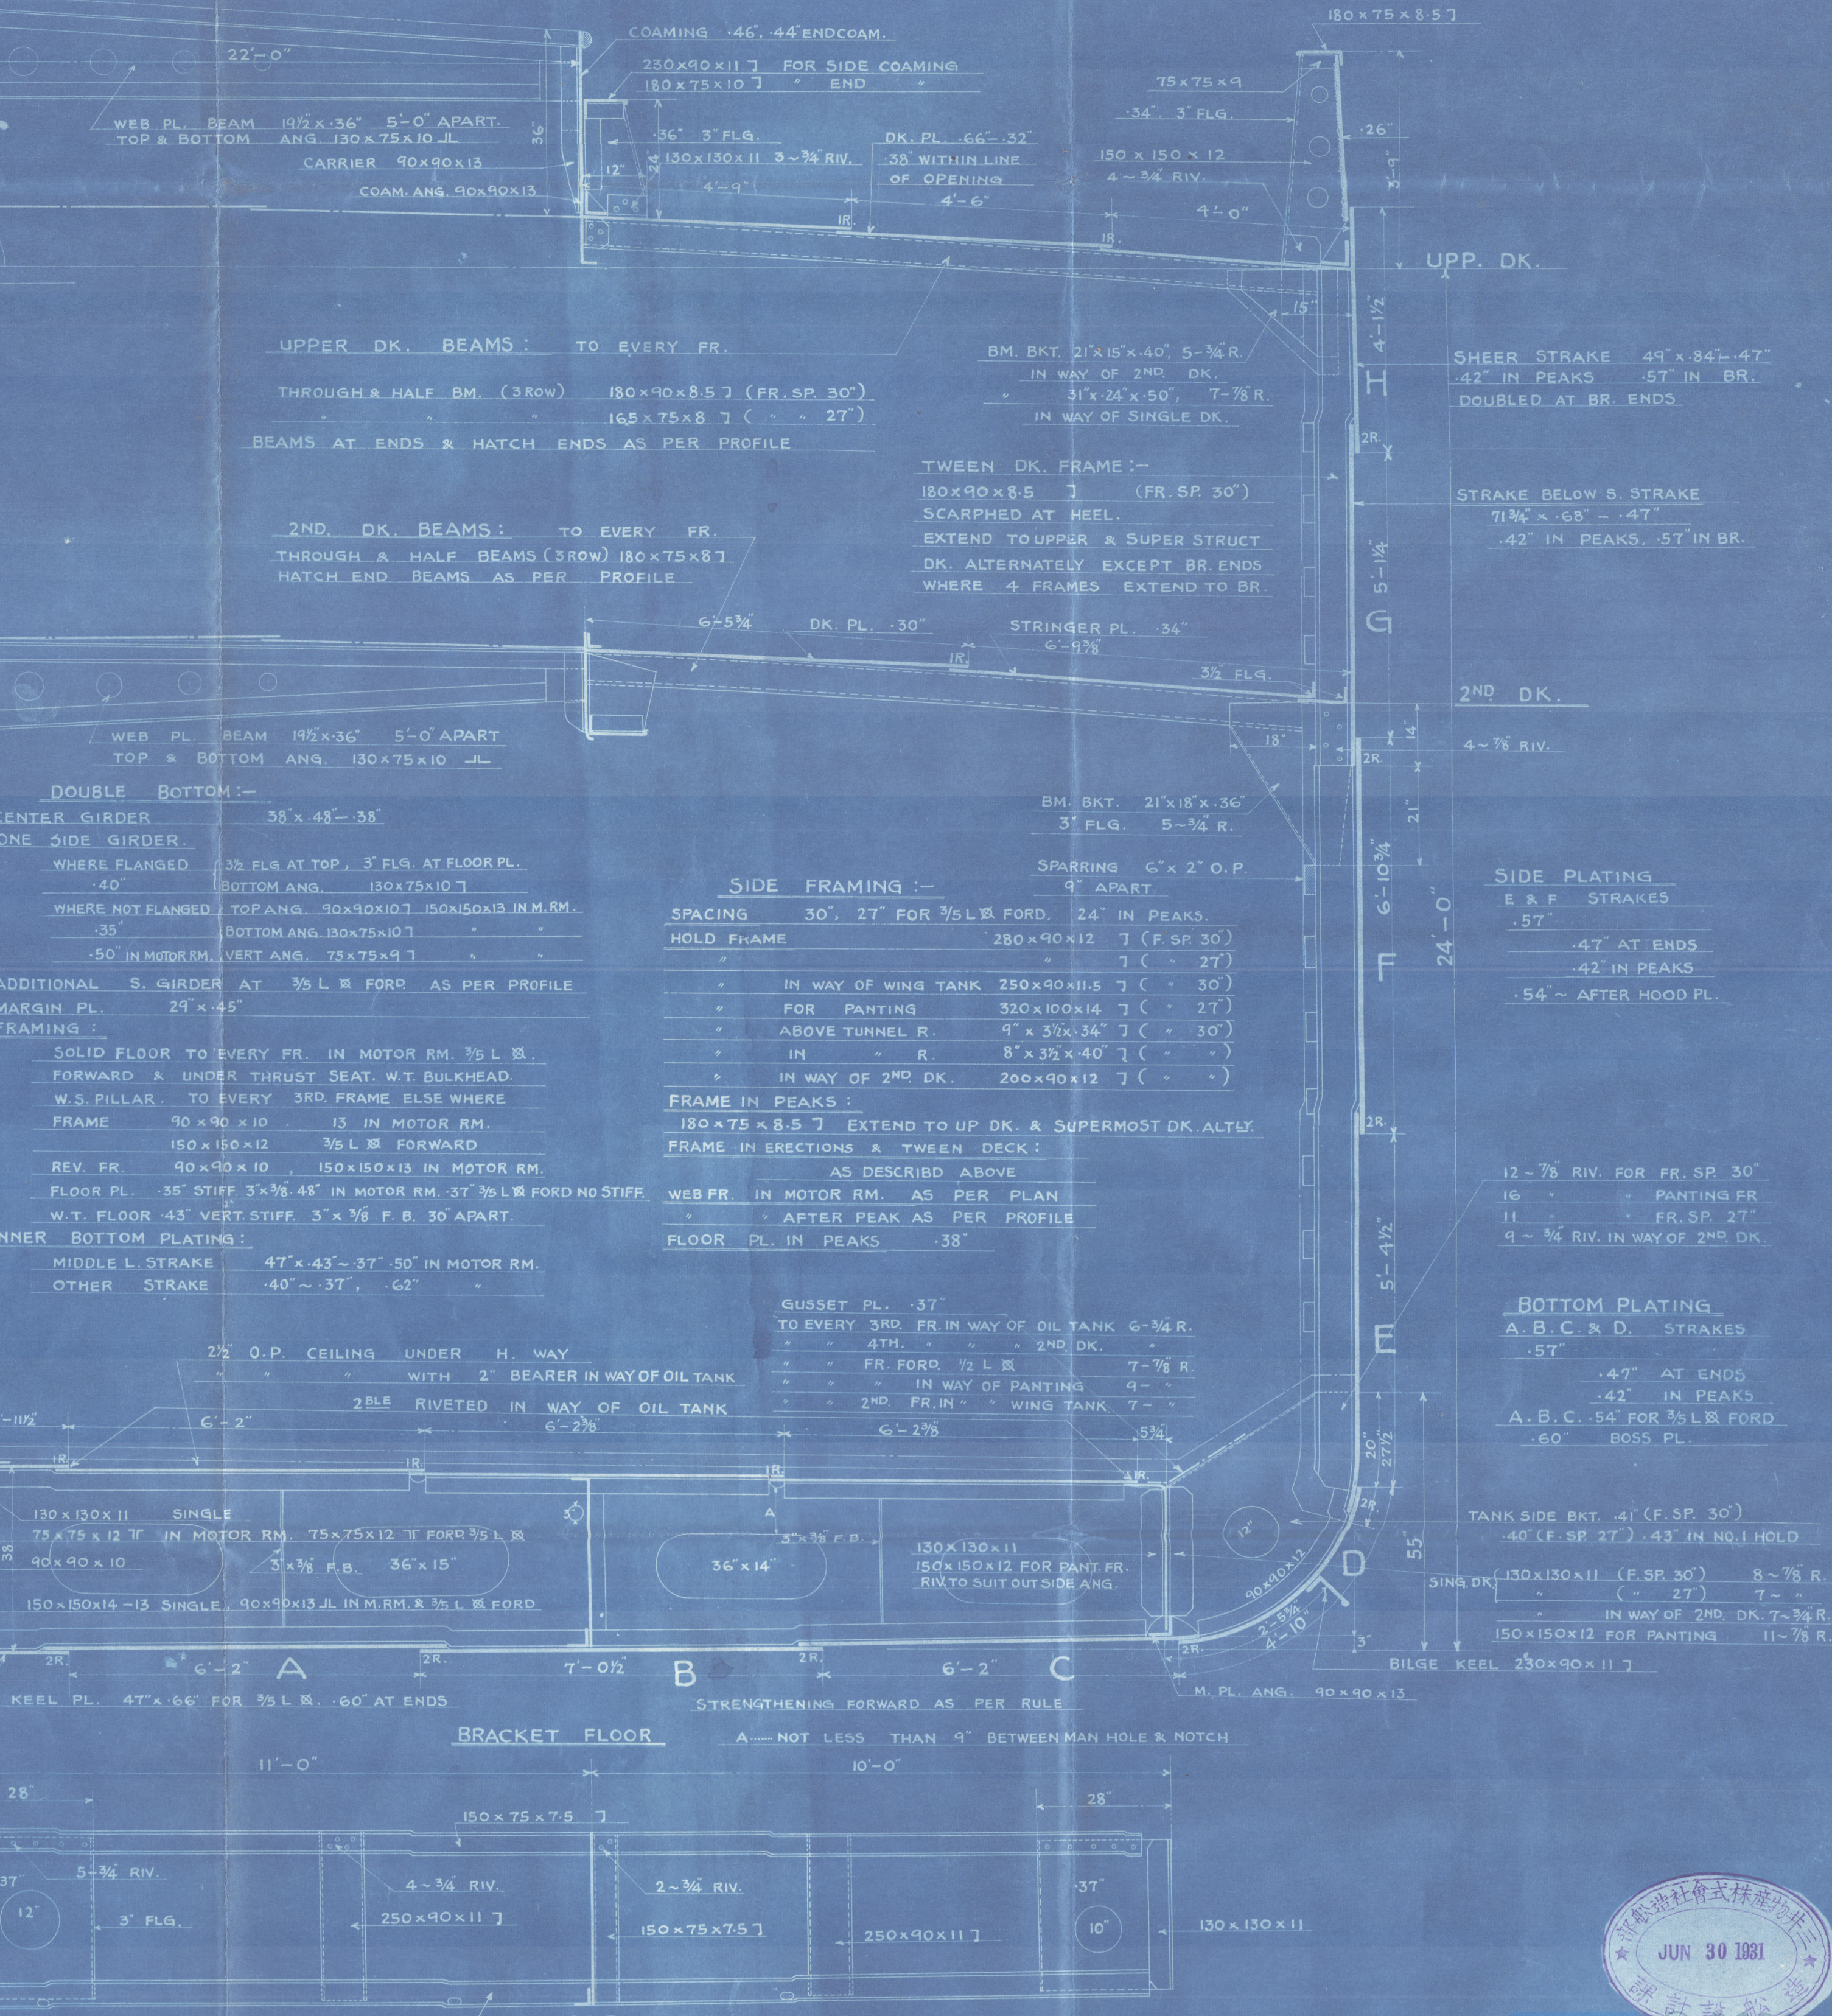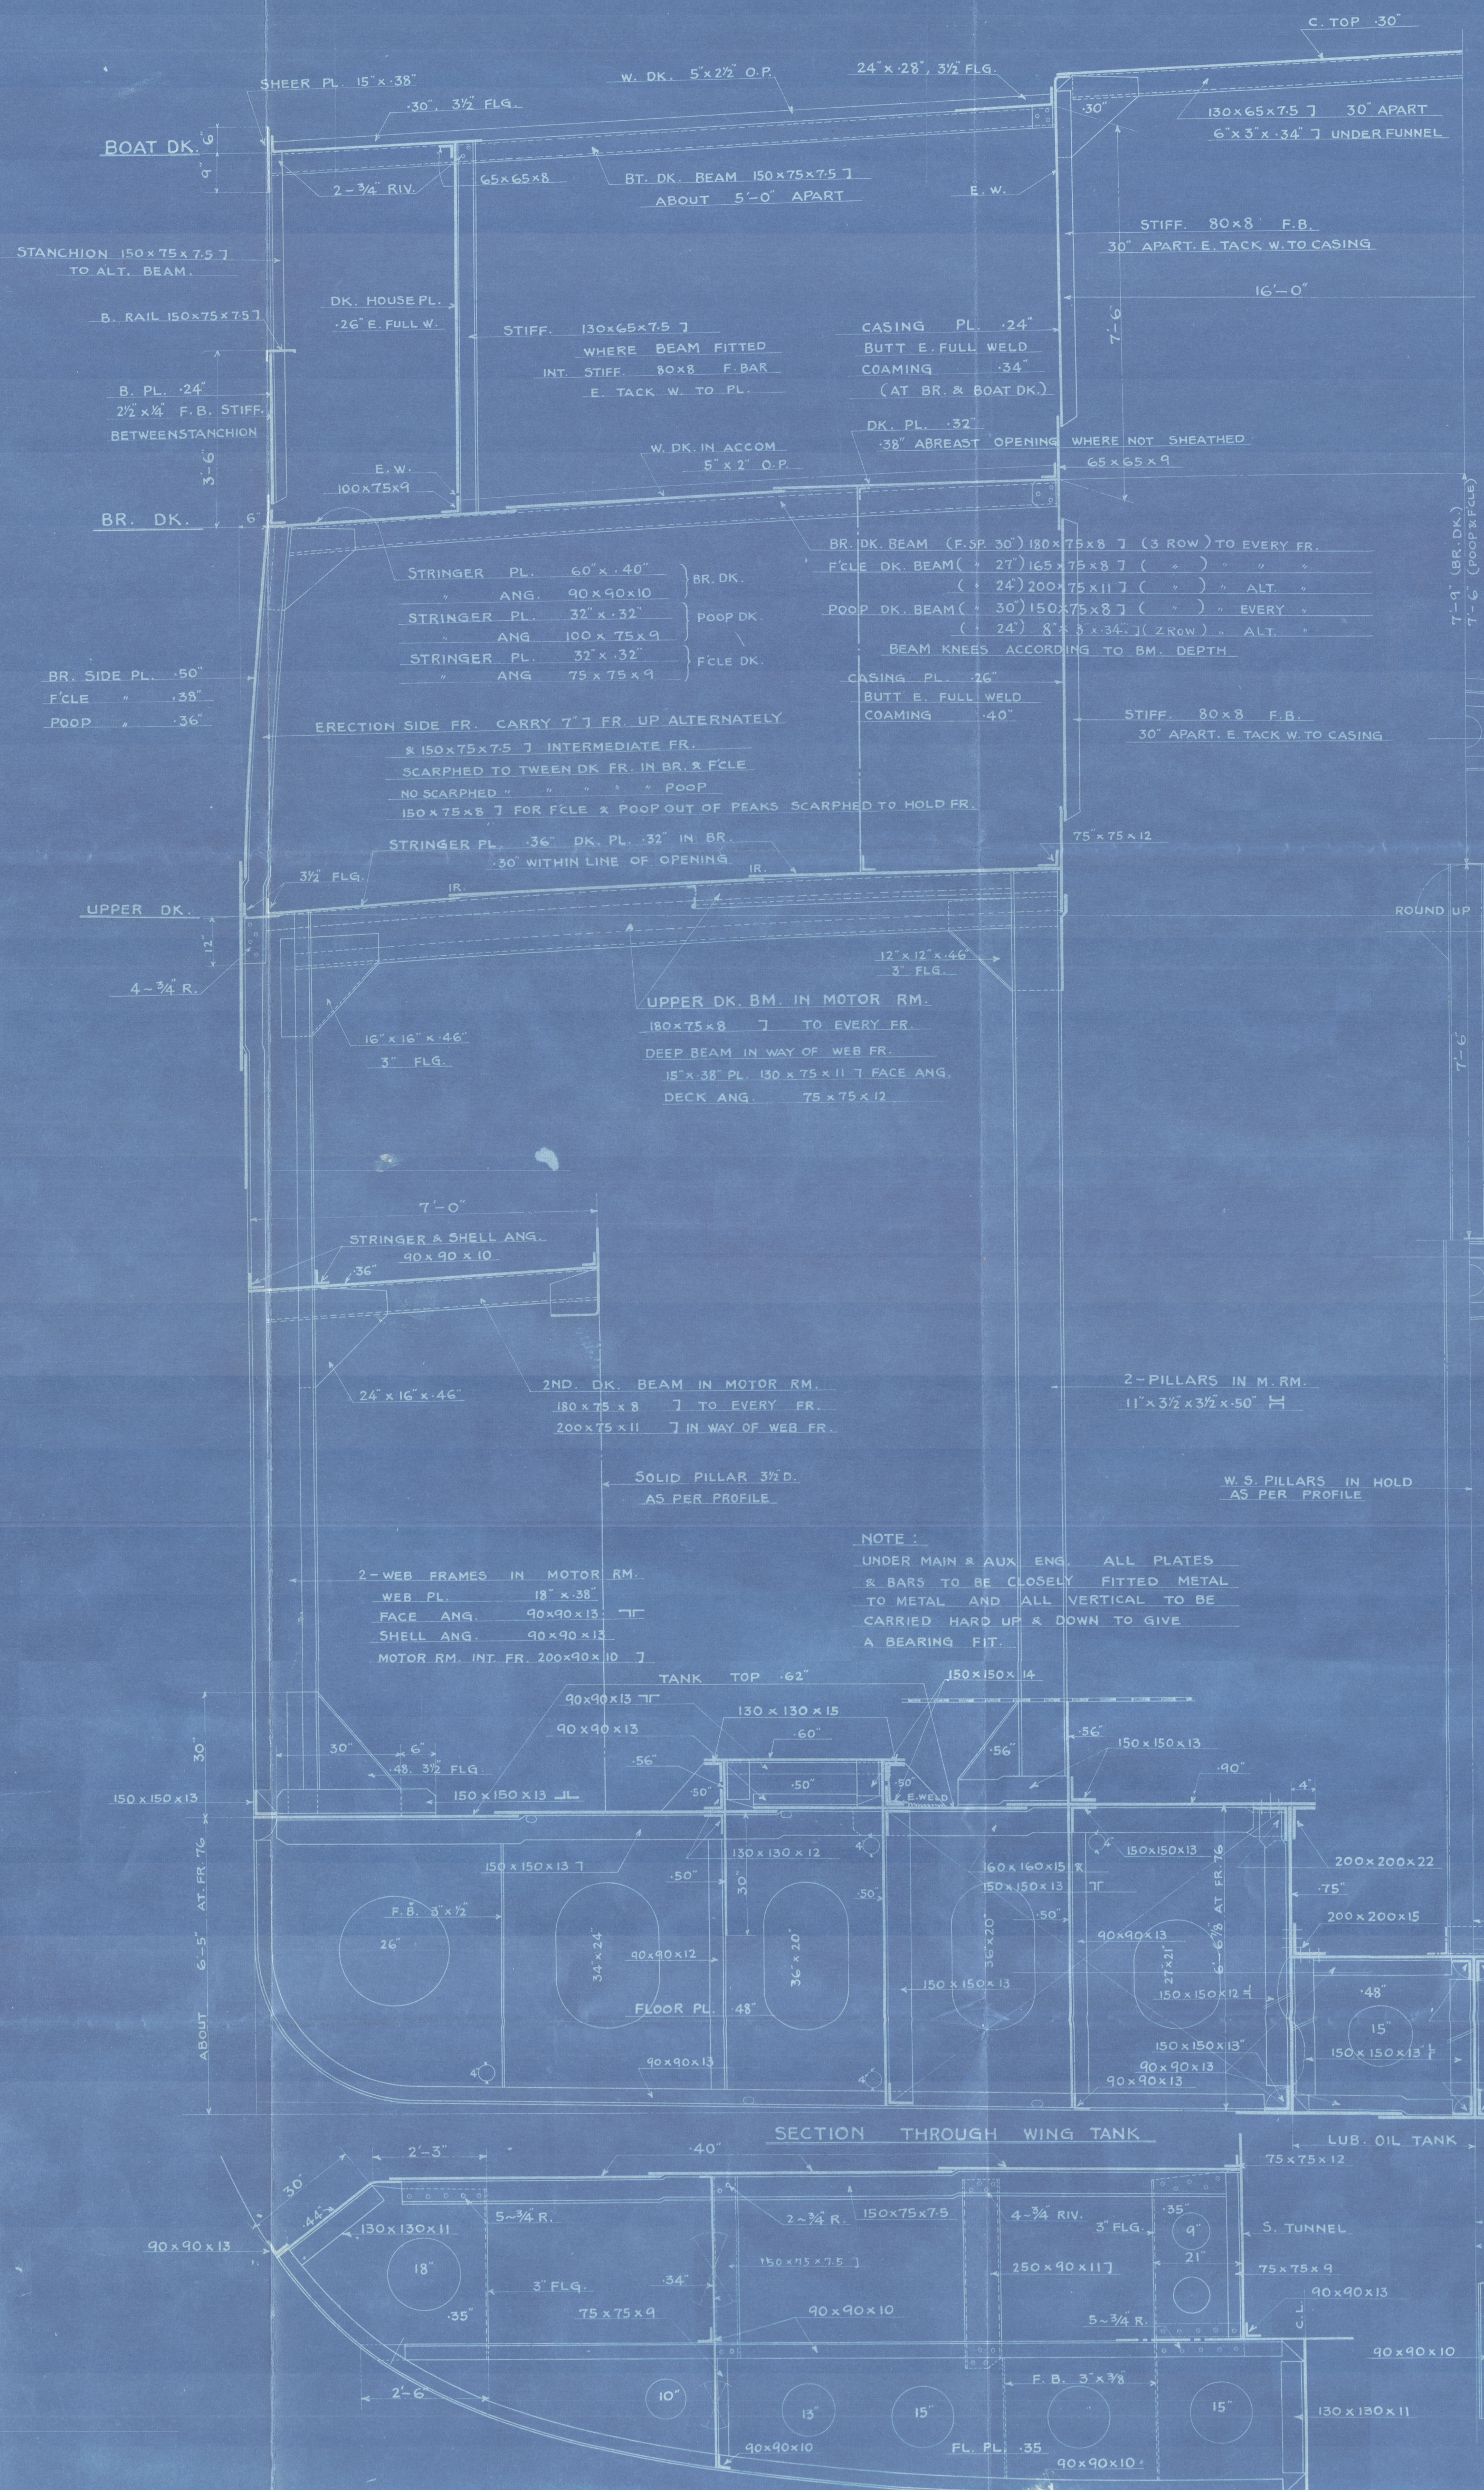

完成圖



"Sansei Maru"

No. 185 Ship

Class of Ship 山西丸

MIDSHIP SECTION.

Plan No.

32

© 2020

Lloyd's Register  
Foundation

W1282-0134