


M. S. SANSEI MARU. CONSTRUCTION PROFILE DECKS & INNER BOTTOM PLAN SCALE 1/8 IN. TO ONE FT.

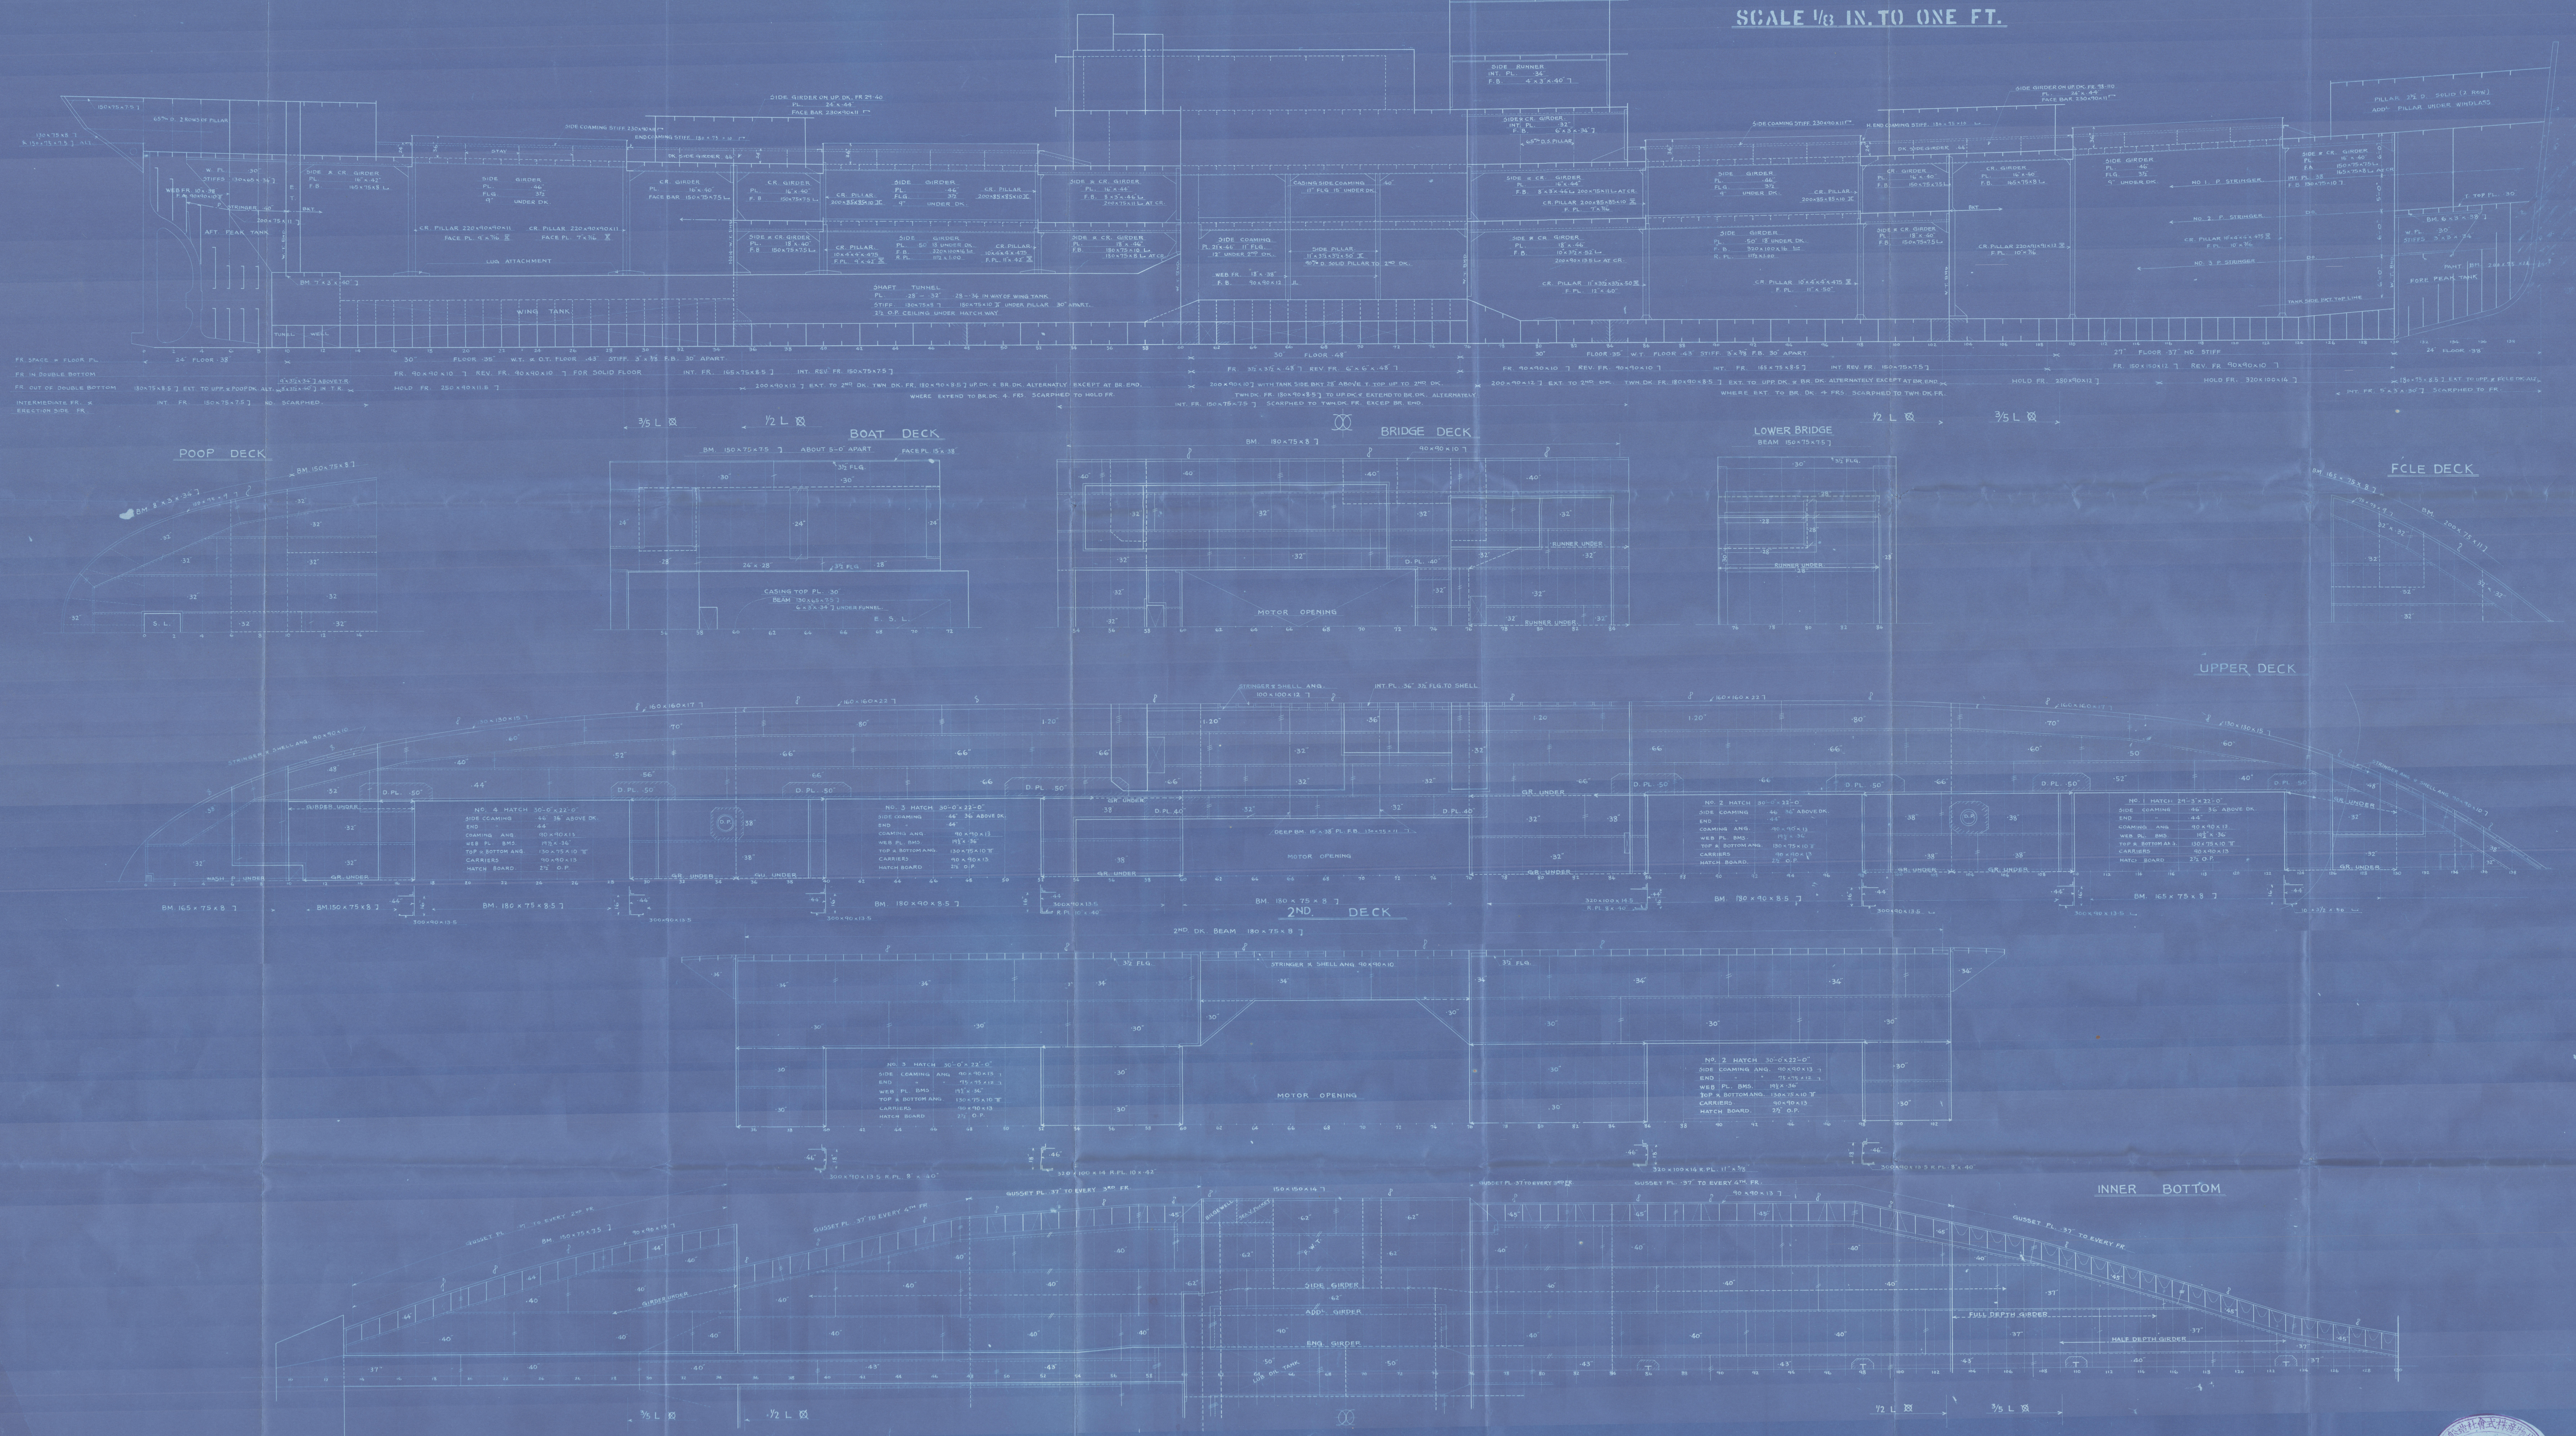

完成圖

控

"Sansui Maru"

No. 185 Ship

Class of Ship

山西丸

CONSTRUCTION PROFILE DKS.
& INNER BOTTOM PLAN

Plan No.

33

2020

Lloyd's Register
Foundation

W1282-0135