

9.12.04

— N° 492 —



— PROFILE & DECK PLAN —

— 146'8" x 22'10 1/2" MLD x 11'9 1/2" MLD. —


— TO CLASS 100 R.I. STEEL —

— FOR FISHING PURPOSES —

1/4" = ONE FOOT —

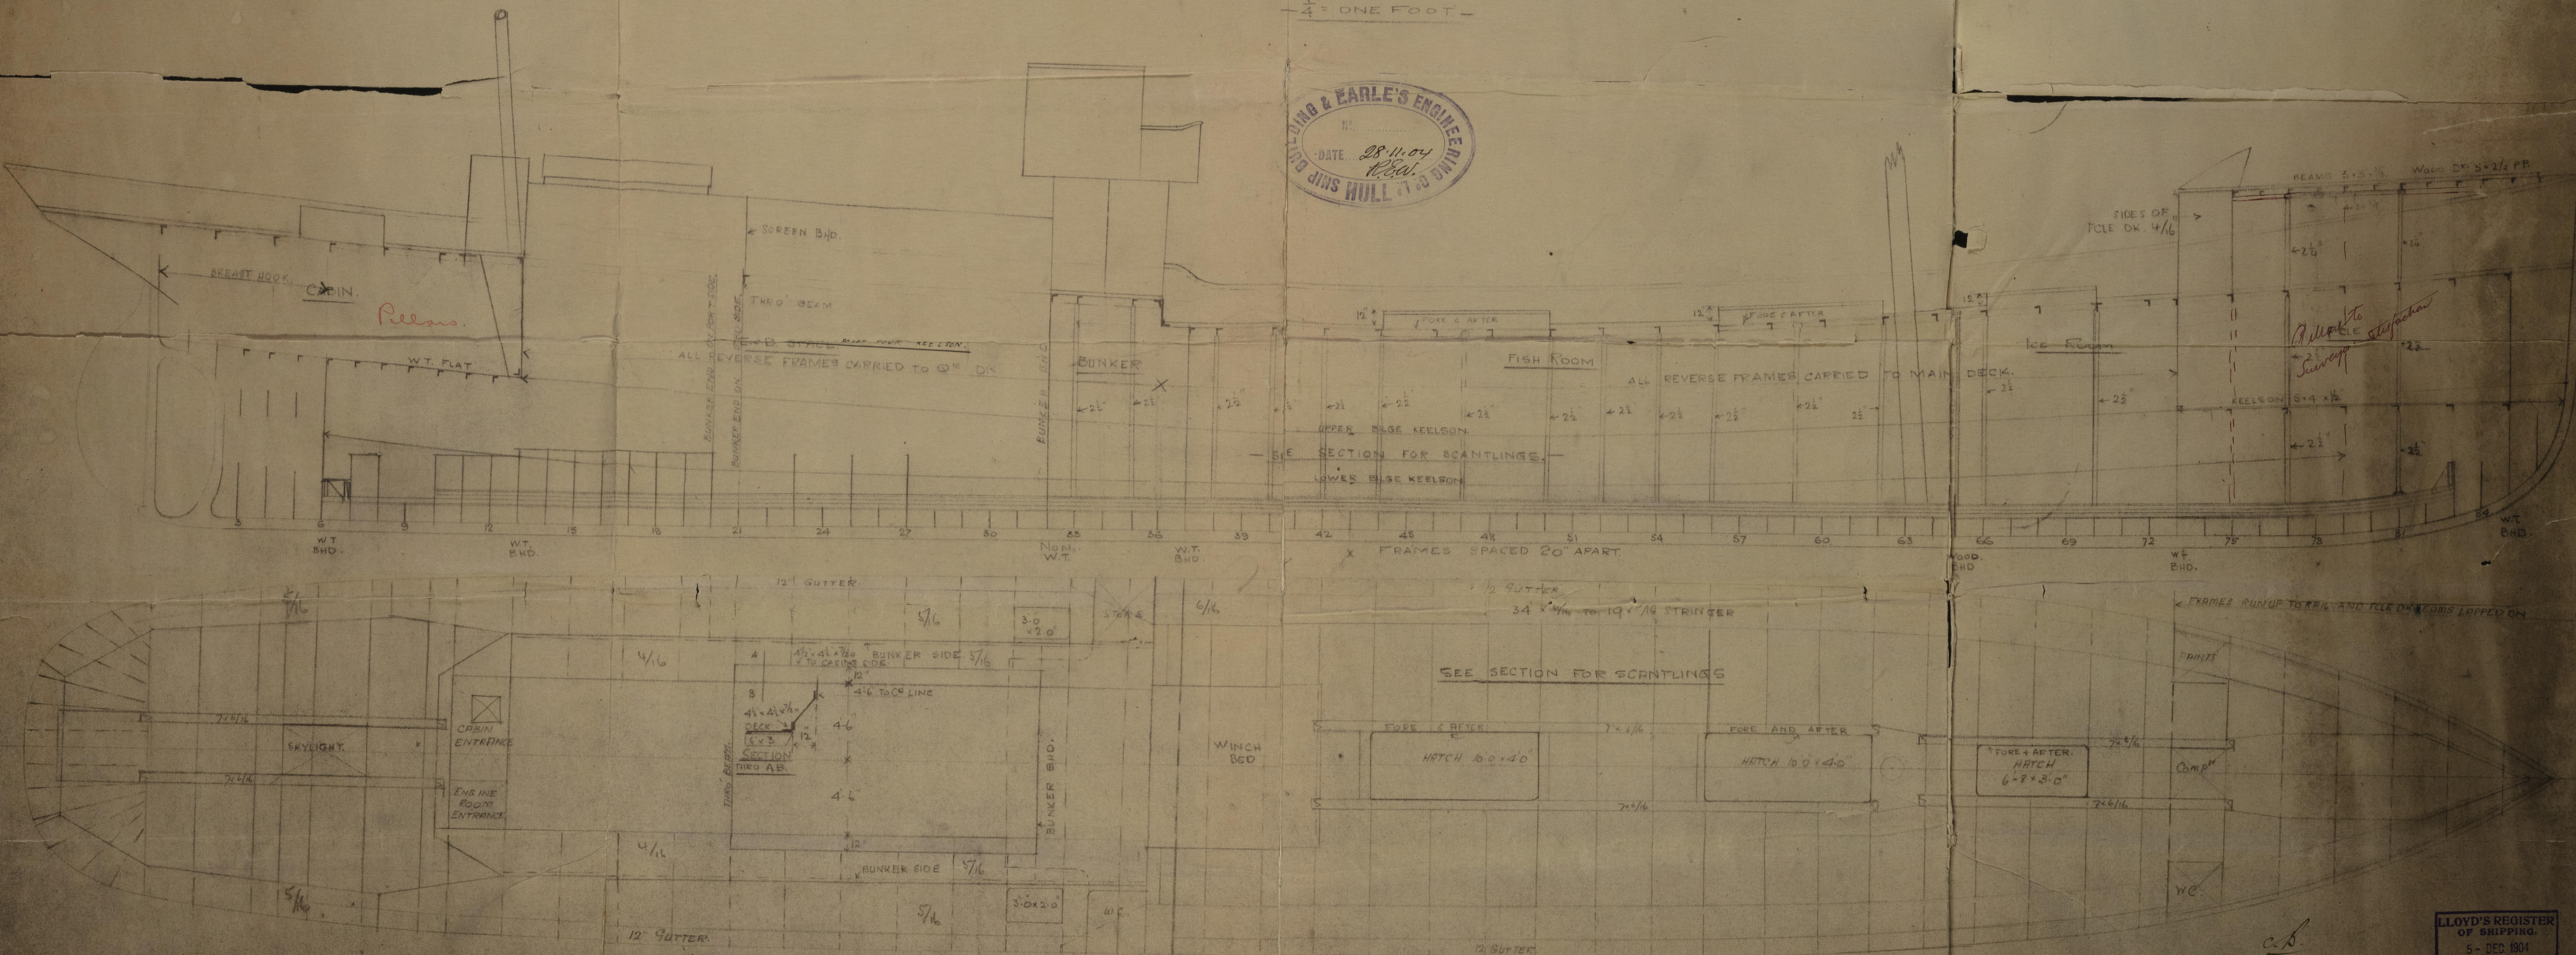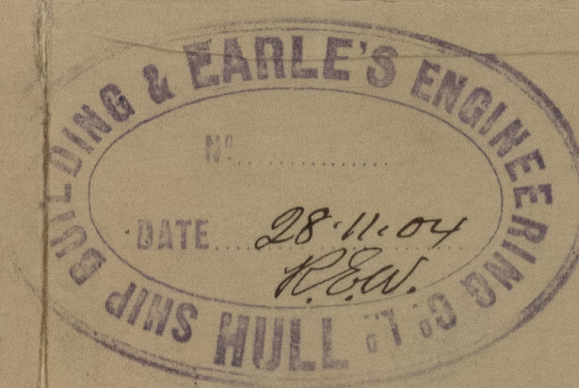


LLOYD'S REGISTER
OF SHIPPING
5-DEC-1904
HULL +

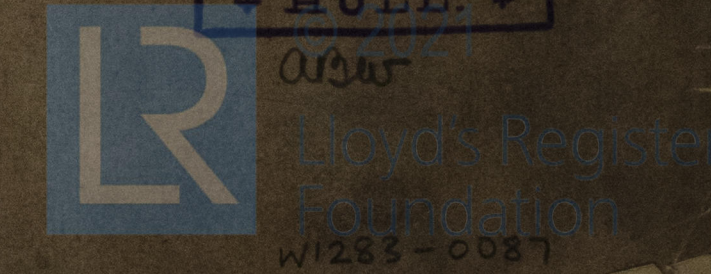

Charles S. & E. C. Lim.

N^o 492

Profile & Deck Plan

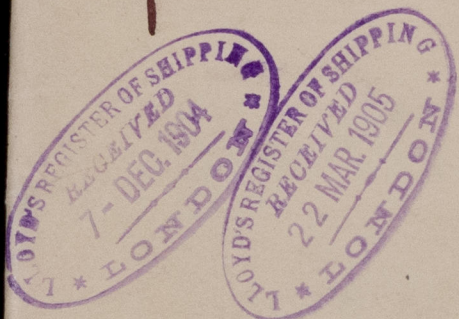

s/s Waterbury

Hull Rpt No. 16811

RETAIN



© 2021

Lloyd's Register
Foundation

W1283-0087