

- 492 -

MIDSHIP SECTION

9.12.04



- DIMENSIONS 146'8" x 23'0" EX (22-10 1/2 M.L.G.) x 11-9 1/2 M.L.D. -

- DEPTH OF HOLD 11'-3" -

- SCALE 1/2" = ONE FOOT -

- STEEL -


- CLASS 100 A.1. -
FOR FISHING PURPOSES

- LLOYD'S NUMERALS -

1/2 GIRTH	=	20.15
1/2 BREADTH	=	11.437
DEPTH	=	12.293
1ST NO	=	43.880
2ND NO	=	145.468
	=	6383.1358

- EQUIPMENT -

ONE ANCHOR	6 1/4 CWT EX STOCK
"	5 3/4 " " "
"	3 1/4 " " "
120 FMS 1 1/8 CHAIN	STUD LINK
60 "	6" HAWSER
60 "	5" HAWSER

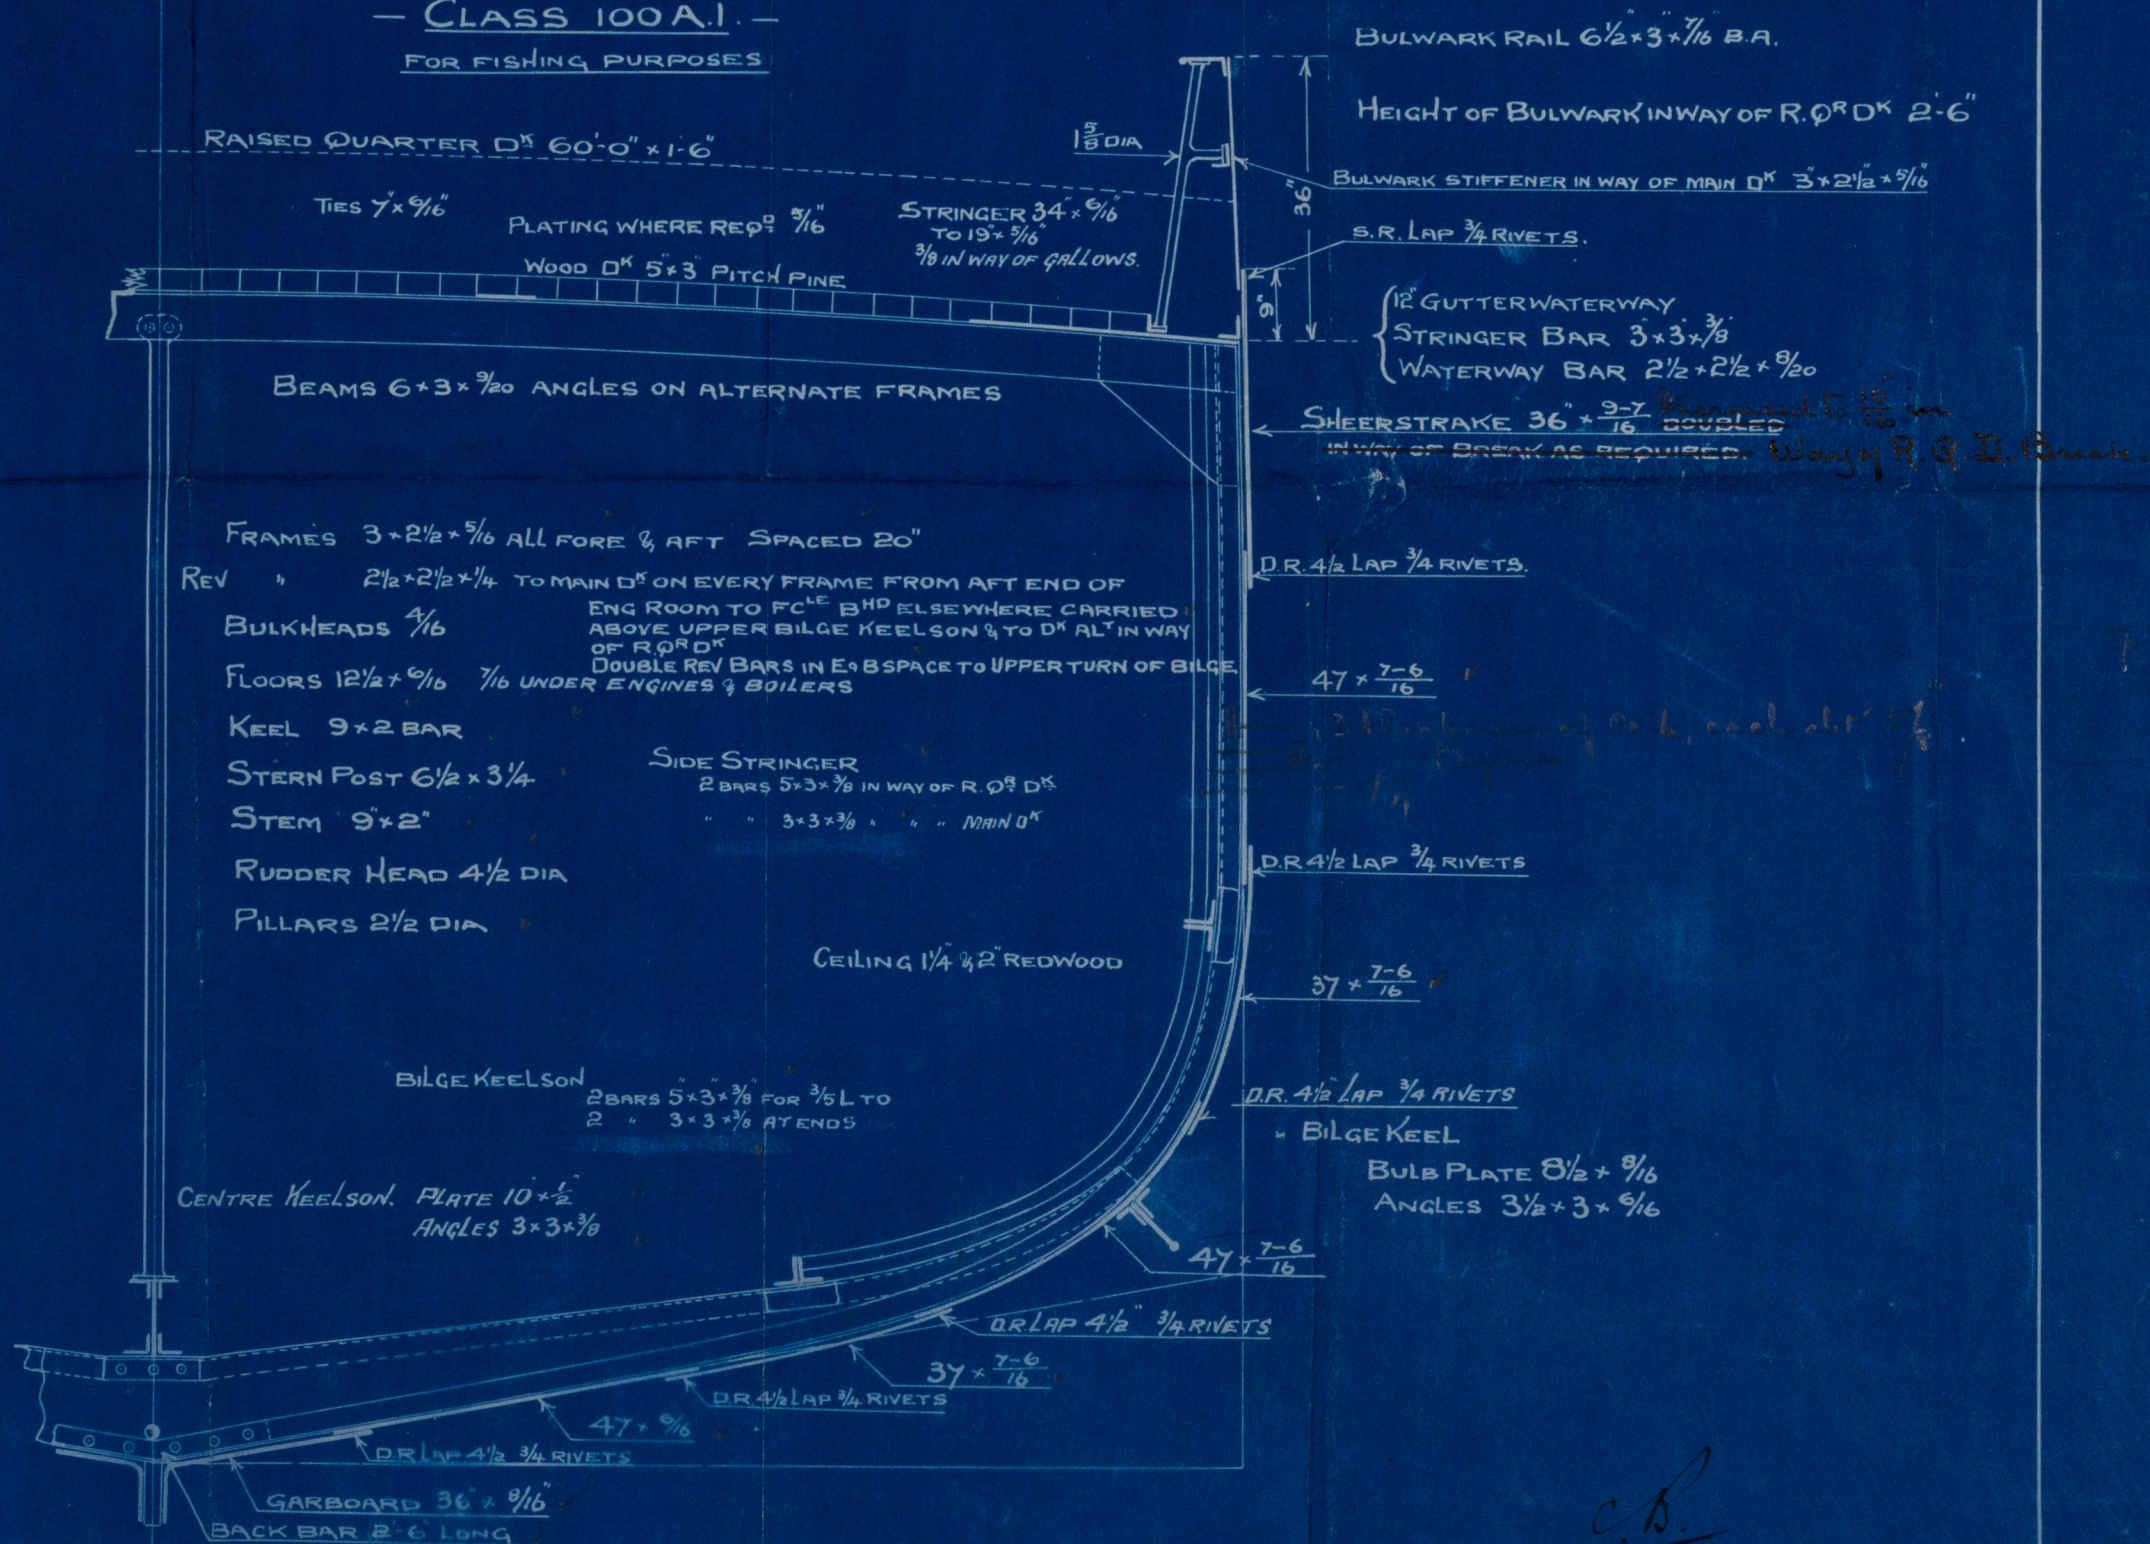

C.B.
9.12.04.




© 2021
Lloyd's Register
Foundation
W12 83-0088

Earle S.B. & E. Co. Lim.

Nº 492.

Amended

Midship Section

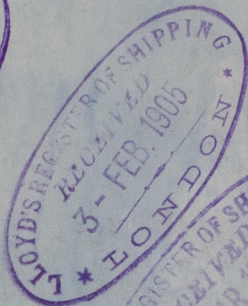

s/s Water Priory
Hull Report No. 16811



RETAIN



© 2021

Lloyd's Register
Foundation

W1283-0088