
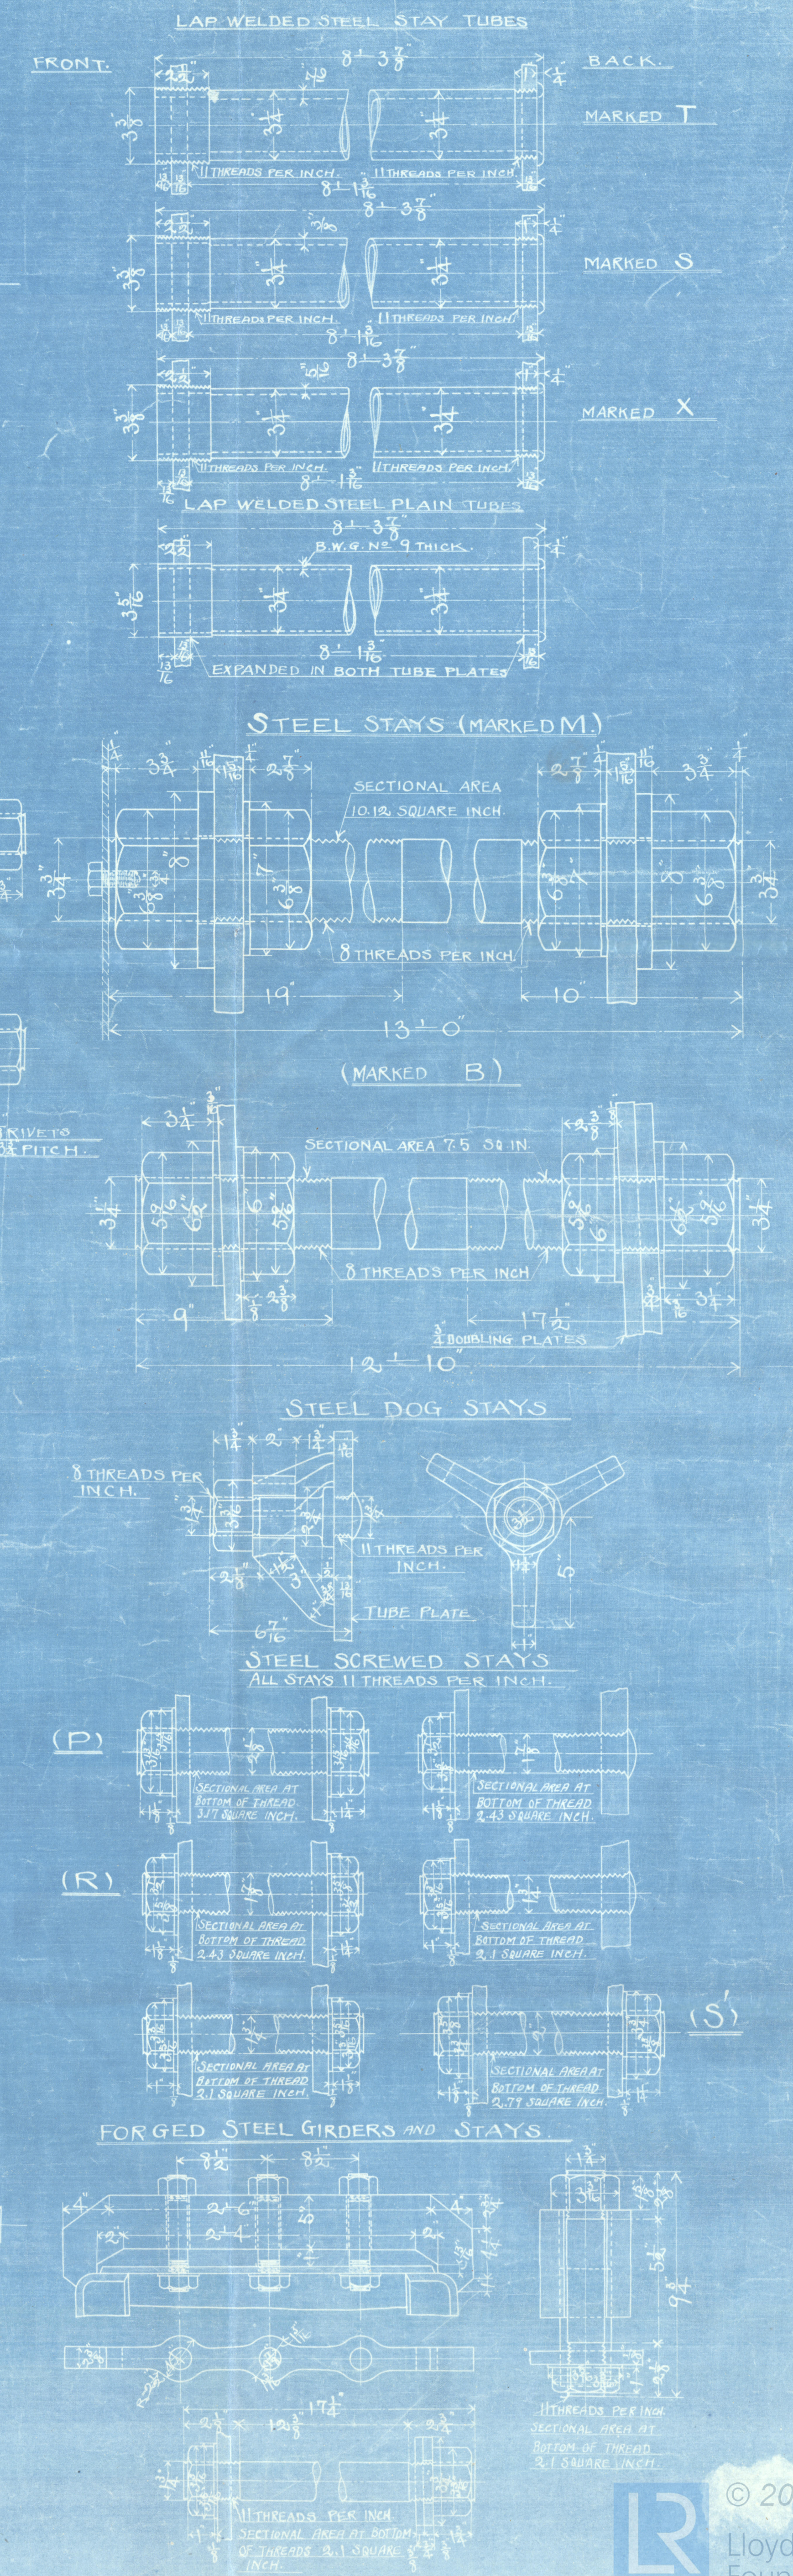
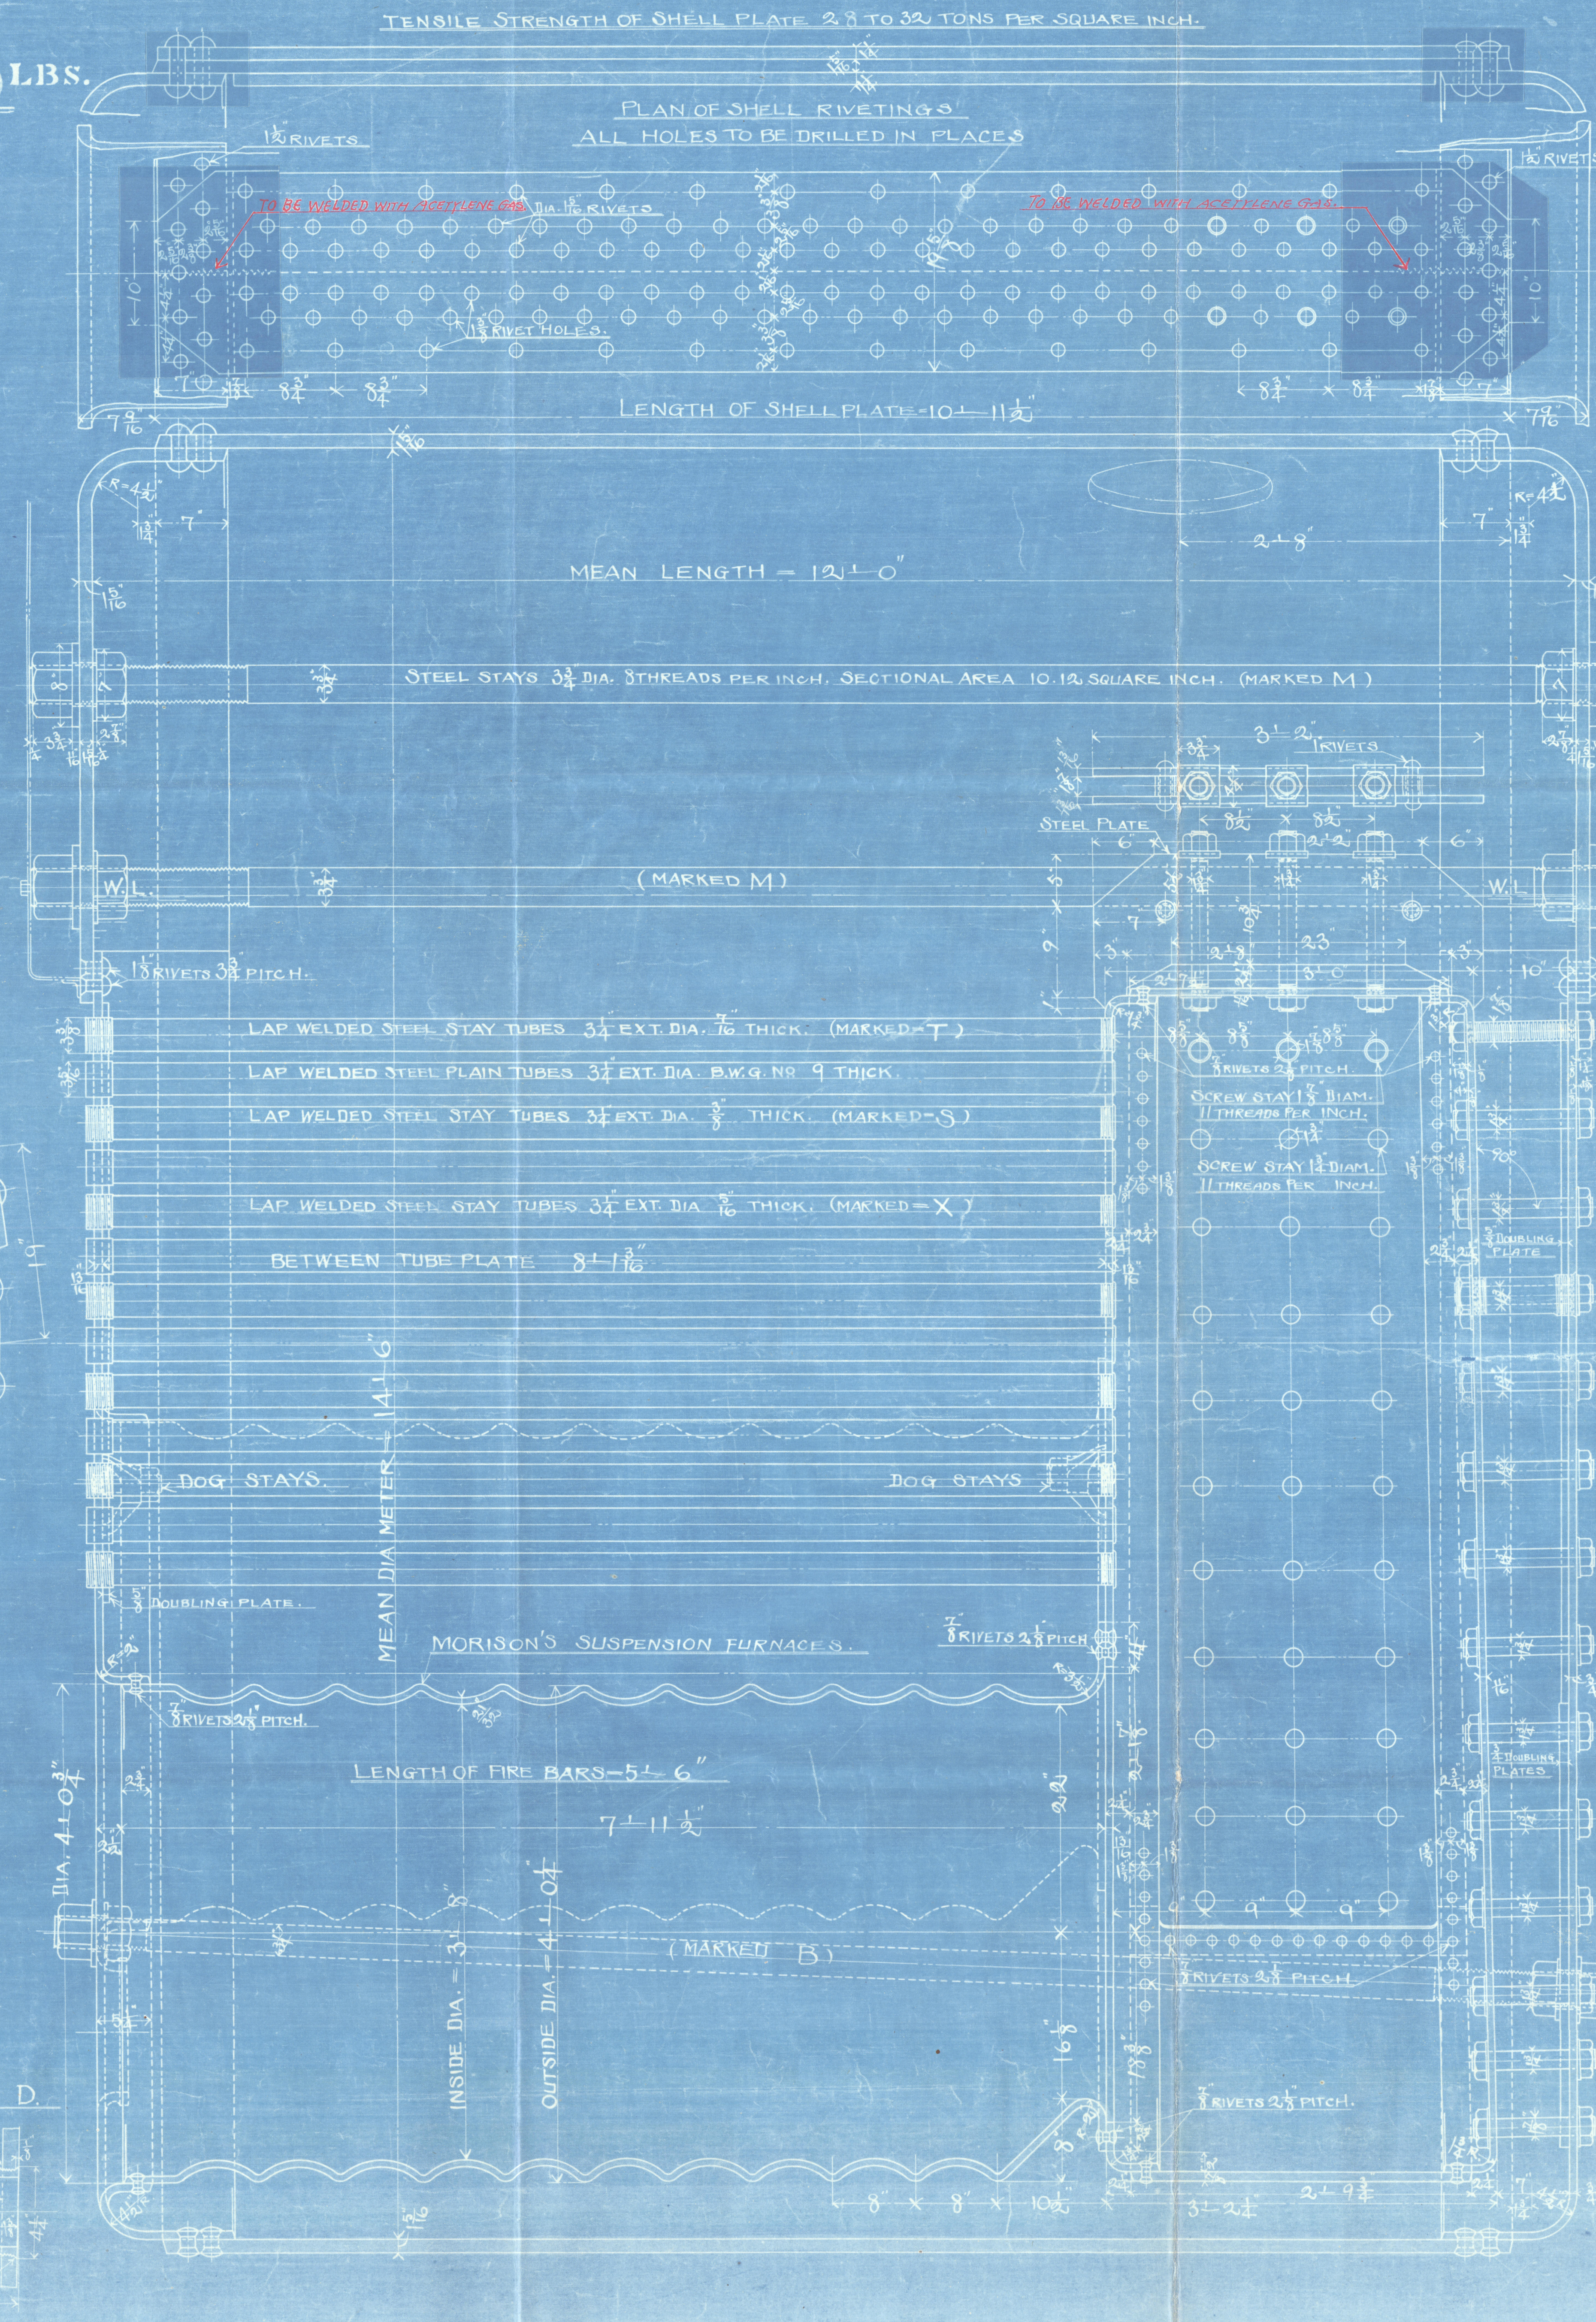


DIA. 14'-6" x 12'-0" LONG.
WORKING PRESSURE 200 LBS.
SCALE 1/4" IN. TO 1 FT.

2 THUS.
(LARGE)

HEATING SURFACES:	
TUBES:	1881.221 SQ. FT.
FLUES:	161.053 "
FIRE BOXES:	216.345 "
BACK TUBE PLATES:	46.205 "
TOTAL:	2304.824 "
GRATE AREA:	60.500 "
RATIO OF 1/2 G:	38.096
SECTIONAL AREA OF TUBES:	11.773 SQ. FT.
SEC. AREA OF TUBES:	1
GRATE AREA:	5.139

TUBES:
 181 STEEL PLAIN TUBES 3/4" DIA. NO. 9 B.W.G. THICK.
 32 STEEL STAY TUBES 3/4" DIA. 1/2" THICK. MARKED X
 54 STEEL STAY TUBES 3/4" DIA. 1/2" THICK. MARKED S
 6 STEEL STAY TUBES 3/4" DIA. 1/2" THICK. MARKED T
 273 IN ALL.

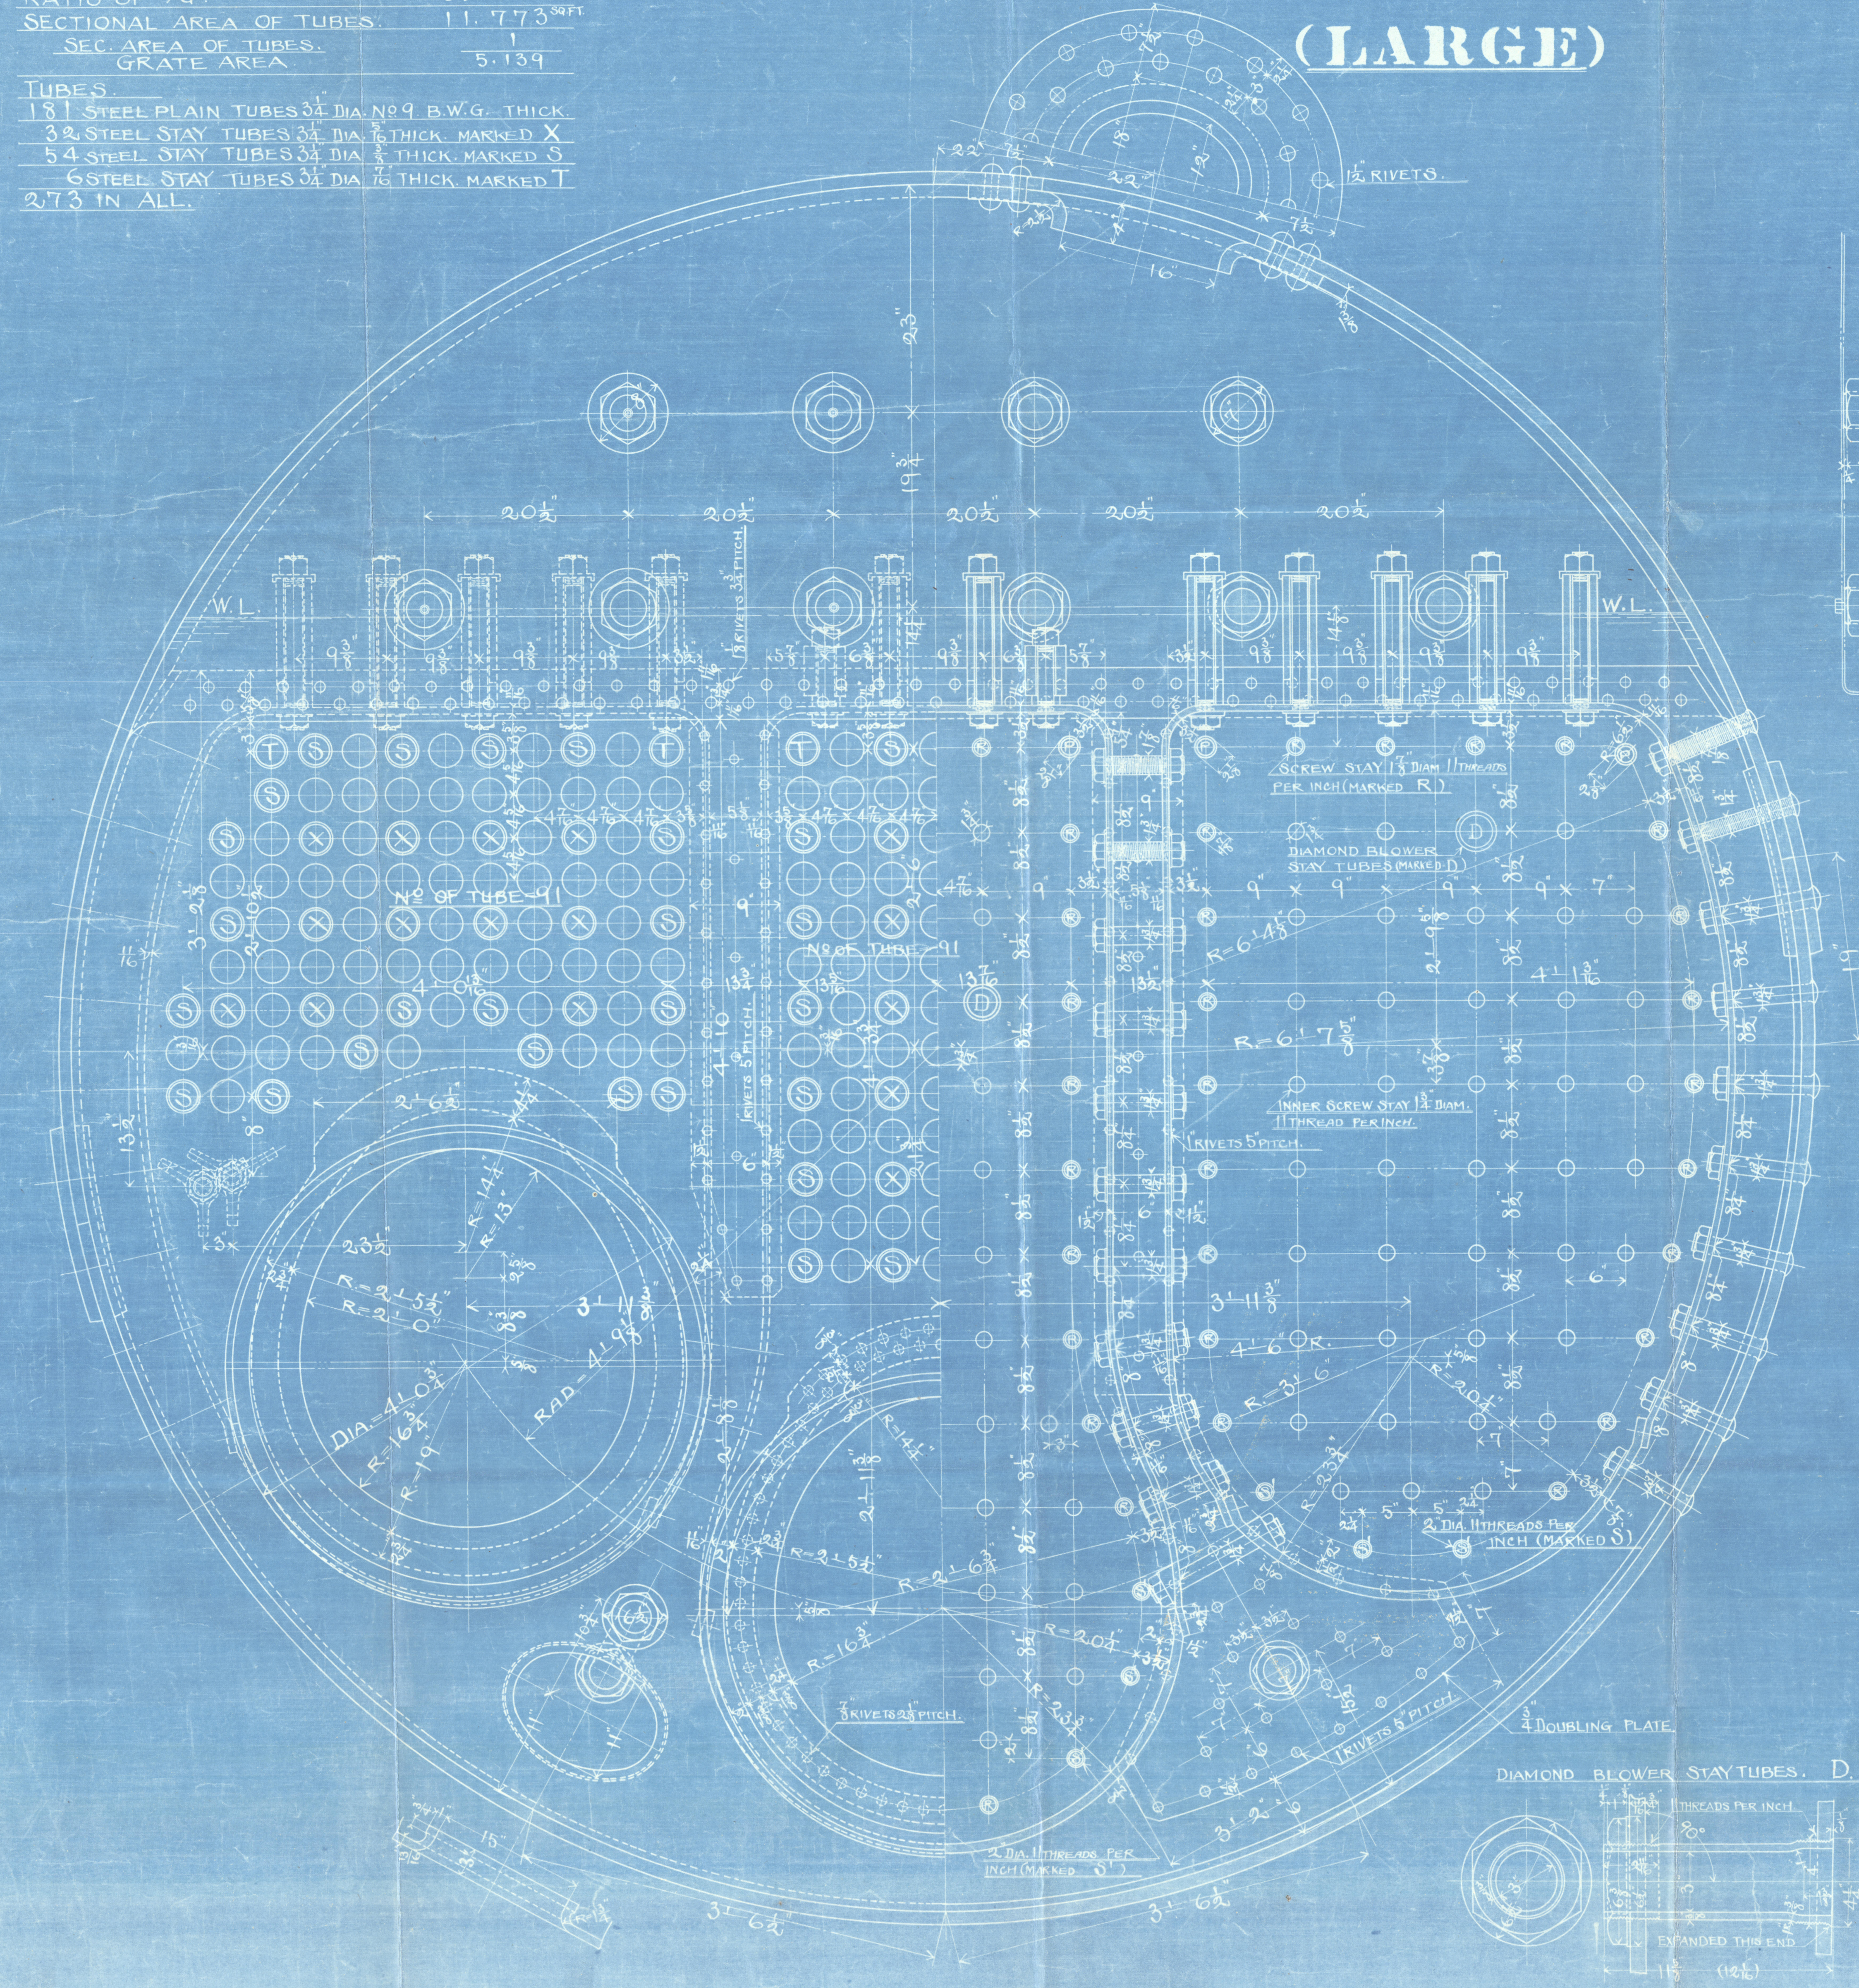

KAWASAKI DOCKYARD Co., LTD.

Builders No. 498.

S/S OHIO MARU

Large boiler.

Kobe Rpt No 2859

Drawing No.



© 2020

Lloyd's Register
Foundation

W1285-0064

神
戸
送