









23.6.10
8.7.10
14.7.10
21.7.10
10.8.10
7.9.10

S.S. N^o 809

LONGITUDINAL SECTION & DECK PLANS.

SCALE 1/8" = 1 FOOT.

809
21.7.10
7.9.10

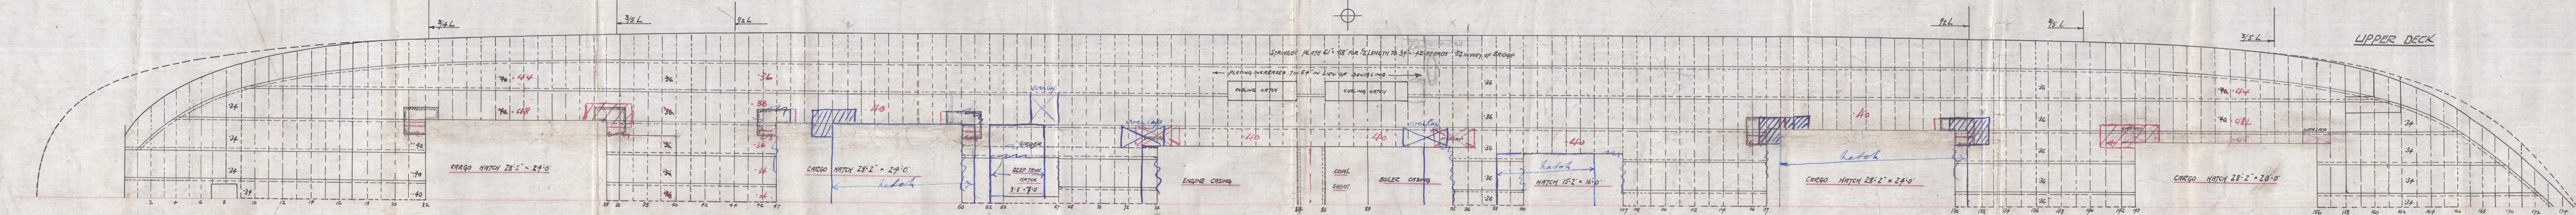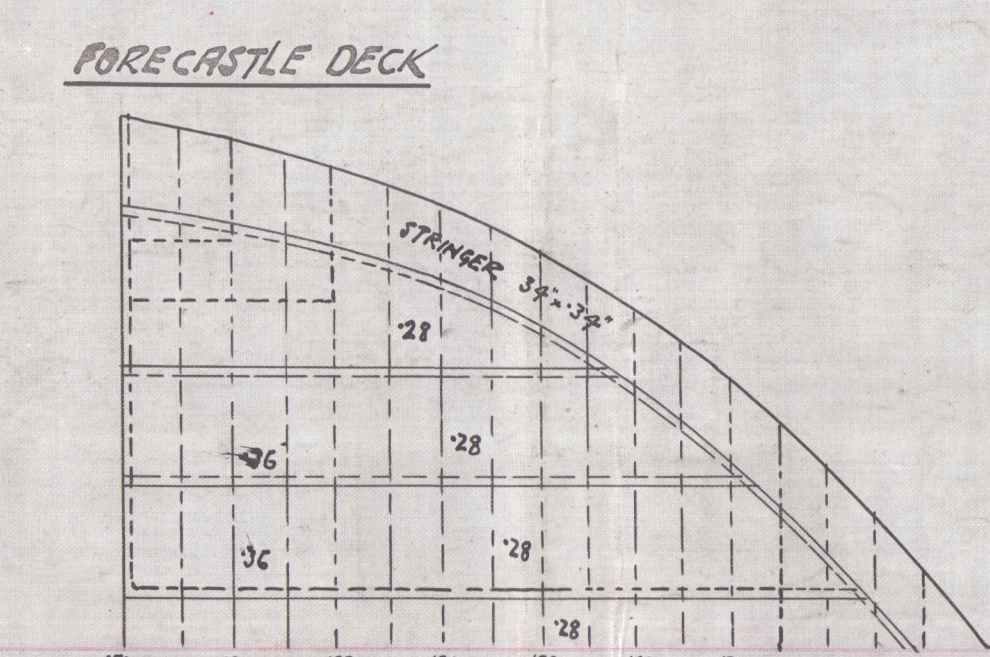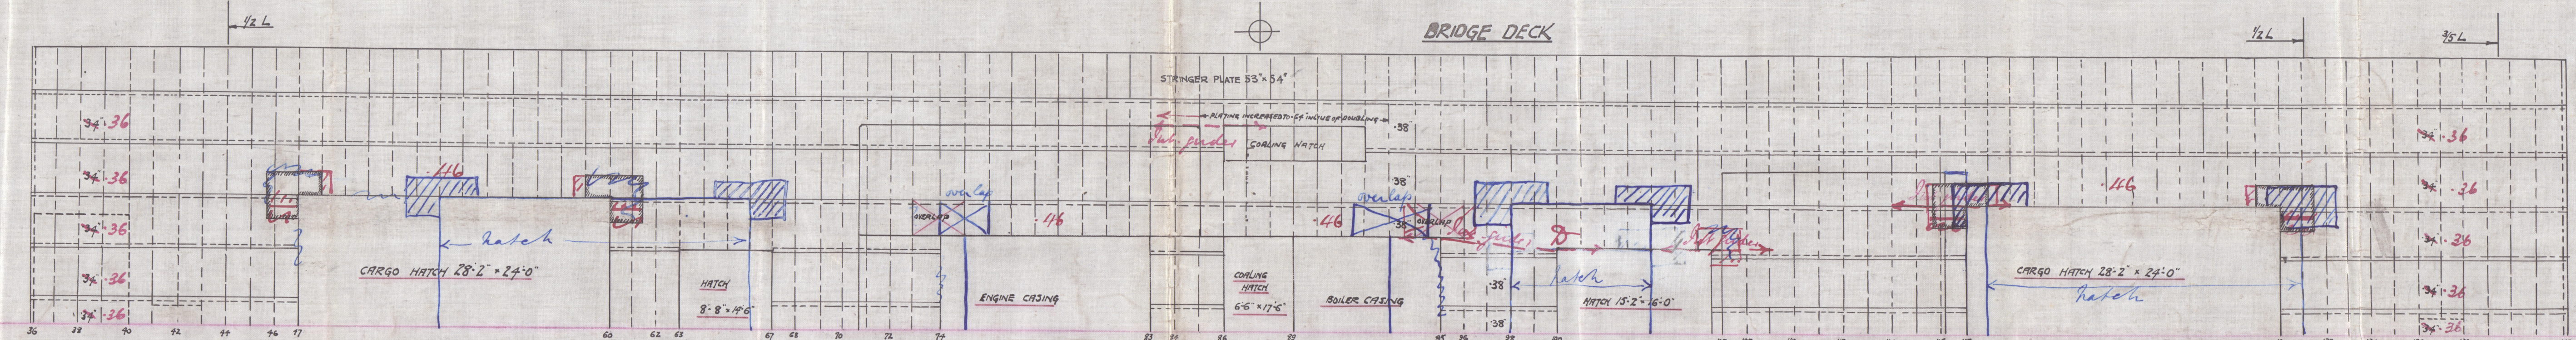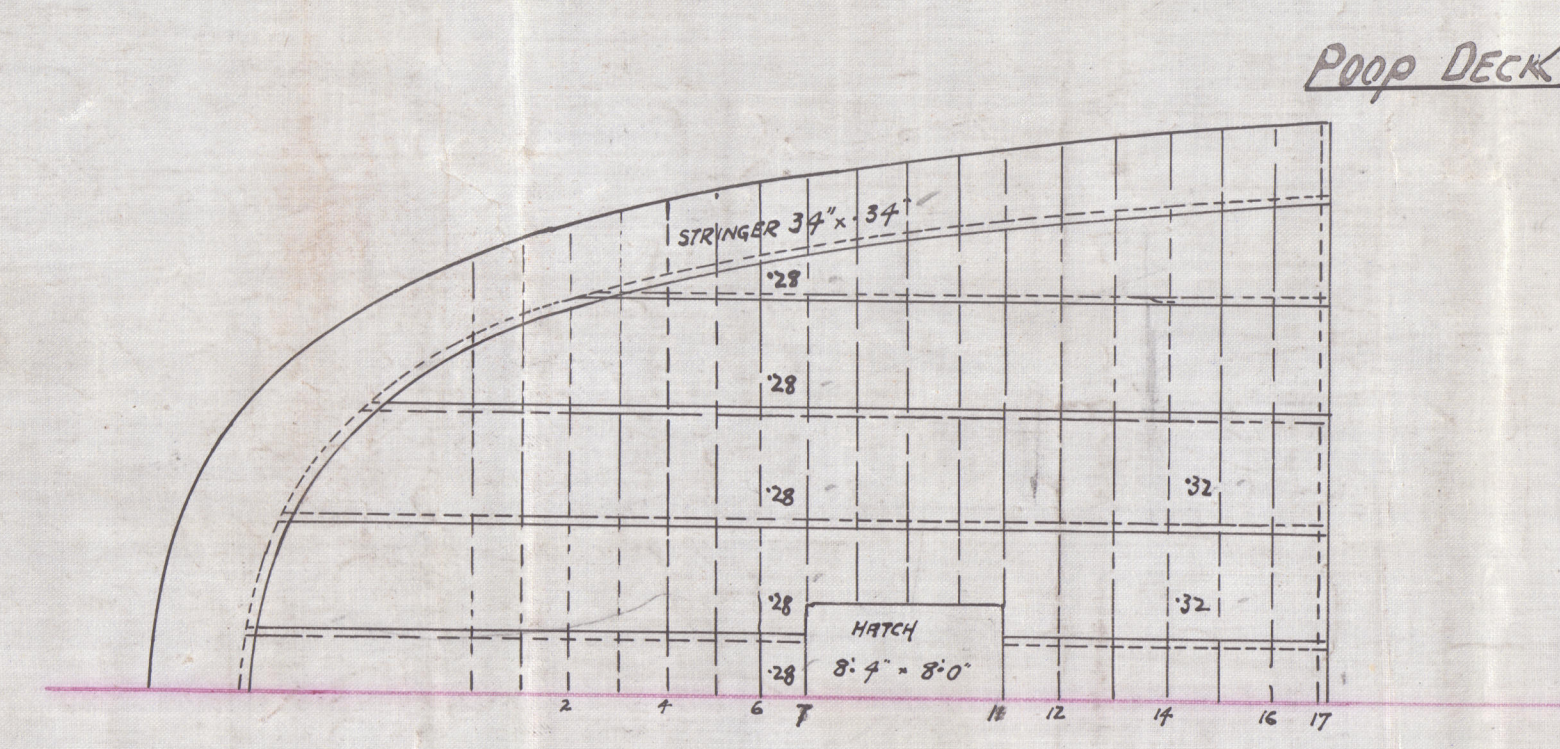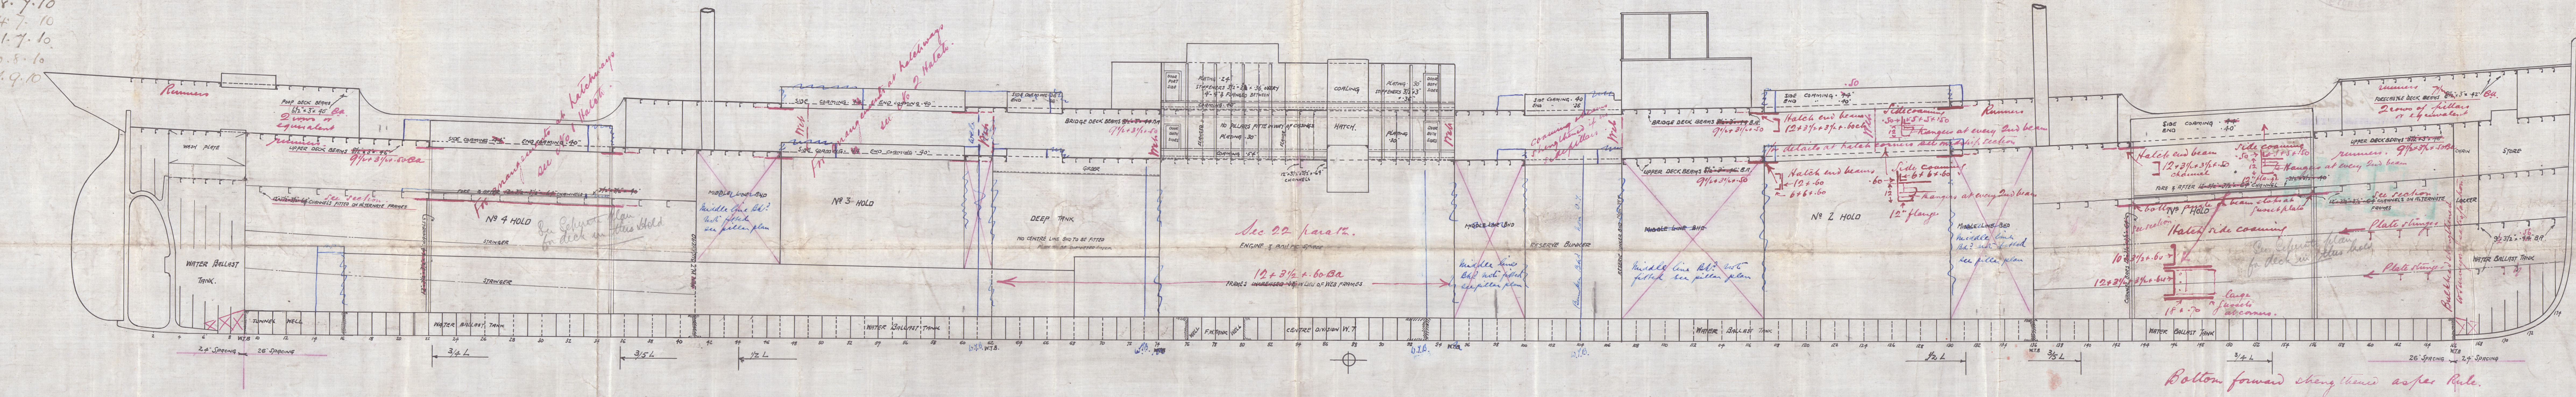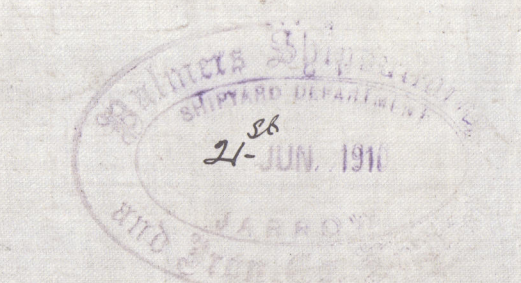

23.6.10
8.7.10
14.7.10
21.7.10
10.8.10
7.9.10

Palmer Co.
No. 809
Profile

J. S. Brady

NEWCASTLE-ON-TYNE.

No 60047

RETAIN



© 2020

Lloyd's Register
Foundation

W1285-0187