

SUNDERLAND ENGINE WORKS.

(AMENDED) BOILER.

SCALE-1 INCH TO A FOOT

SCHEDULE L.

WRITTEN DIMENSIONS ONLY TO BE TAKEN



N. E. Warner



Box No 2276

George Taylor No 191

180 lbs

Sunderland 23/9/16

Amended plan.

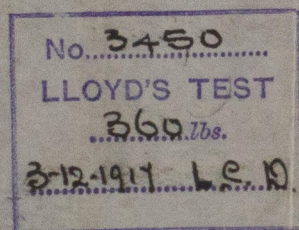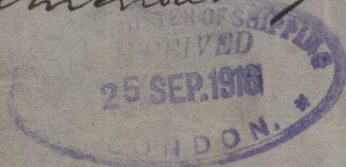

SUNDERLAND RPT. NO. 27186 11

Ms Maindy Lane

Inst 10703

now Lady Brenda

RETAIN

W1286-0175



© 2020

Lloyd's Register
Foundation