


STEEL BOILER 10-0 DIA 10-0 LONG

LLOYDS 180 LBS W.P.

N^o 4973

Shell Plate 9'-3" Wide

15/16" Holes 1/2" Pitch 13 Pitches

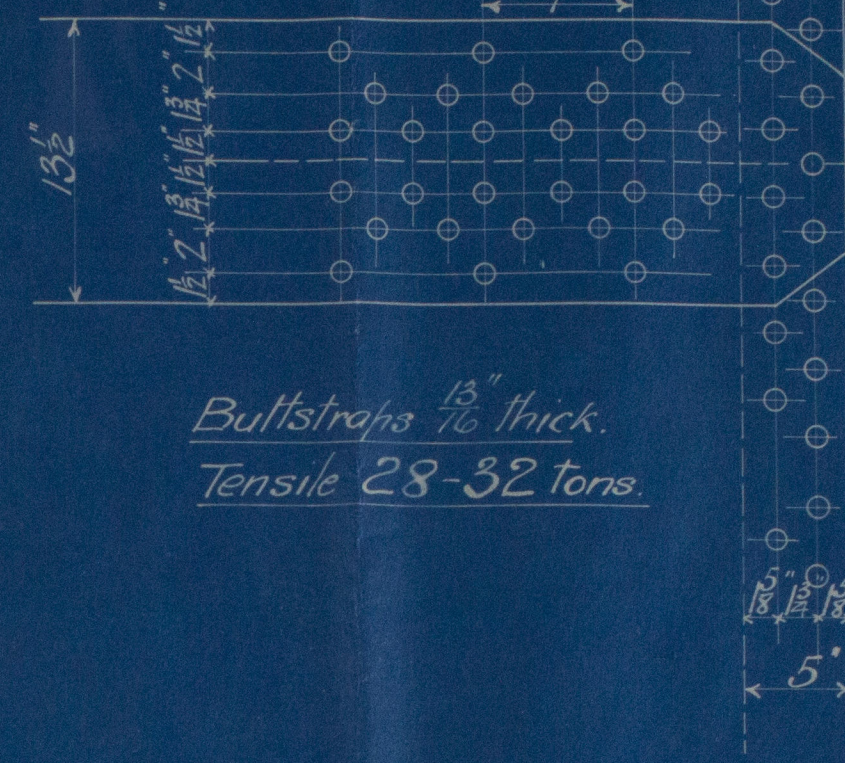


Bultraps 13/16" thick.
Tensile 28-32 tons.

Circum Seams 1 1/16" H. 3/4 P. double riveting.
to be continuous below furnace line.

RILEY BROS. (BOILERMAKERS) LTD
STOCKTON ON TEES.

C.C. Back stays. Fitted with nut at each end.

⊙ 1 3/8" dia. 9 threads. 2.36 area. Steel
○ 1 3/4" " " " 2.03 " "

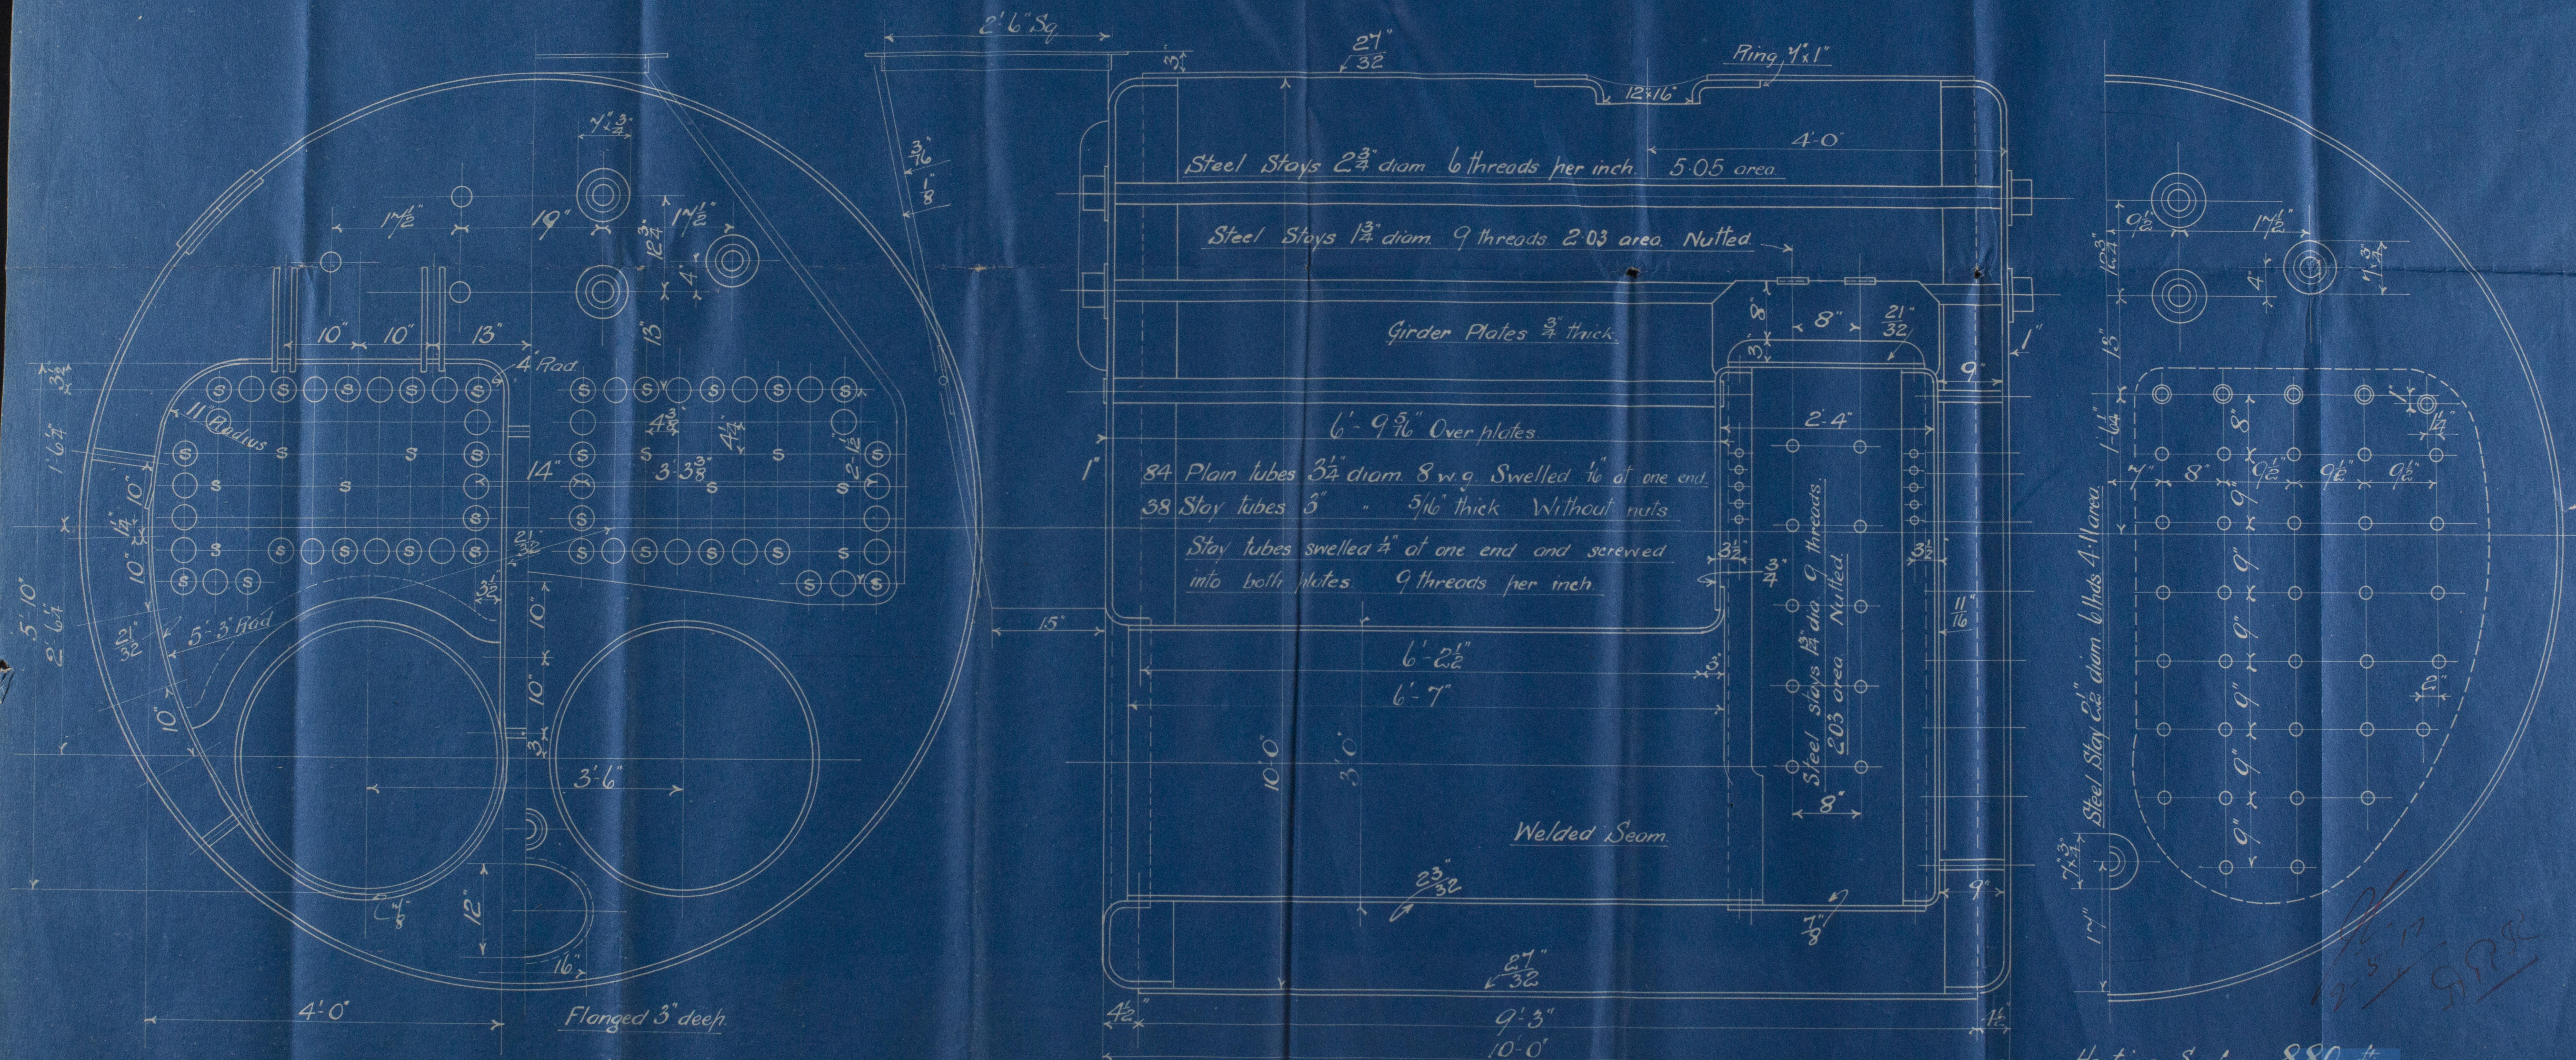

72A

Heating Surface 880 sq. ft.
Grate area. 29 sq. ft.
Firebars 5'0" long.

Messrs Riley Bros Ltd

Boiler No 4973

for


Messrs Craig Taylor & Co

S.S. No 191

Working Press 180 lbs

No.	5844
LLOYD'S TEST	
360 lbs.	
14.12.17 - W.M.	

trial
report
No 9978.

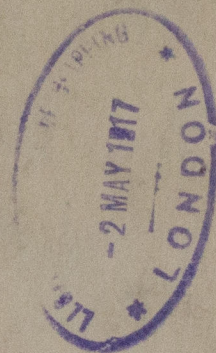

S. S. Maindy Dene

trial 10103.

now
Lady Brenda

RETAIN

W. H. J. J.

W 286-0178

© 2020

Lloyd's Register
Foundation