


SKETCH. C


S. S. "EUCLID"

Coal carried in spaces shown crossed

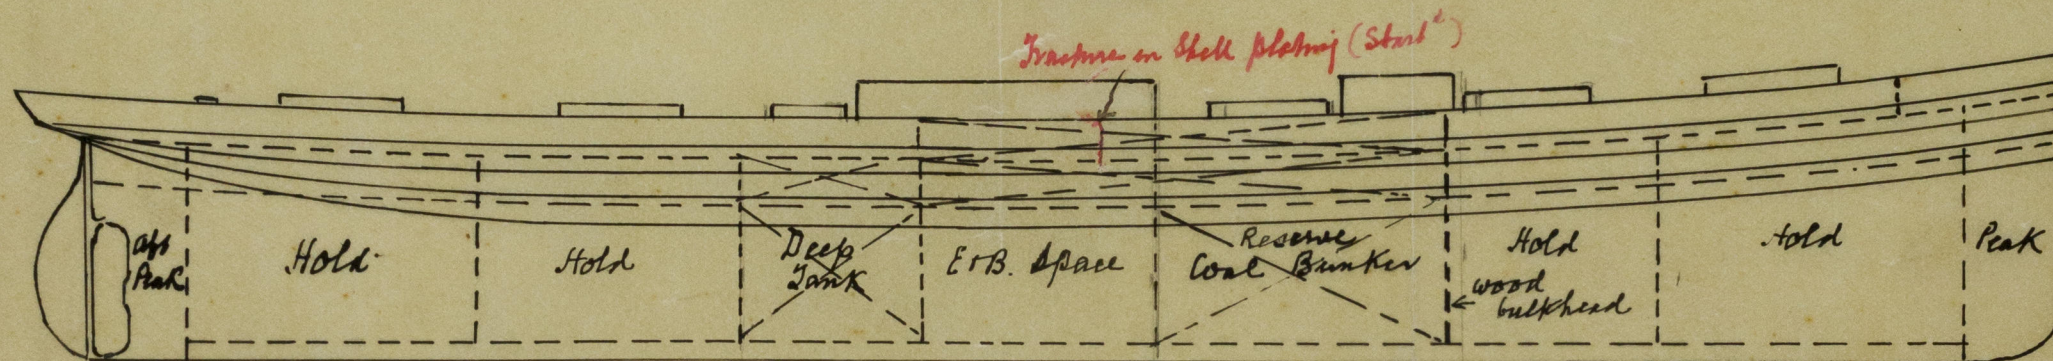

PLAN OF SHELTER DECK

Butt of Sheerstrake opened up

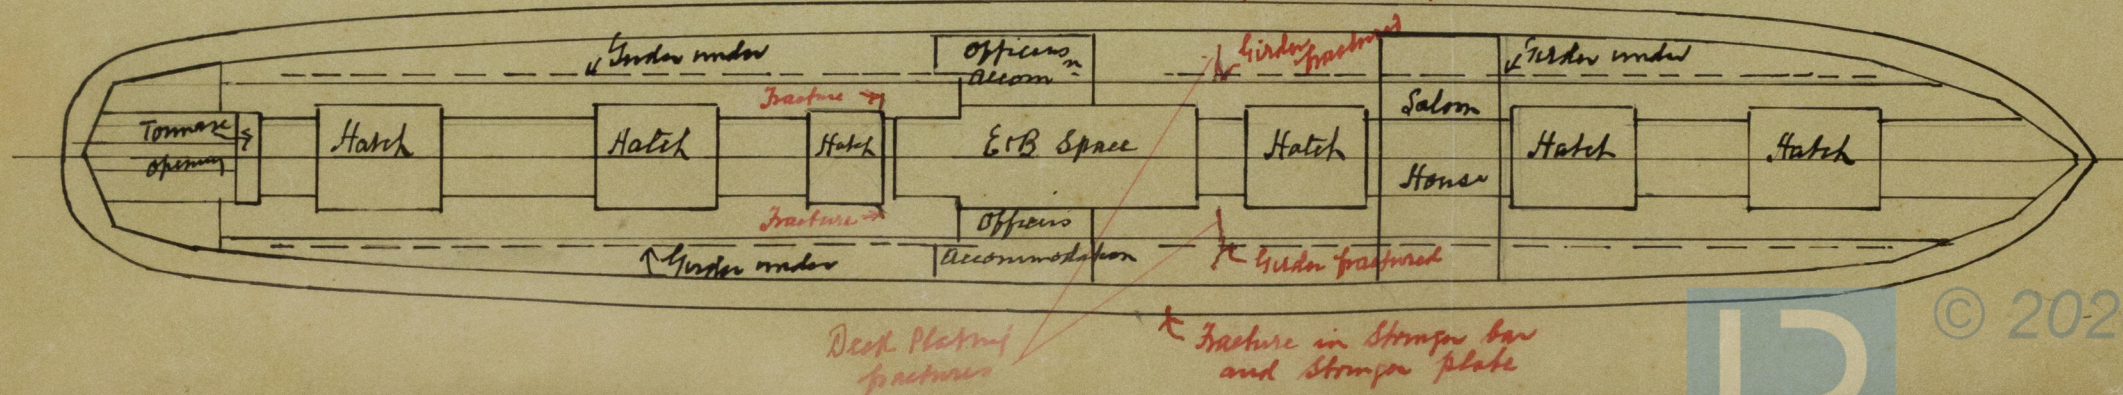

© 2020

Lloyd's Register
Foundation

W1288-0060