


PROFILE N°124

SCALE $\frac{1}{8}'' = 1$ FOOT

106- See amended sketch of Ditches & Loc. Graves as approved. Herewith attached.

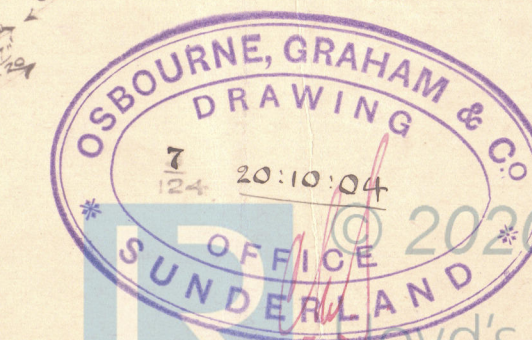




© 2020

Lloyd's Register
Foundation

W1288-0394

W1288-0394

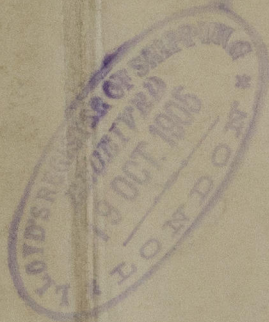

© 2020

Lloyd's Register
Foundation

OSBOURNE GRAHAM & CO

S.S. No 124

- PROFILE & DECK PLAN -

S.S. "Needwood"

