

PROFILE & DECK PLANS. See separate plan for 2nd Deck.


S.S. N^o 219.

SCALE - $\frac{1}{8}$ " = 1 Foot.


LENGTH B.P. 405'-0". BREADTH M^d. 53'-2". DEPTH M^d. 28'-0".

WINDLASS, WINCHES, & MASTS SUPPORTED TO SURVEYORS SATISFACTION.


20.1.14
14.10.14

 

SHUTTER DECK.

 

UPPER DECK





 


18
MR. C. S. J. R. H.
7.1.1914.

CJ.
20.1.14


Northumberland S.B. Co.
No 219

Amended plan of Profile & docks
brought up to date

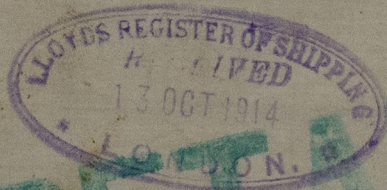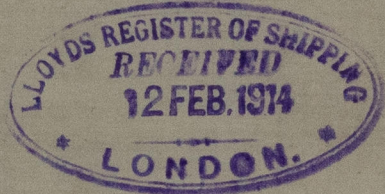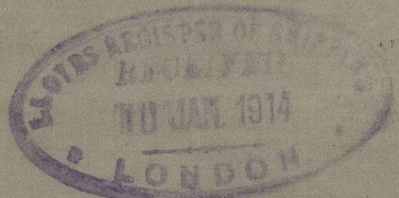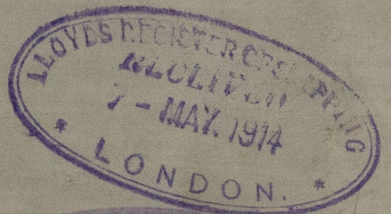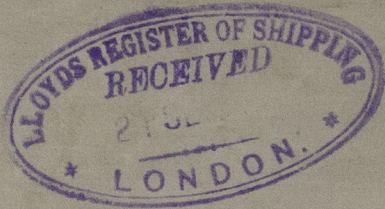

RETAIR
J.S. TYSLA
NEWCASTLE-ON-TYNE.

Report No 66854

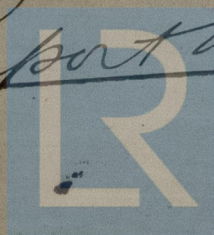

Lloyd's Register
Foundation
W1289-0121