

PLAN No. 9326  
FOR ENCLOSURE TO  
Messrs Lloyd's Surveyors  
Hull FROM  
COCHRANE & SONS,  
SHIPBUILDERS, SELBY  
DATE 6/6/10 RK

# MIDSHIP SECTION

STEEL      SCREW      TRAWLER

N<sup>o</sup> 474


DIM<sup>NS</sup> 130'-0" x 23'-6 EX x 13'-0 M<sup>LD</sup>

SCALE  $\frac{1}{2}'' = 1$  FOOT.

To BE CLASSED 100.A.1. AT LLOYDS FOR FISHING PURPOSES

ENGINE & BOILER CASING AS PREVIOUSLY APPROVED.

DECK PLATED OVER IN WAY OF MACHINERY SPACE

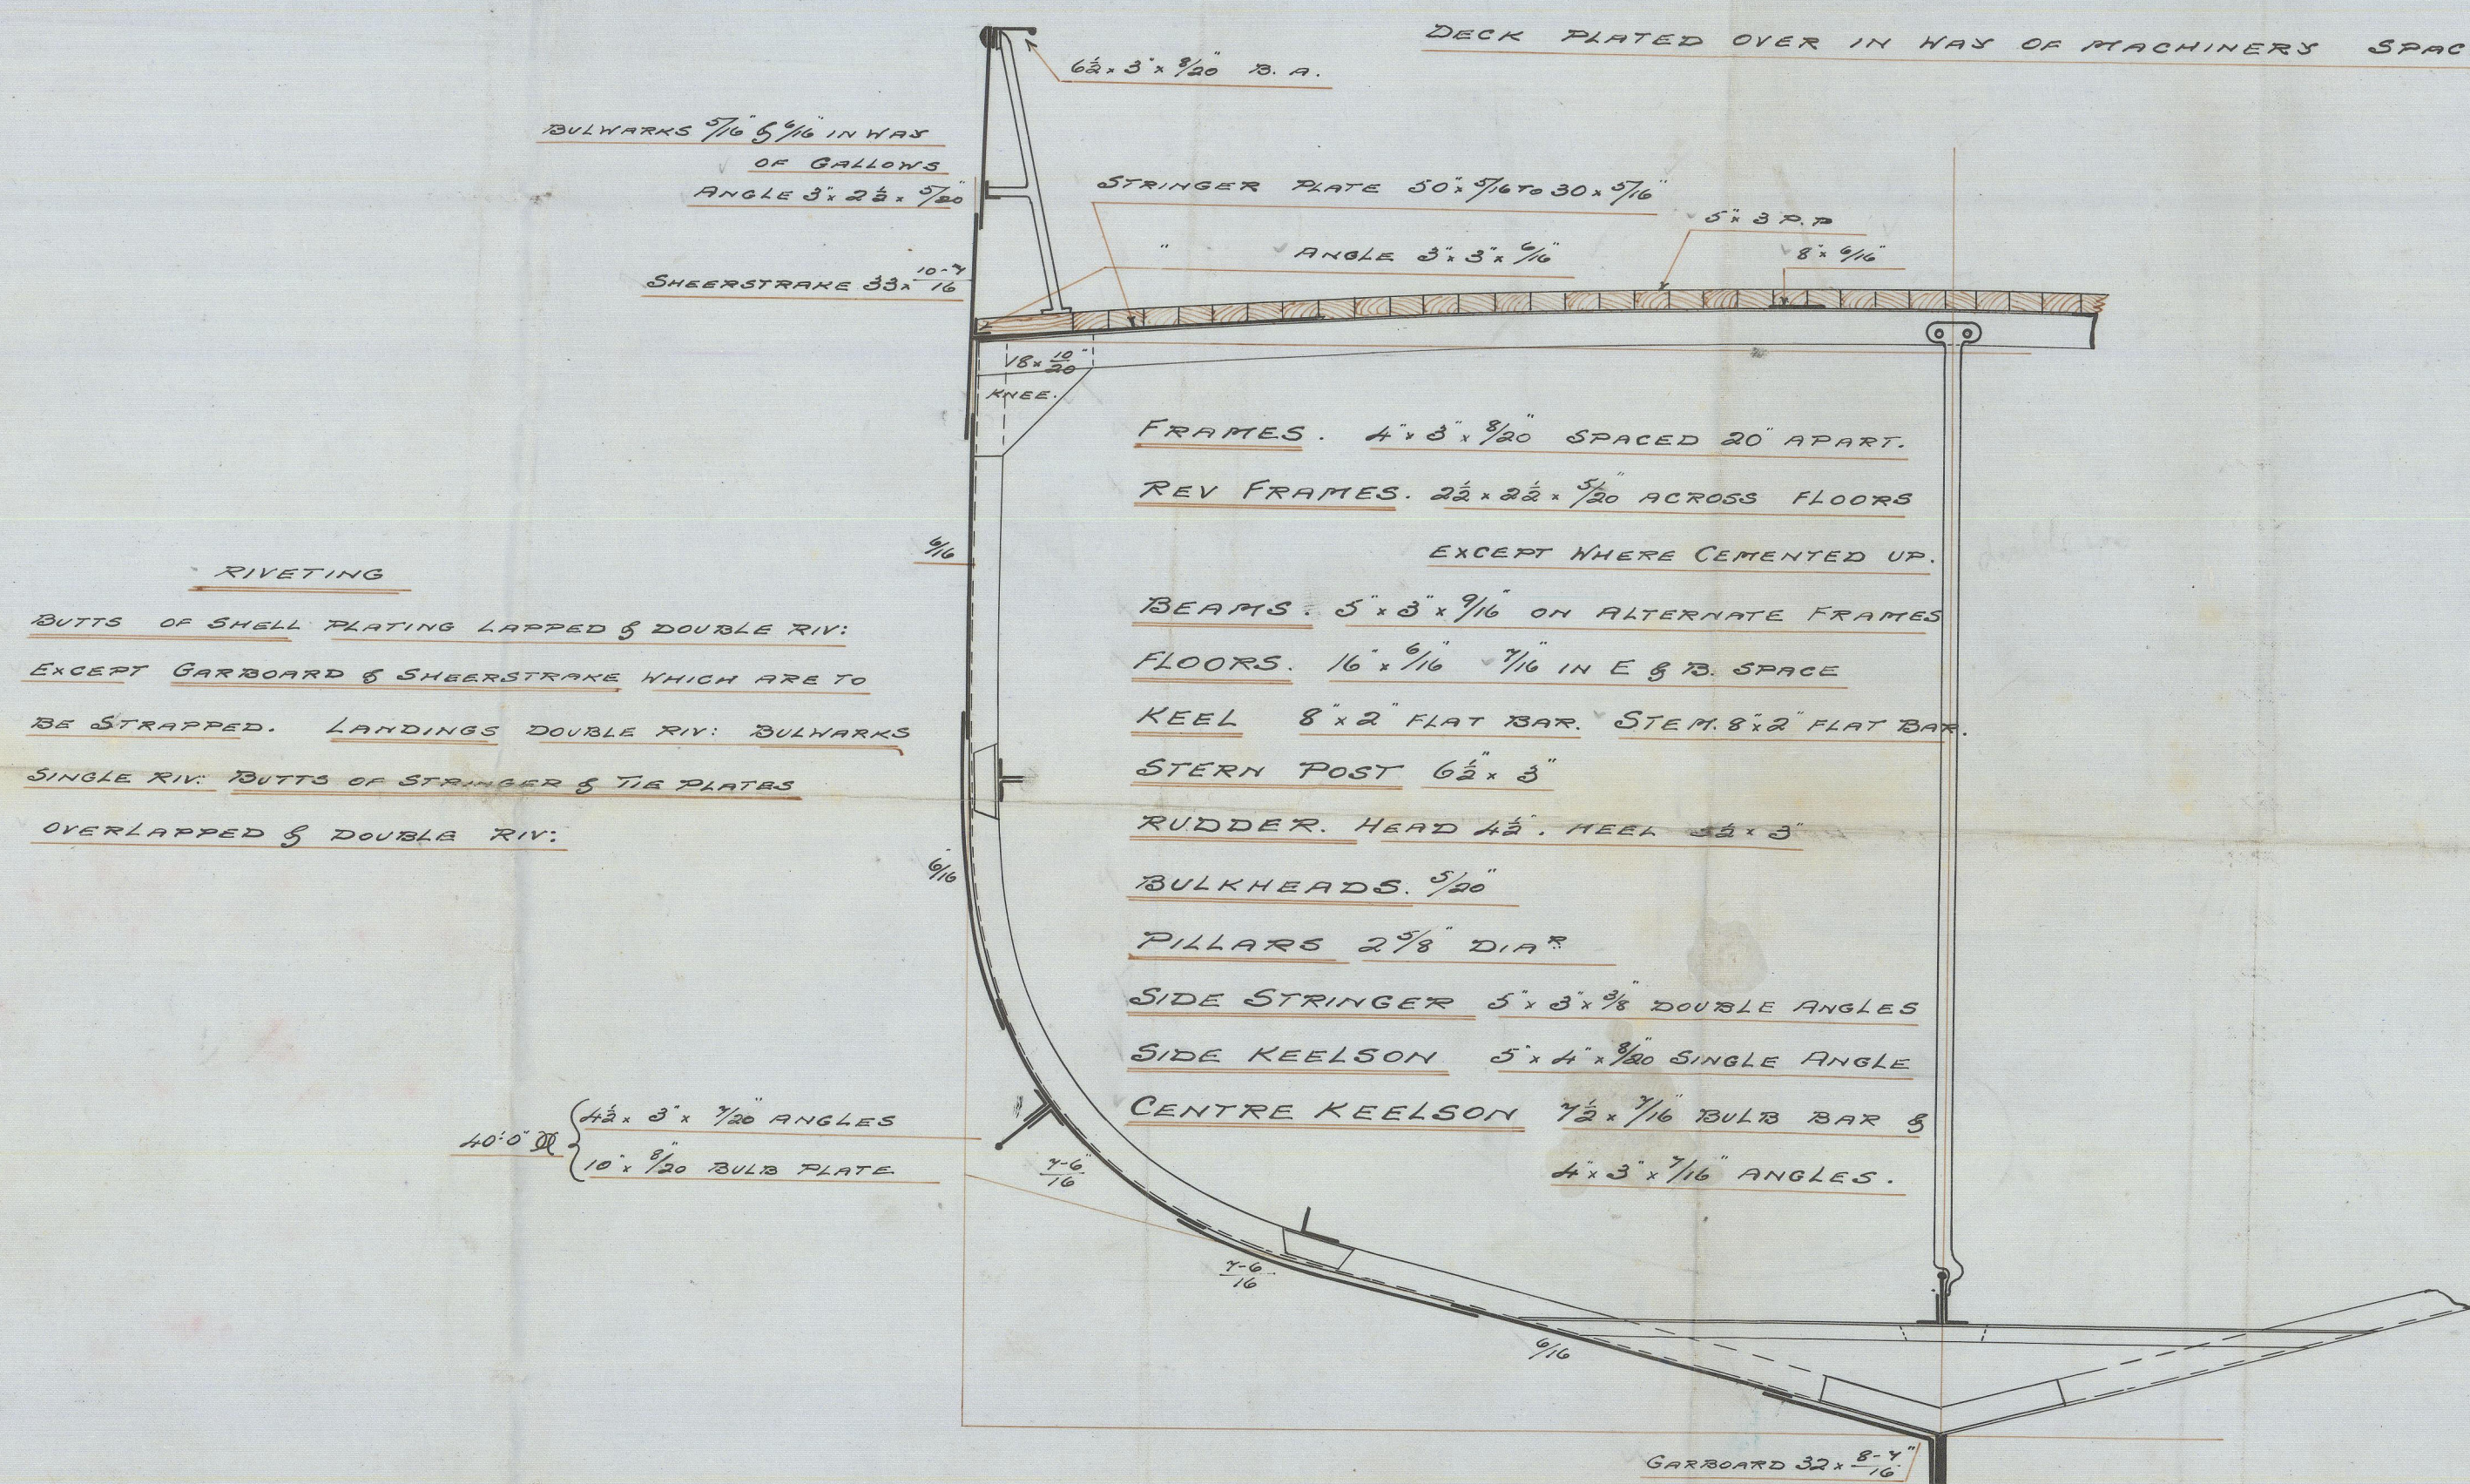

LLOYDS. NUMERALS

$D + B$	$=$	36.37
$4 \times (D + B)$	$=$	4728.10

## PROPORTIONS

PROPORTIONS

$\frac{3}{4} = \frac{6}{8}$  = 5.5

$\frac{3}{4} = \frac{6}{0}$  = 10.0

## EQUIPMENT

1ST BOWER FINCH.	5 <sup>1</sup> / <sub>2</sub> CENTS	EX STOCK.
2 <sup>ND</sup> " " "	5 <sup>1</sup> / <sub>2</sub> " "	" "
3 <sup>RD</sup> " " "	5 " "	" "
105 FATHOMS	1 <sup>1</sup> / <sub>16</sub>	CABLE
60 " "	0	HANDBR
60 " "	0	WARR

INVENTORY			
ANCHOR.	S <sup>1</sup> / <sub>2</sub>	CHTS	EX STOCK.
	5 <sup>1</sup> / <sub>2</sub>	"	
	5	"	
	1 <sup>1</sup> / <sub>16</sub>	CABLE	
	6	HANGER	
	5	WIRE	

C.7.  
9/6/10.



Midship Section-  
Cochrane's & Sons

No 474  
JW

of Alberici  
Hull Rph. no 23134

REMAIN



© 2020

Lloyd's Register  
Foundation