
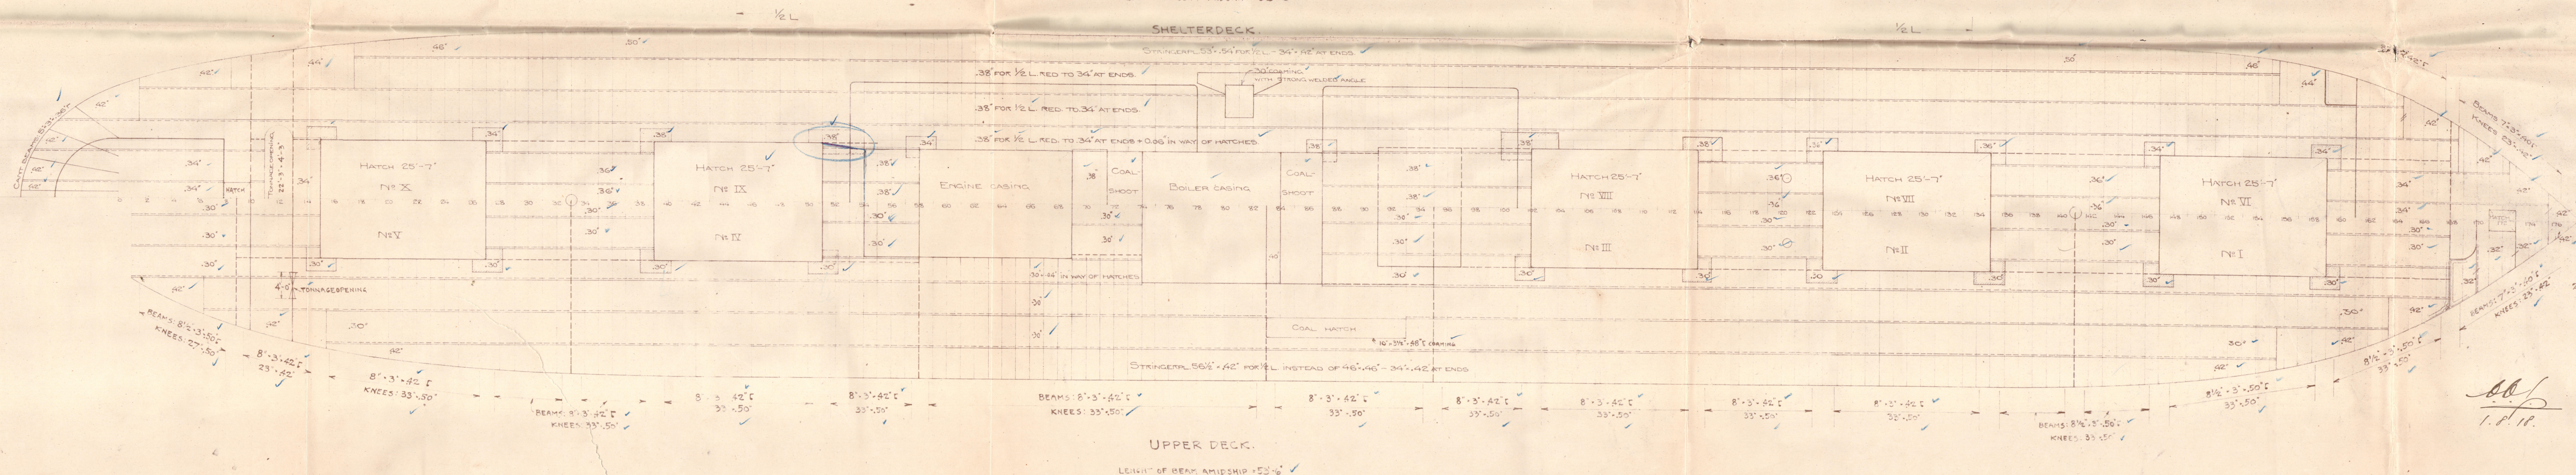


TWEEN DECK BULKHEADS.				
BULKHEAD VERTICAL FRAME JUNCTION	VERTICAL STEPPERS SPACED 30" APART	BRAKETS	BOUNDARY ANGLES	
			TO BULKHEAD	TO DECK
10	26°	4" x 5", 30" ✓	NONE	3" x 8", 30°
12	26°	4" x 5", 30" ✓	"	3" x 5", 30°
161	28°	6 1/2" x 5", 44" ✓	"	3" x 5", 30°

FOR BULKHEADS BELOW UPPER DECK SEE SEPARATE PLAN (440-6)

BEAMS IN SHELTERDECK FROM FR. 11 TO FR. 17 = $8' \cdot 3' \cdot 42''$ (EXCEPT HATCH END BEAMS)
KNEES = $23' \cdot 42''$
LENGTH OF BEAM AMIDSHIP = $52' \cdot 6''$

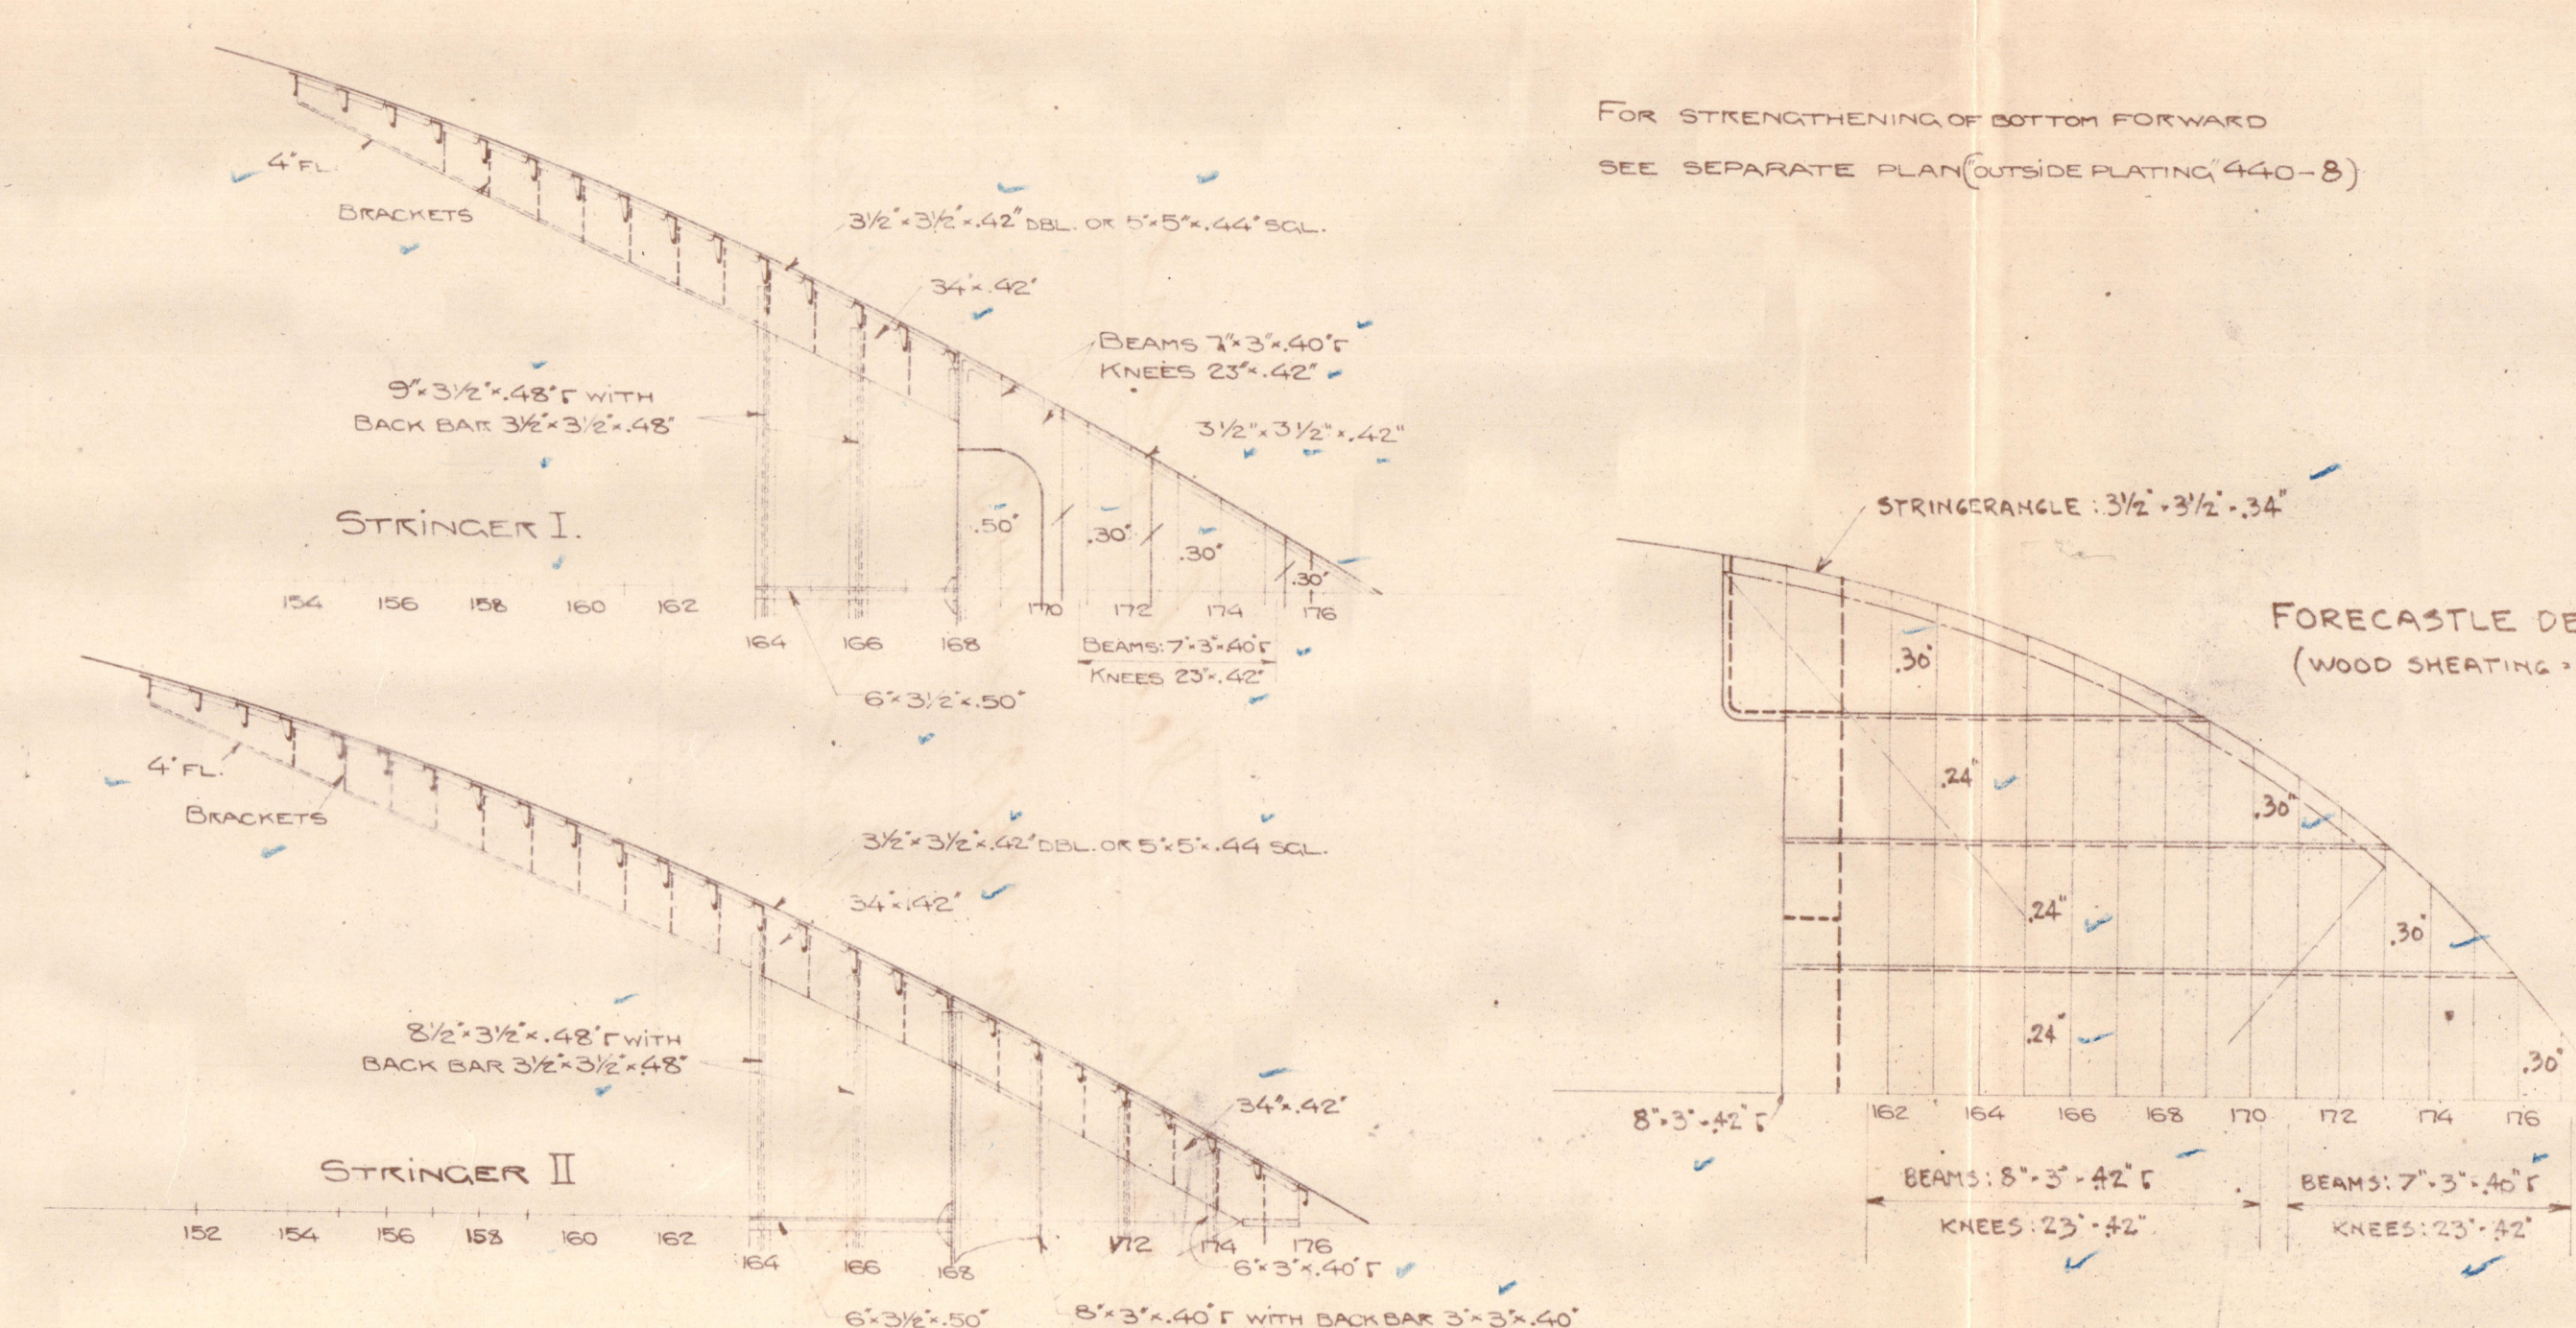

29-6-18. S.S. N^o 442 & 443.

~~S.S. N^o 440, 441~~

PROFILE & DECK PLANS

SCALE $\frac{1}{100}$

6-12-16

