



Messrs. Angus & Taylor Hobbs &
No 200

Mid: Sec: as built
Sp. War Island
Indt report No 10209.

1812

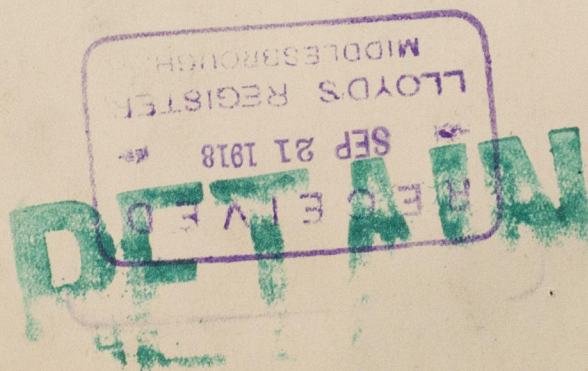

W1291-0051 2020

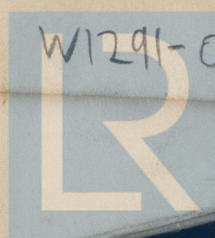

Lloyd's Register
Foundation