
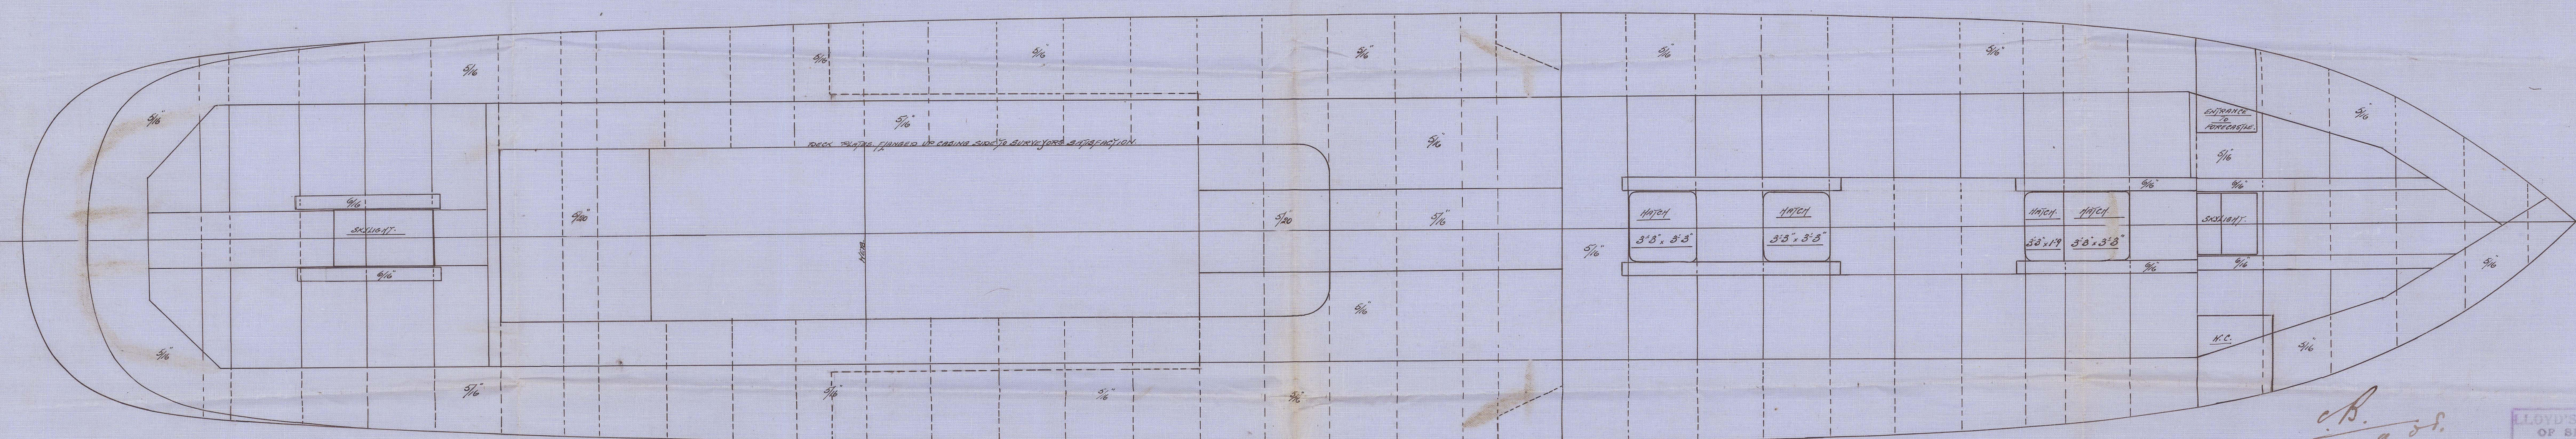


N^o 445

$$\text{SCALE } \frac{1}{4} = 1 \text{ FOOT.}$$


22.9.08.
29.9.08.

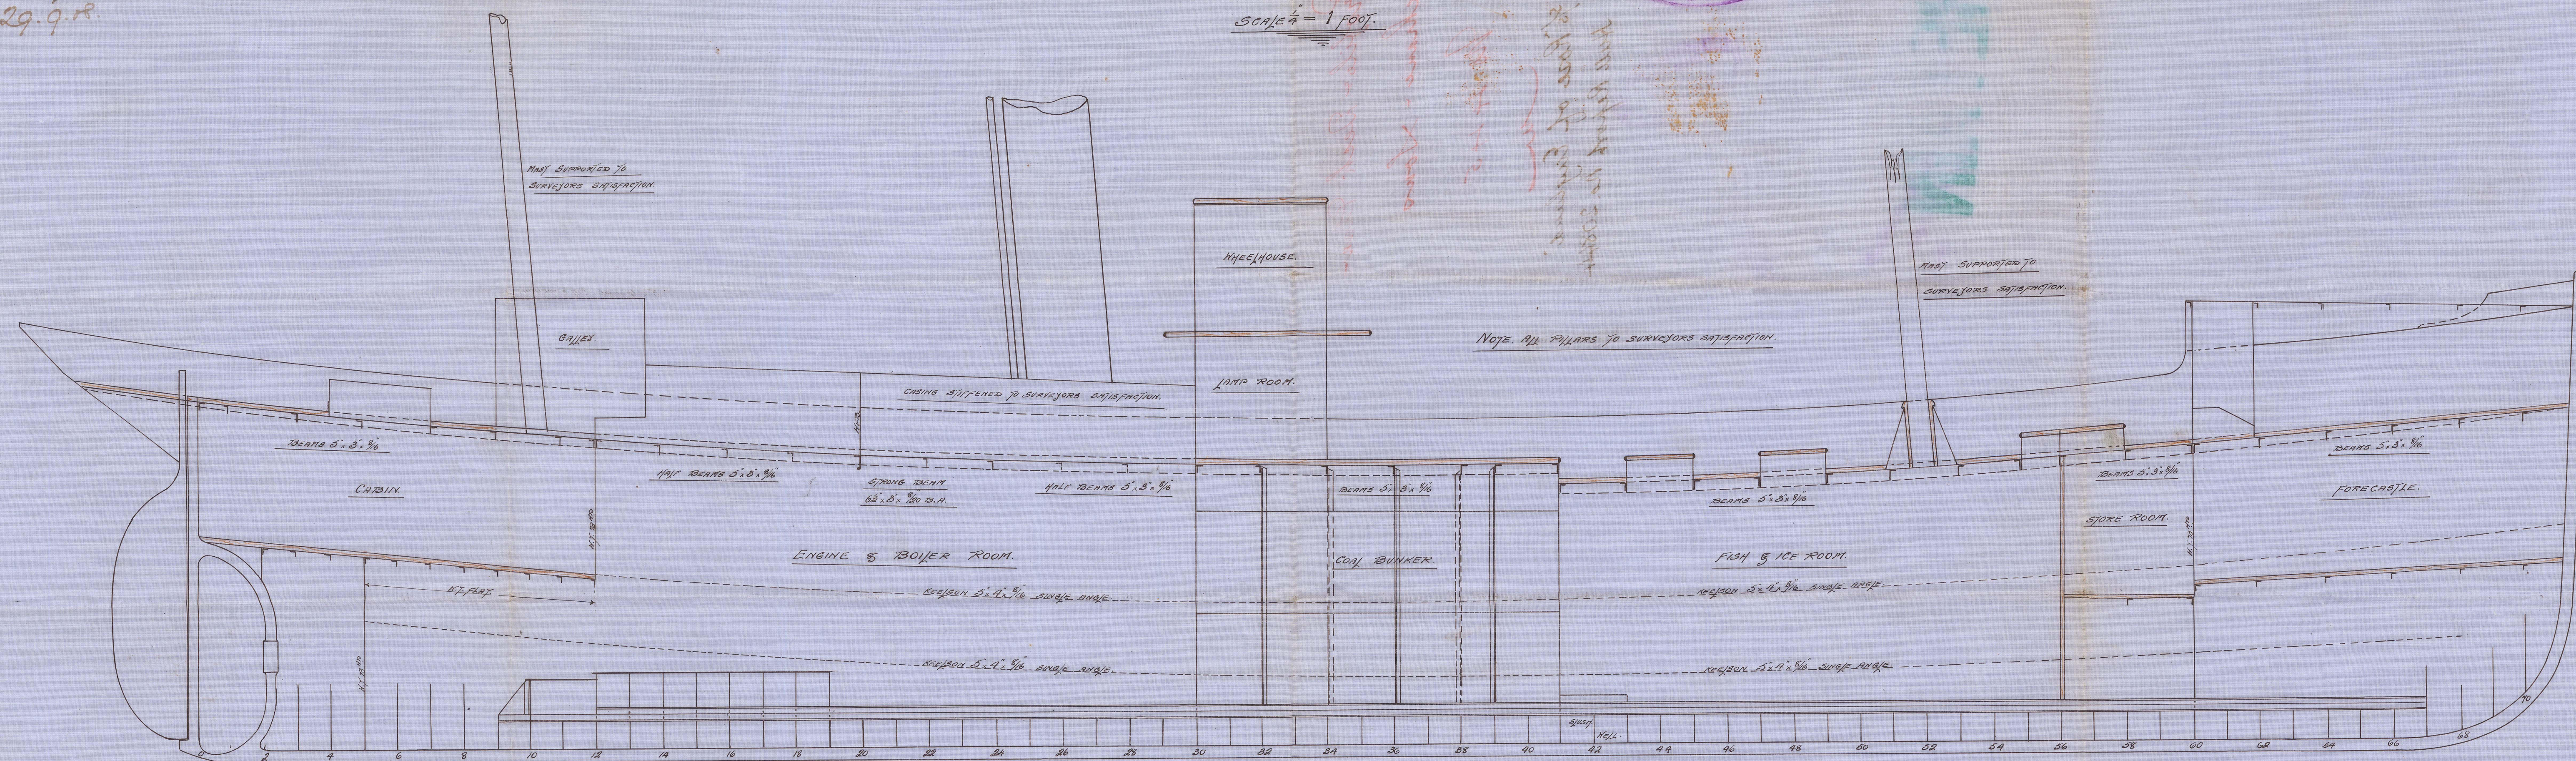

C.B.
22.9.5

LLOYD'S REGISTER
 OF SHIPPING.
 21 SEP. 1908
 + HULL +

DECK PLAN

2/4/2

Profile & Deck Plan
Cochrane & Sons

No. 445

s/s Rose of England
Hull Report No. 20844



REPLAN



© 2021

Lloyd's Register
Foundation

W1294-0068