

LLOYDS NUMERALS

$\frac{1}{2}$ BREADTH = 11.68
 $\frac{1}{2}$ GIRTH = 21.28
 DEPTH = 13.5
 $46.43 \cdot 1^{\text{ST}} \text{ No}$
 $\frac{135.48}{27858}$ LENGTH
 19572
 23215
 13929
 4643
 $62894078 = 2^{\text{ND}} \text{ No}$

$$\frac{L}{B} = 5.84$$
$$\frac{L}{D} = 10.03$$

EQUIPMENT


ONE ANCHOR	64 ¹ / ₄ CENT	EX STOCK
"	53 ¹ / ₄	"
"	34	"
120 FATHOMS	18 ¹ / ₂	CABLE
60 "	6	HAWSER
60 "	5	WARD

MIDSHIP SECTION

DIMENSIONS 136'-8"BP x 23'-6"EX x 13'-0"MLD

STEEL TO CLASS 100A1. FOR FISHING PURPOSES

SCALE $\frac{1}{2}'' = 1 \text{ FOOT.}$

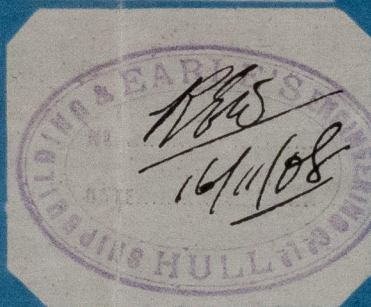

C.B.
18. 11. 08.



Earle's Co.

No. 555.

Midship Section.

$\frac{1}{2}$ Yokohama

Hull Report No. 211/3.

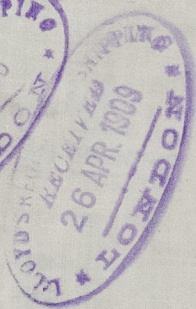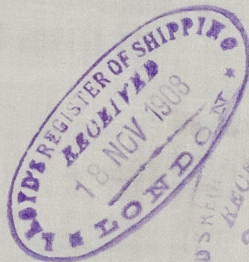

© 2021

Lloyd's Register
Foundation

W1297-0085