


# HEIMEI MARU STRUCTURAL ARRANGEMENT SCALE 1/8 IN TO ONE FT

OSAKA IRONWORKS  
NOV 3 1910  
大阪鐵工會


PROFILE




POOP DECK PLAN

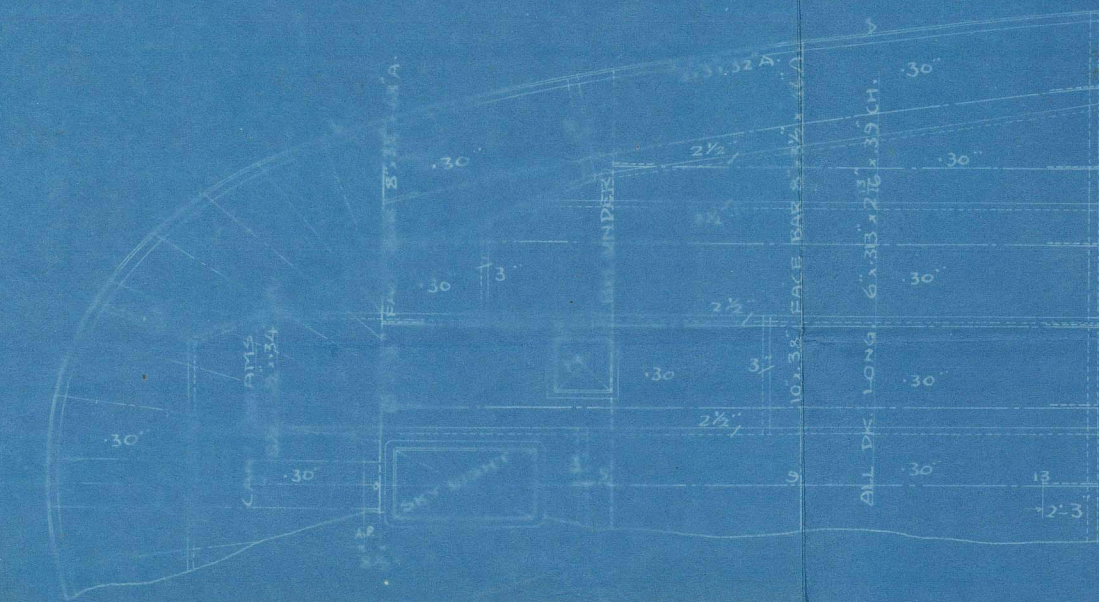


BRIDGE DECK PLAN

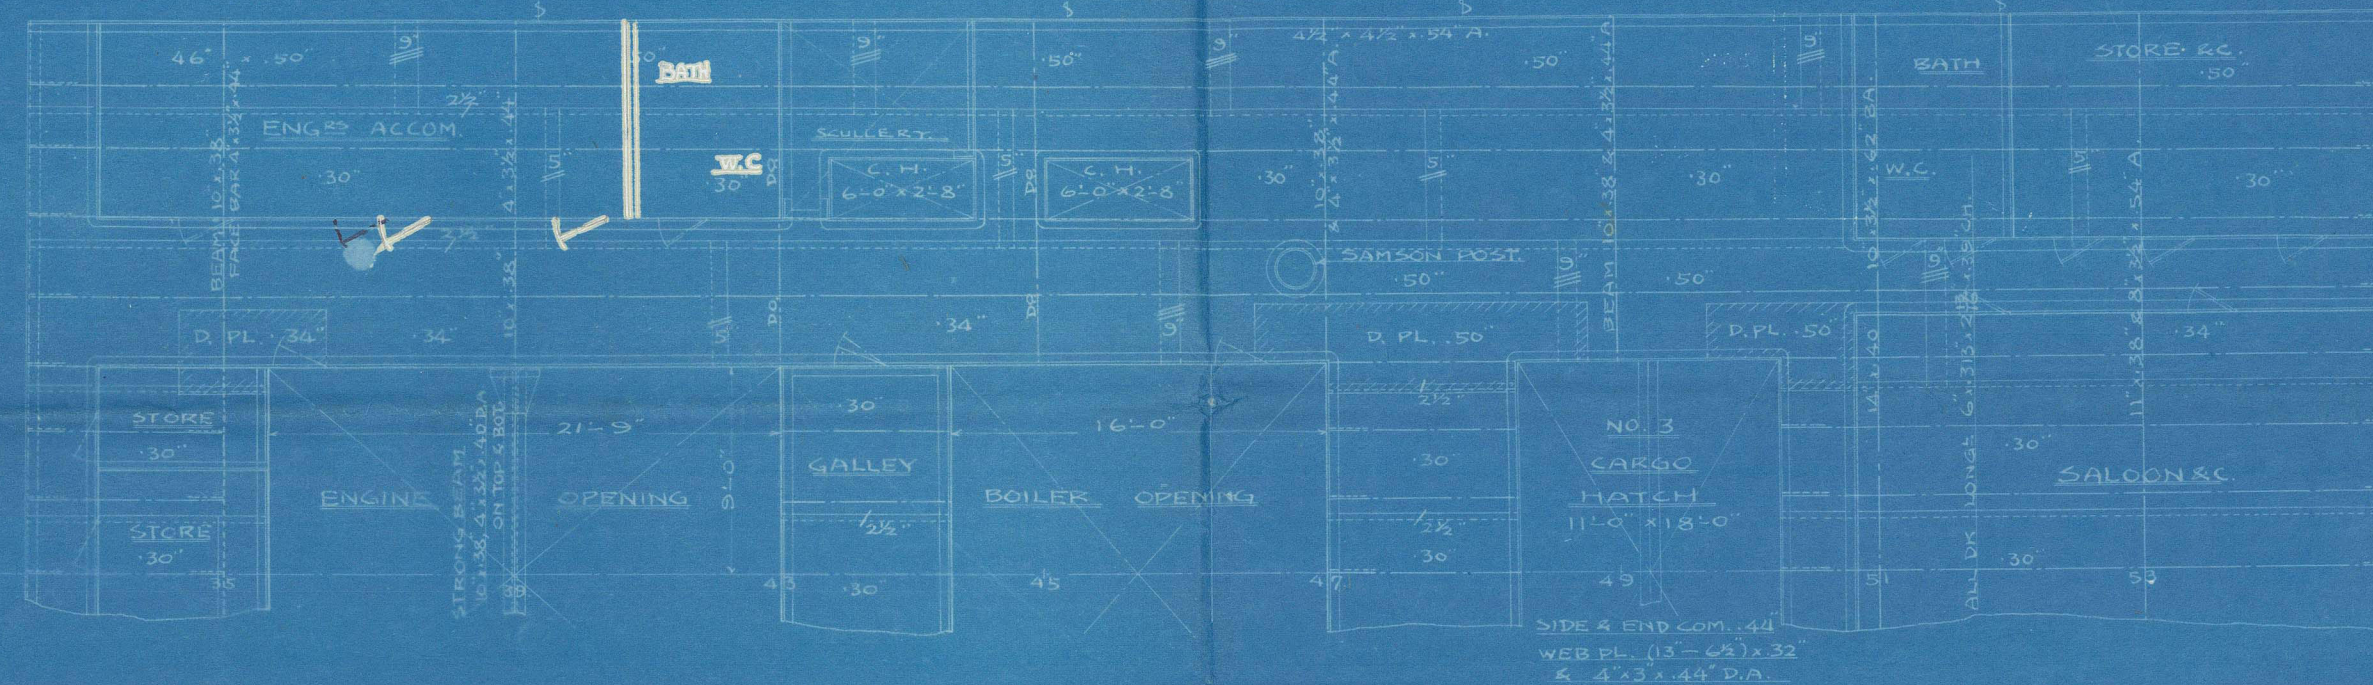


FORECASTLE DECK PLAN

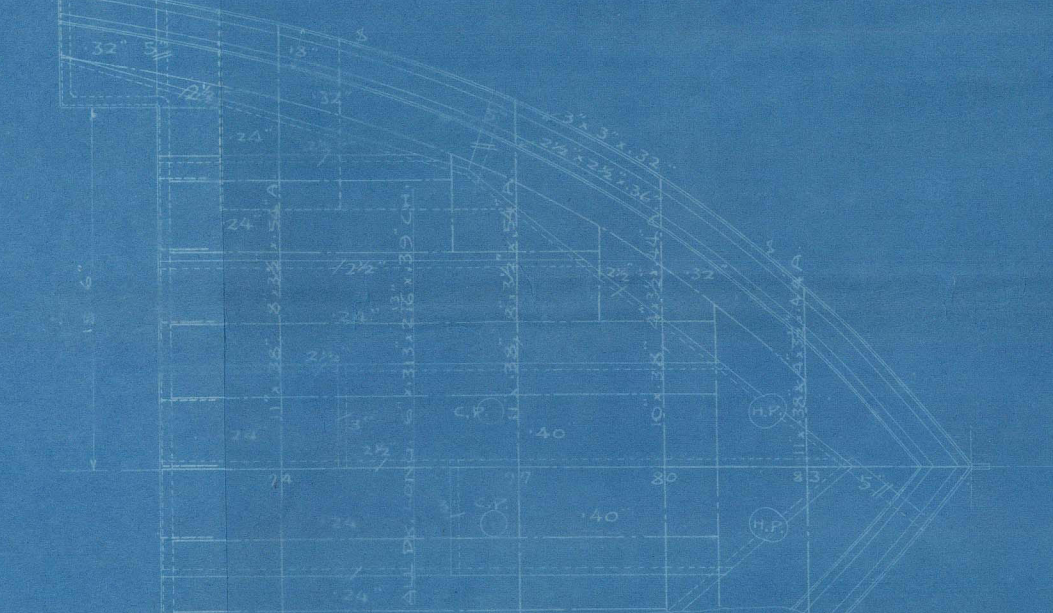

SHELTER DECK PLAN

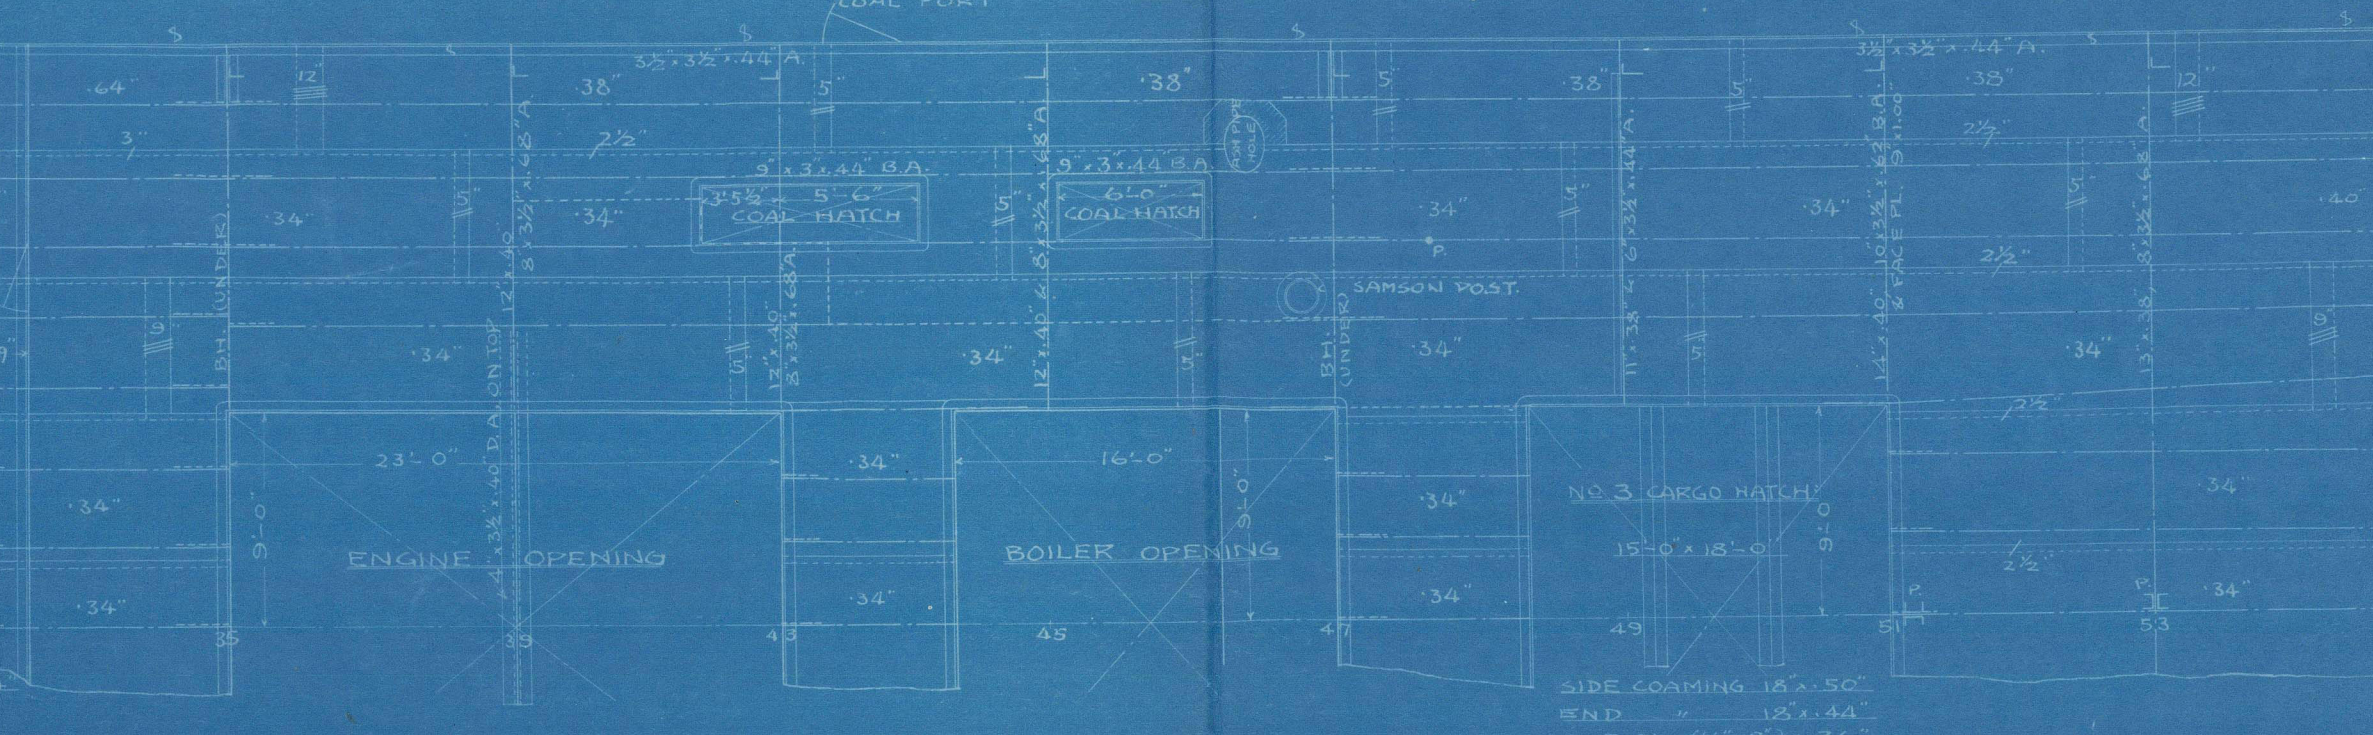

UPPER DECK PLAN

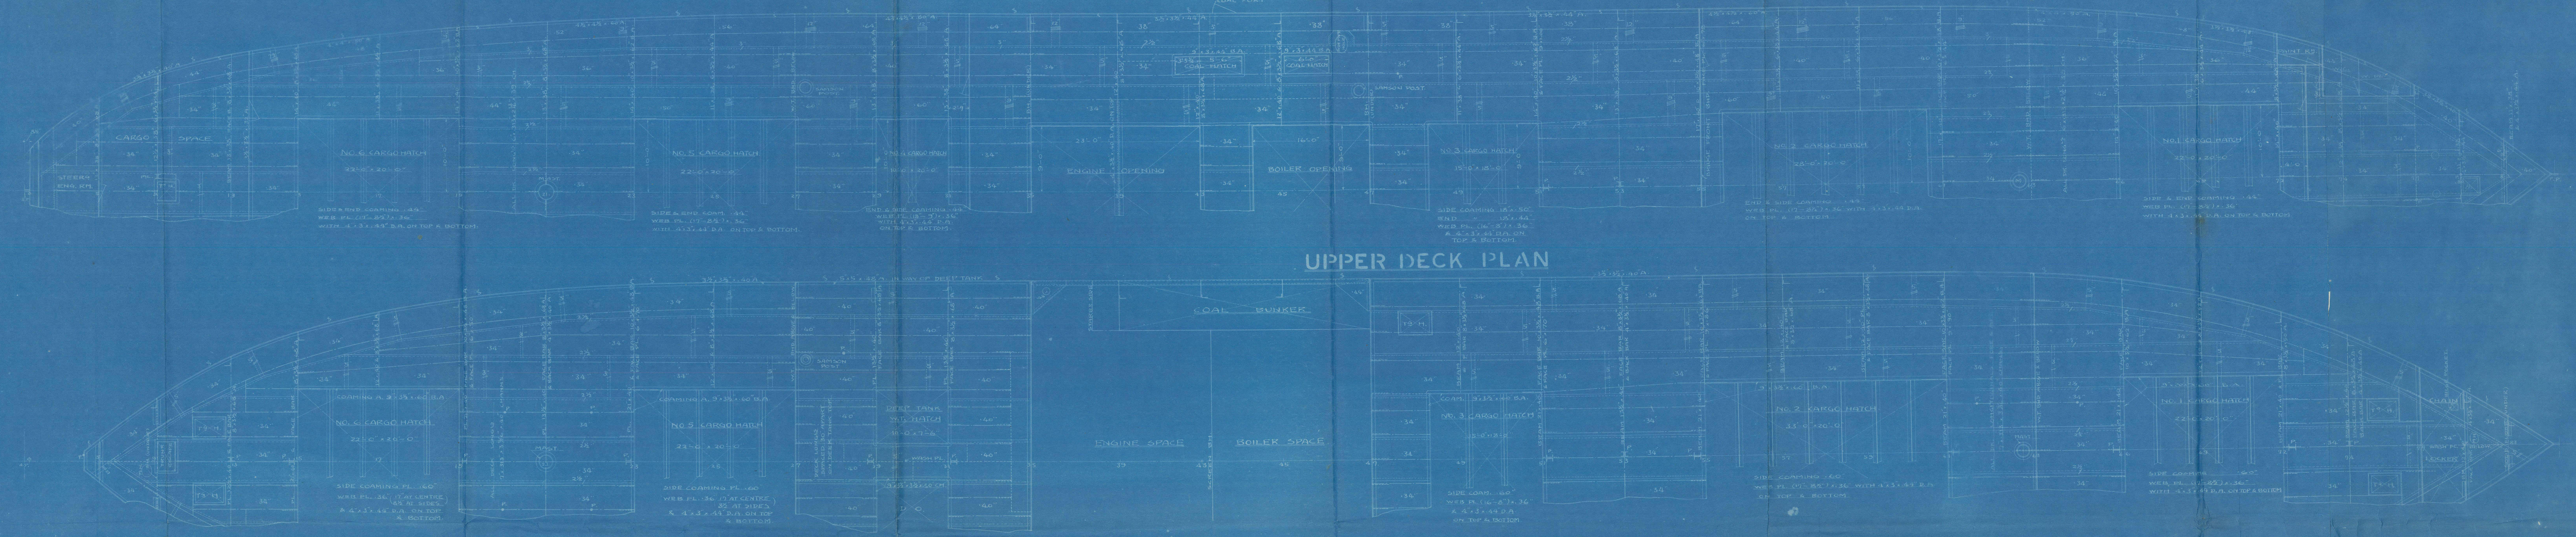



RETAIN

No 962. S.S. "Hei Mei Nam"

Structural arrangement.



© 2021

Lloyd's Register  
Foundation  
W1297-0107