

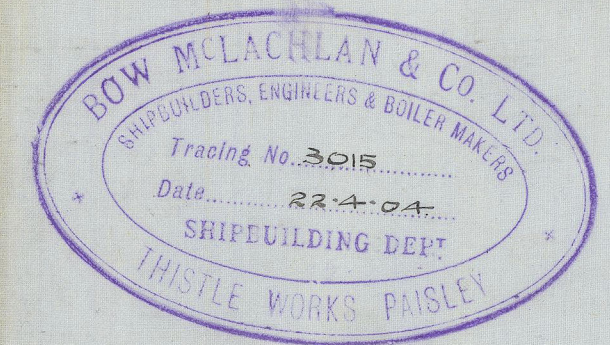
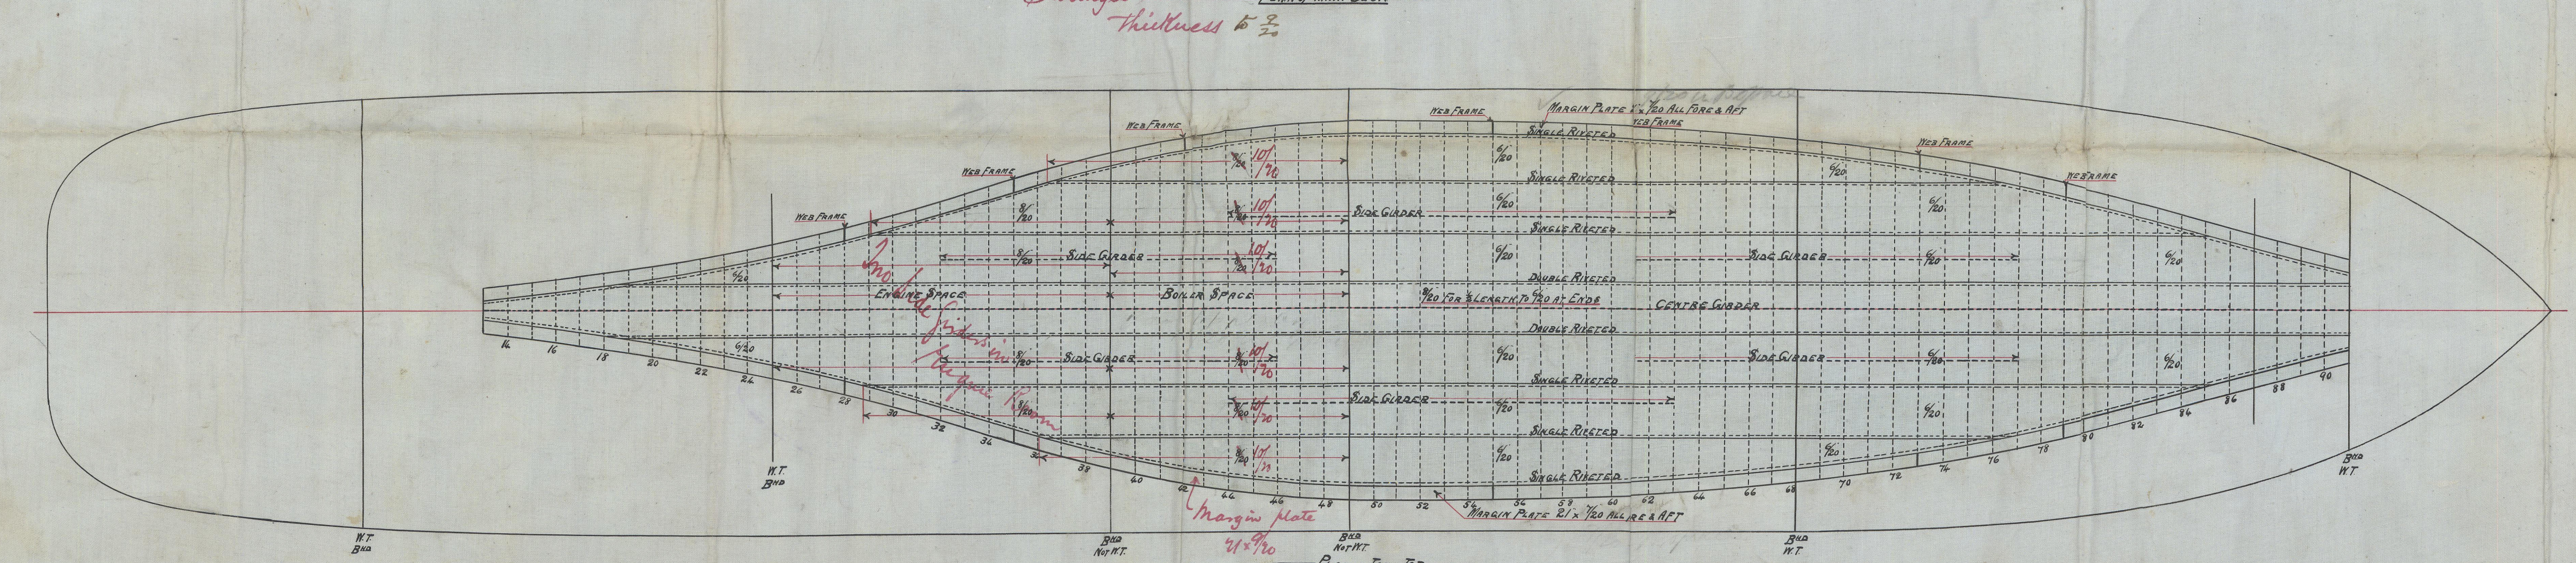
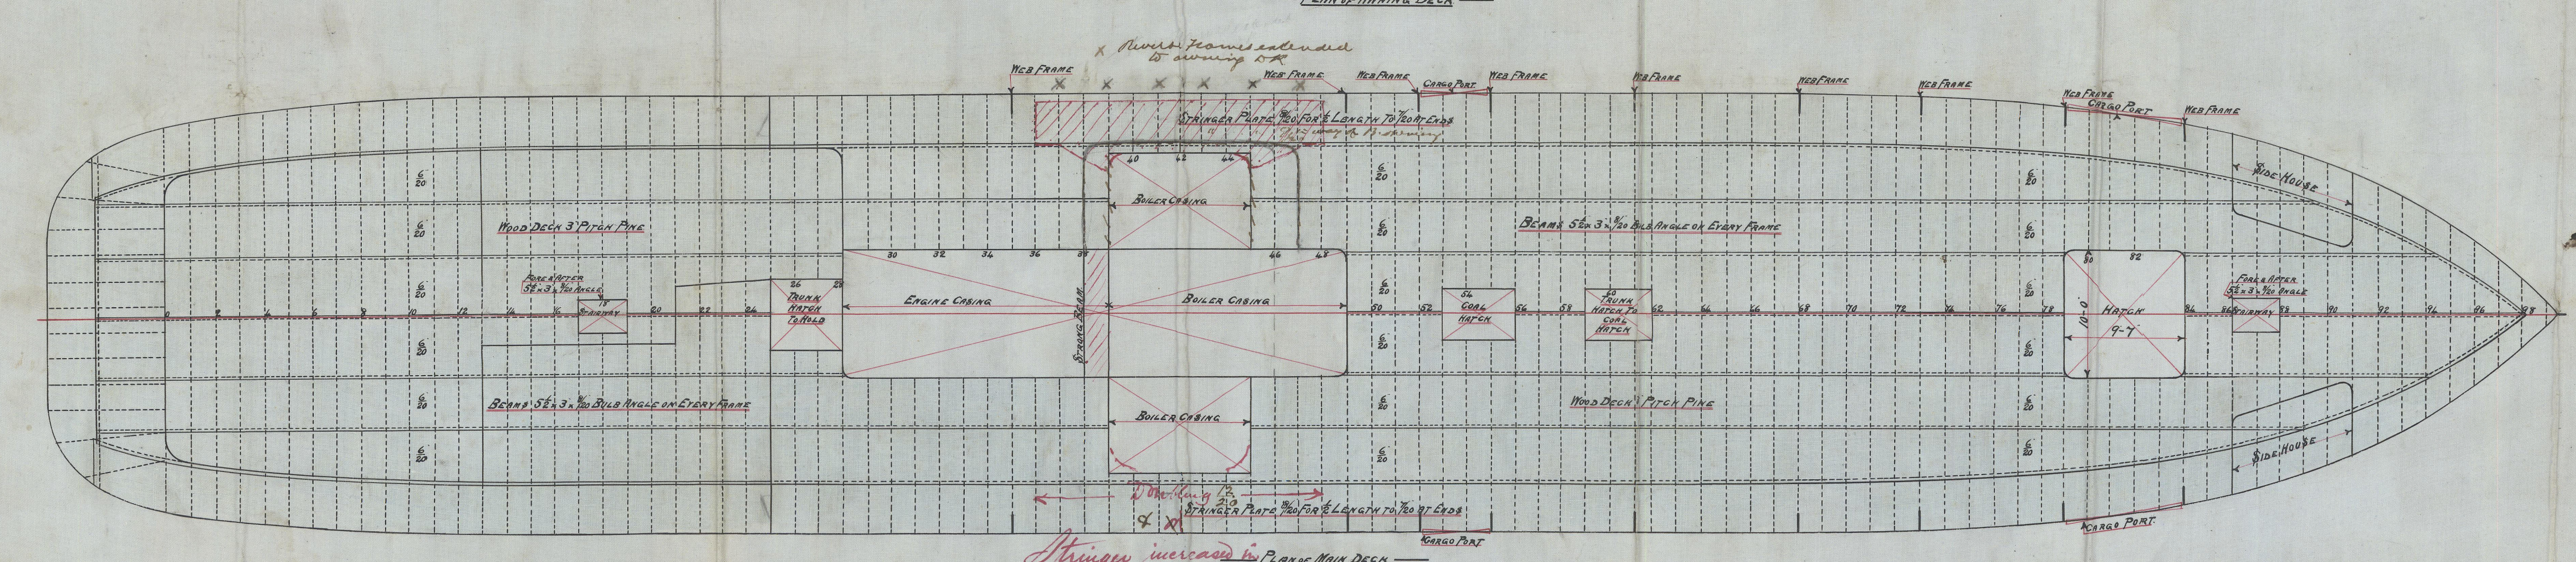


SINGLE SCREW STEAMER No 177
 LONGITUDINAL SECTION & DECK PLANS
 DIMENSIONS 192'-0" x 35'-0" x 17'-3" MLD
 SCALE 1/8" = 1 FOOT
 TO CLASS 100 A1 SPECIAL SURVEY
 FIRST RIVETING DECK

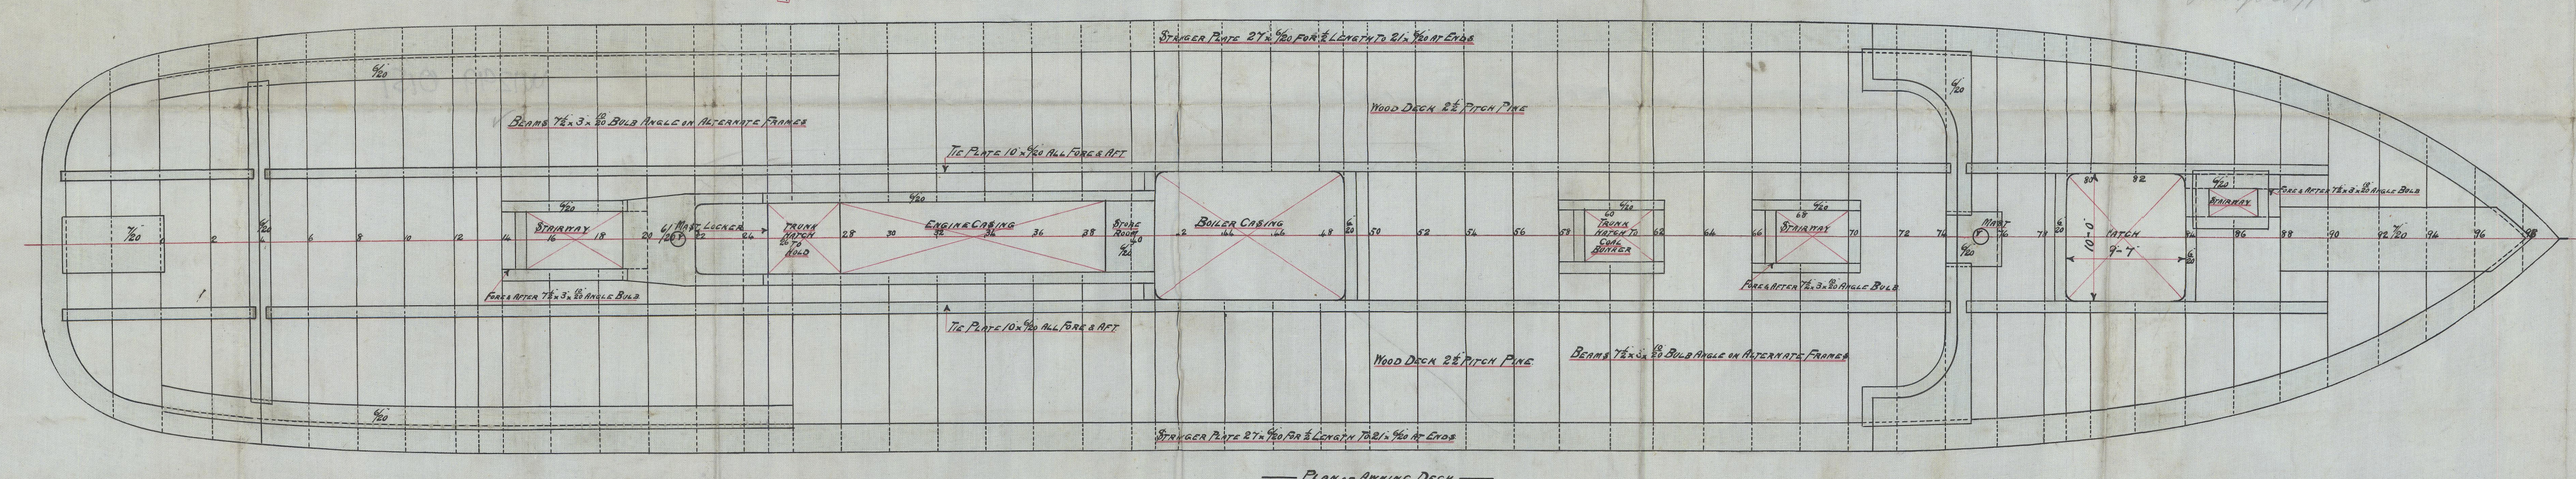


28.4.04

80' S.S. at R/R as per plan

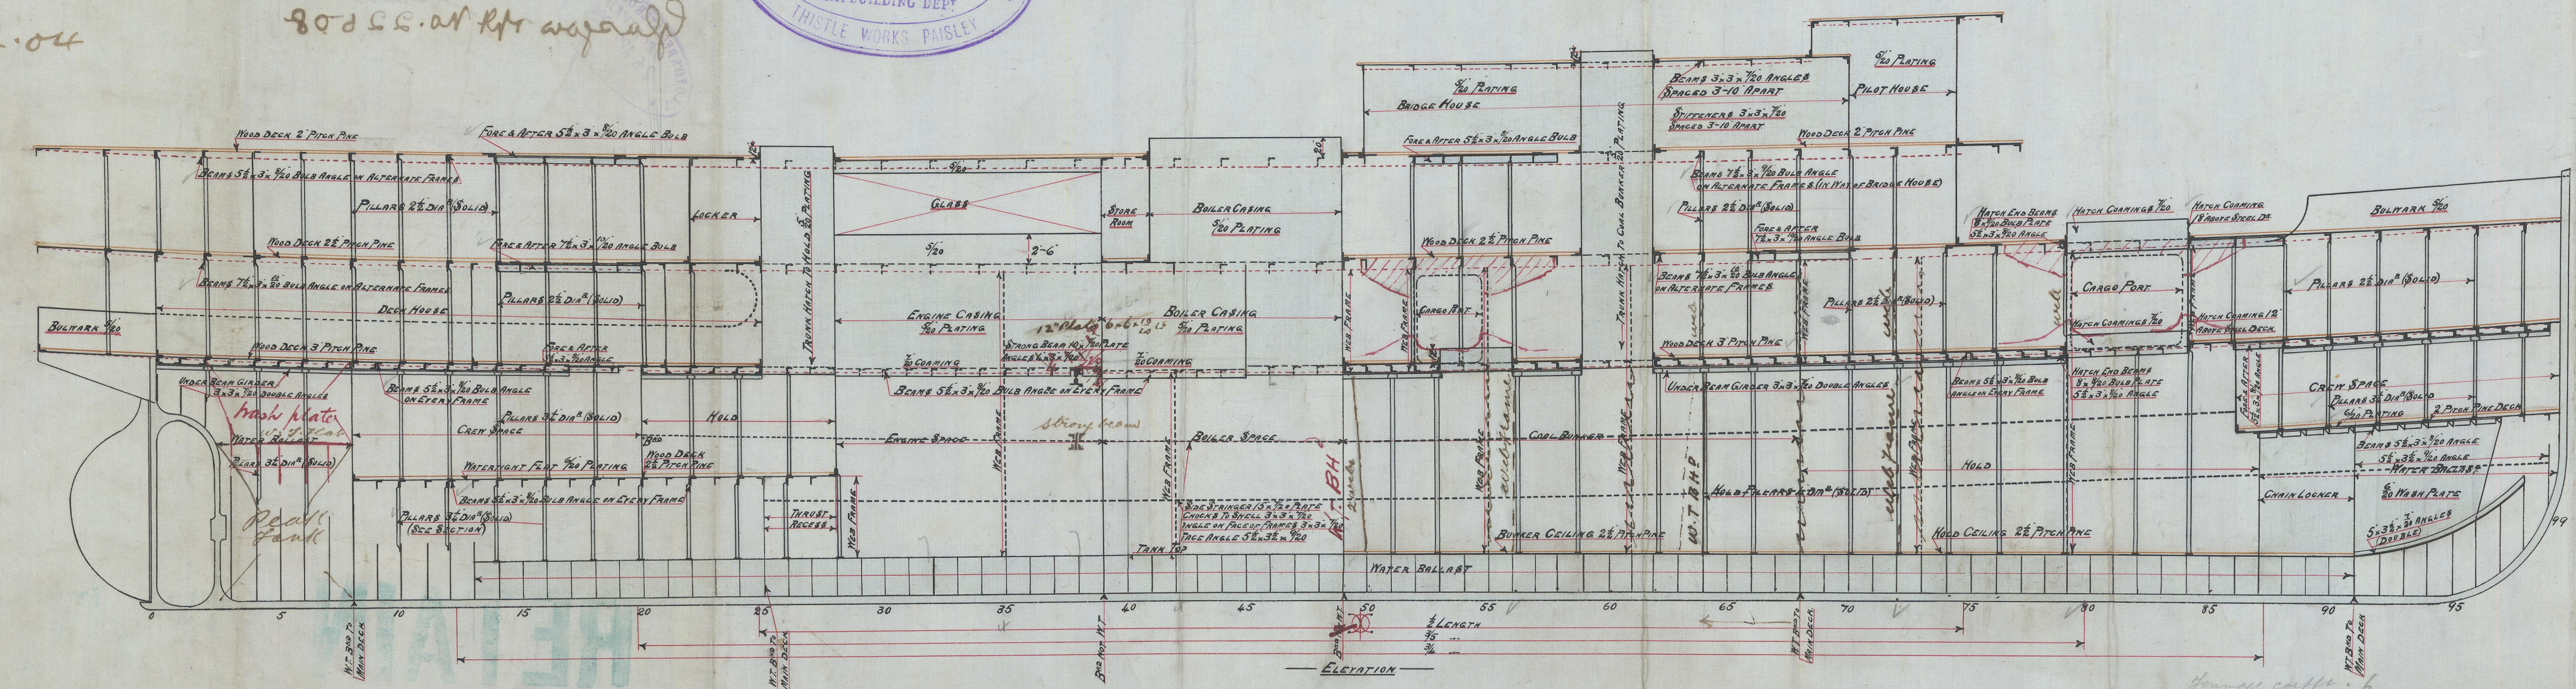

NOTE
 ORDERS TO BE ARRANGED IN ENGINE SPACE
 TO SUIT ENGINEERS REQUIREMENTS



28/4/04

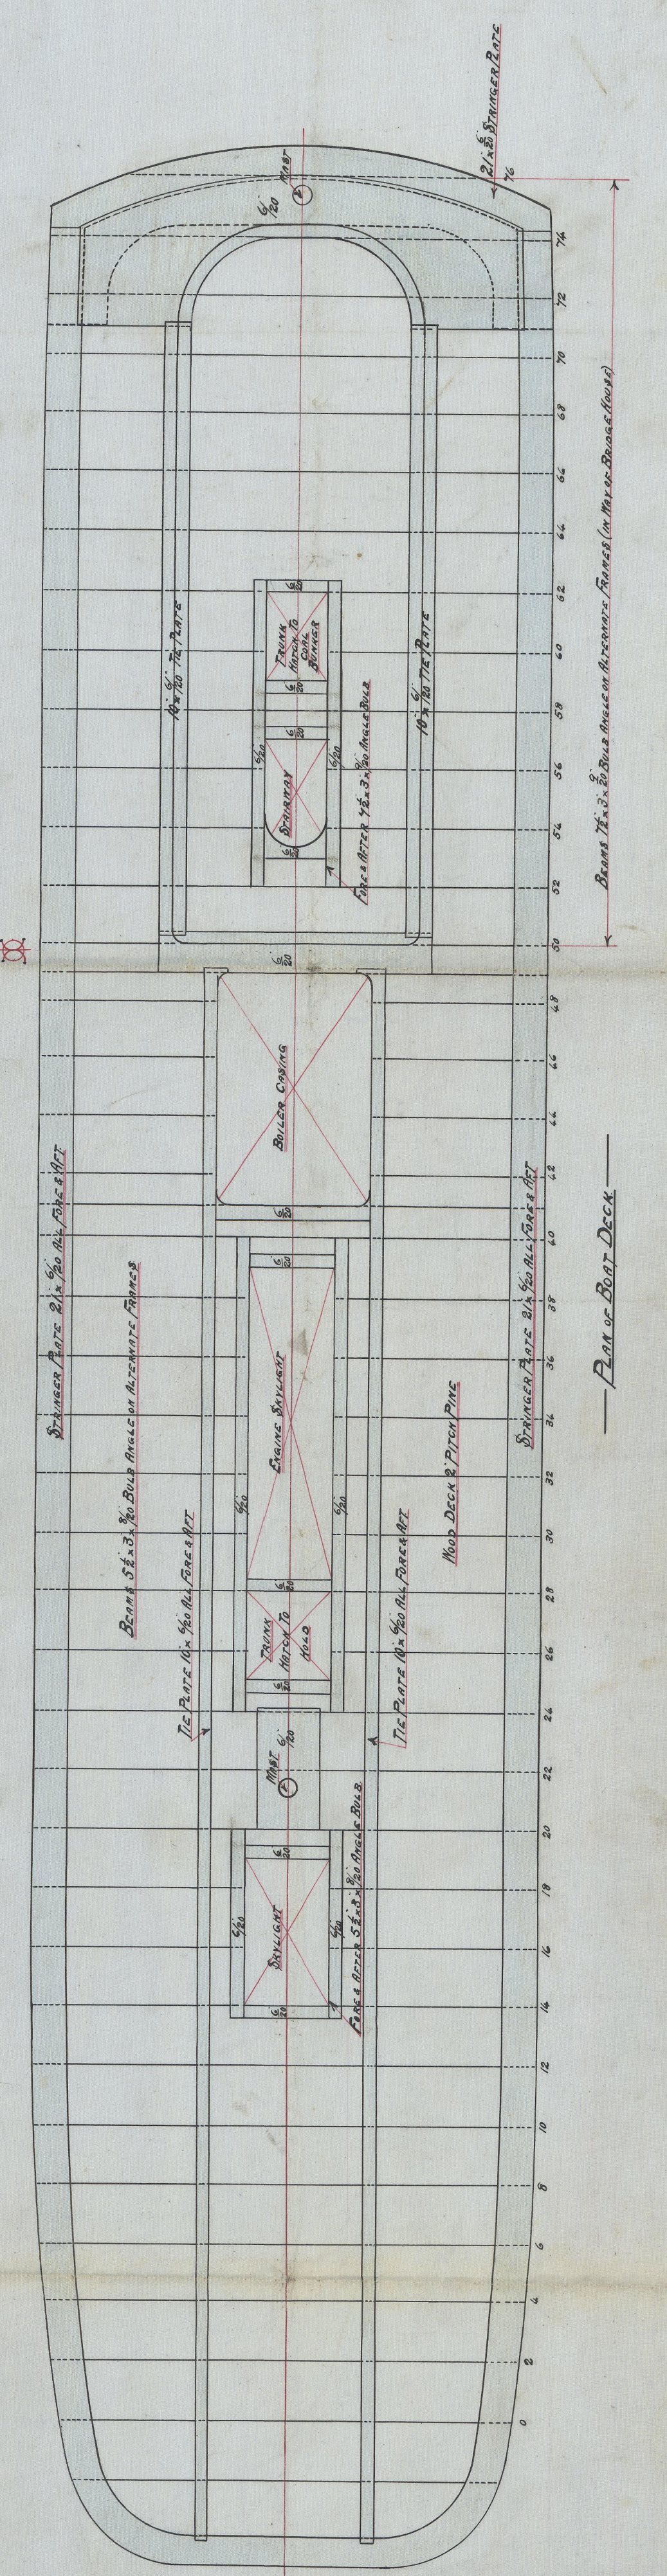

Messrs Bow M'Lachlan
No 177

Profile & Deck Plans

S.S. "Carnarvon"
Glasgow No. 22508

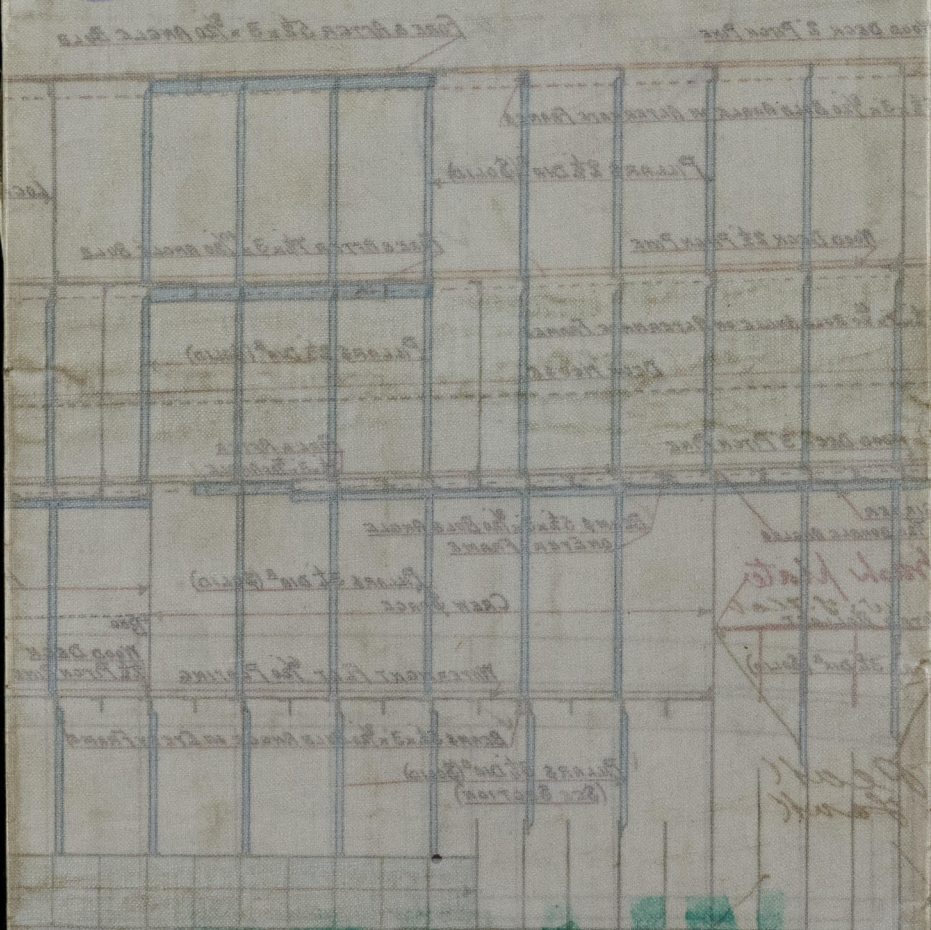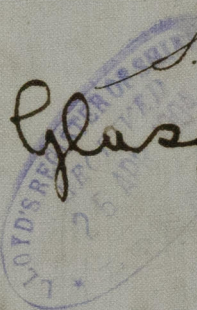

© 2020

Lloyd's Register
Foundation

W1249 0157