

# Steel Motorvessel to carry oil in bulk.

190'0" x 32'6" x 14'0"

Scale 1/8" = 1 Foot

Class 100 A Lloyd's




BN° 696.



VN° 5259.

22, 12, 13

16.1.14  
17.2.14  
10.3.14  
18.3.14  
2.4.14  
9.4.14  
4.5.14  
20.5.14

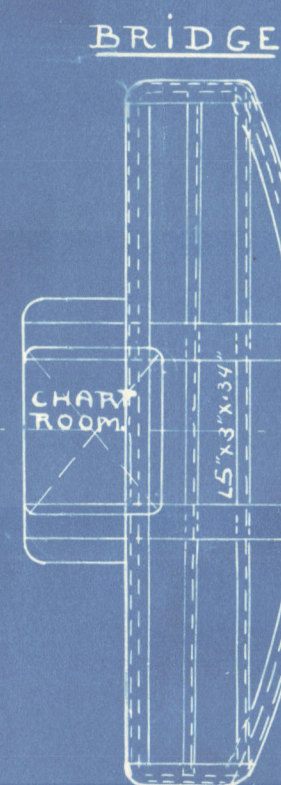


DECK ON ACCOMMODATION

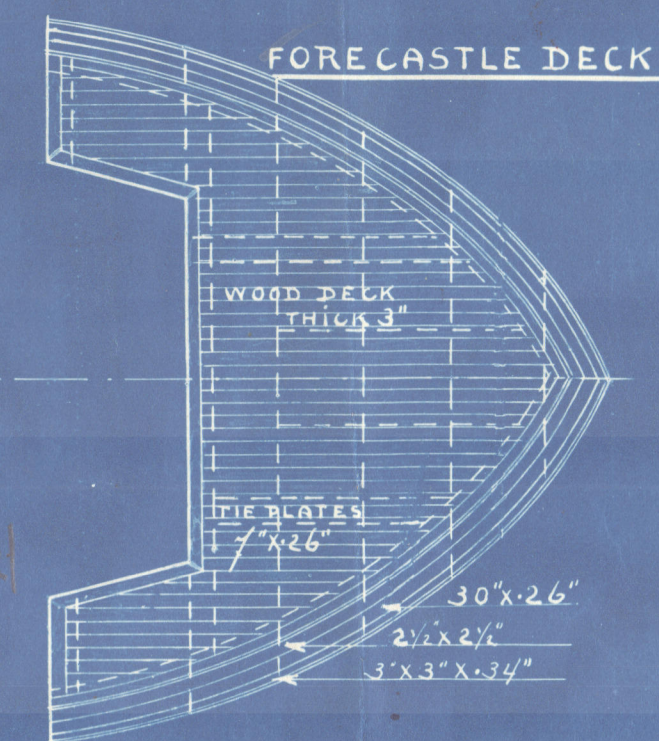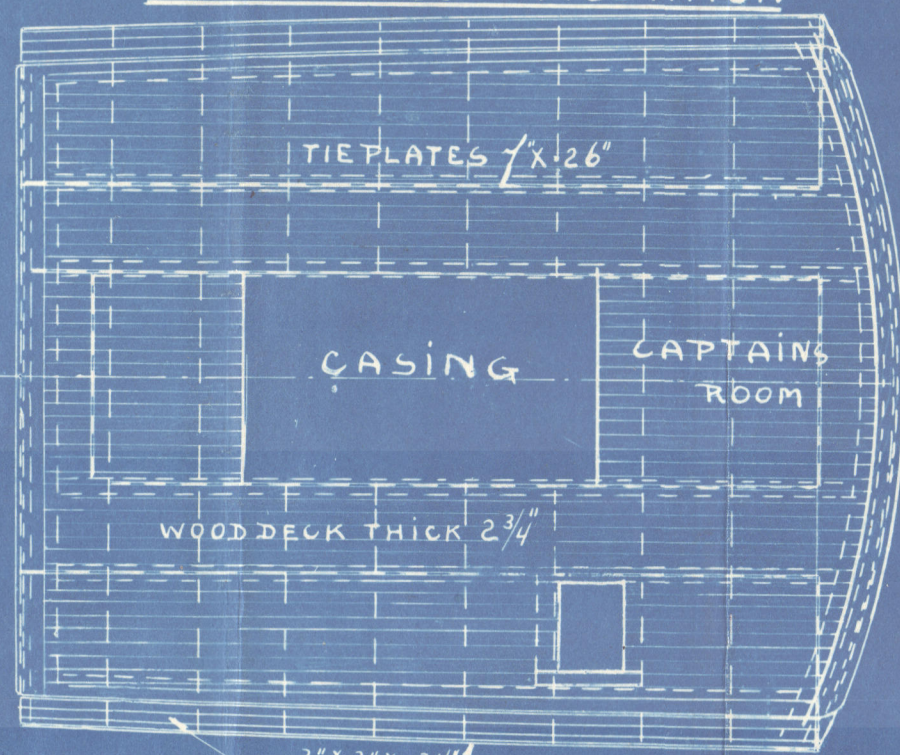


3 lower  
100% to be fitted as per  
and  
POOP NOT WISHER BY THE OWNERS

Please see pumping  
plan for water of  
tank

Longitudinal section

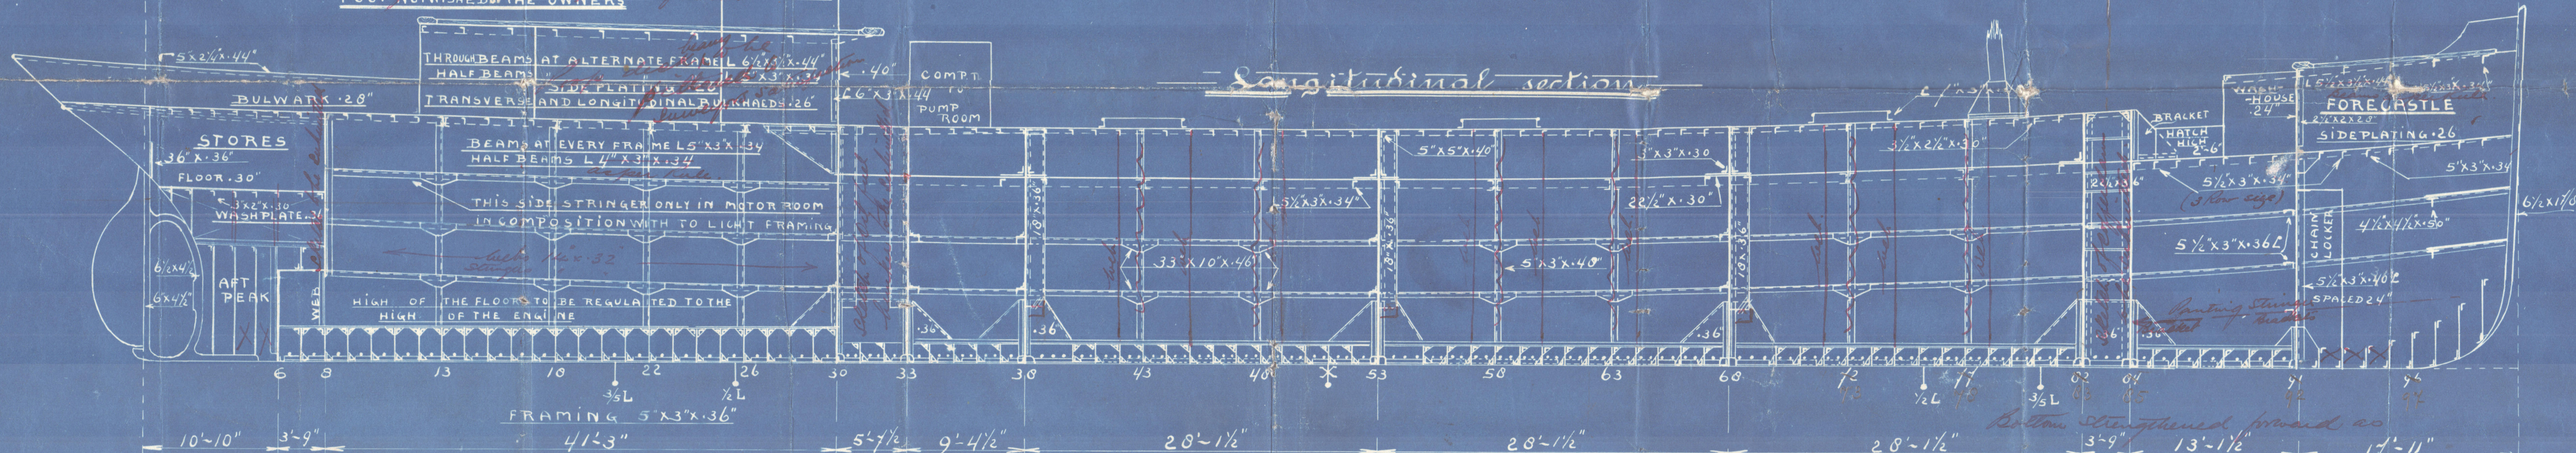


Upper and Trunk deck

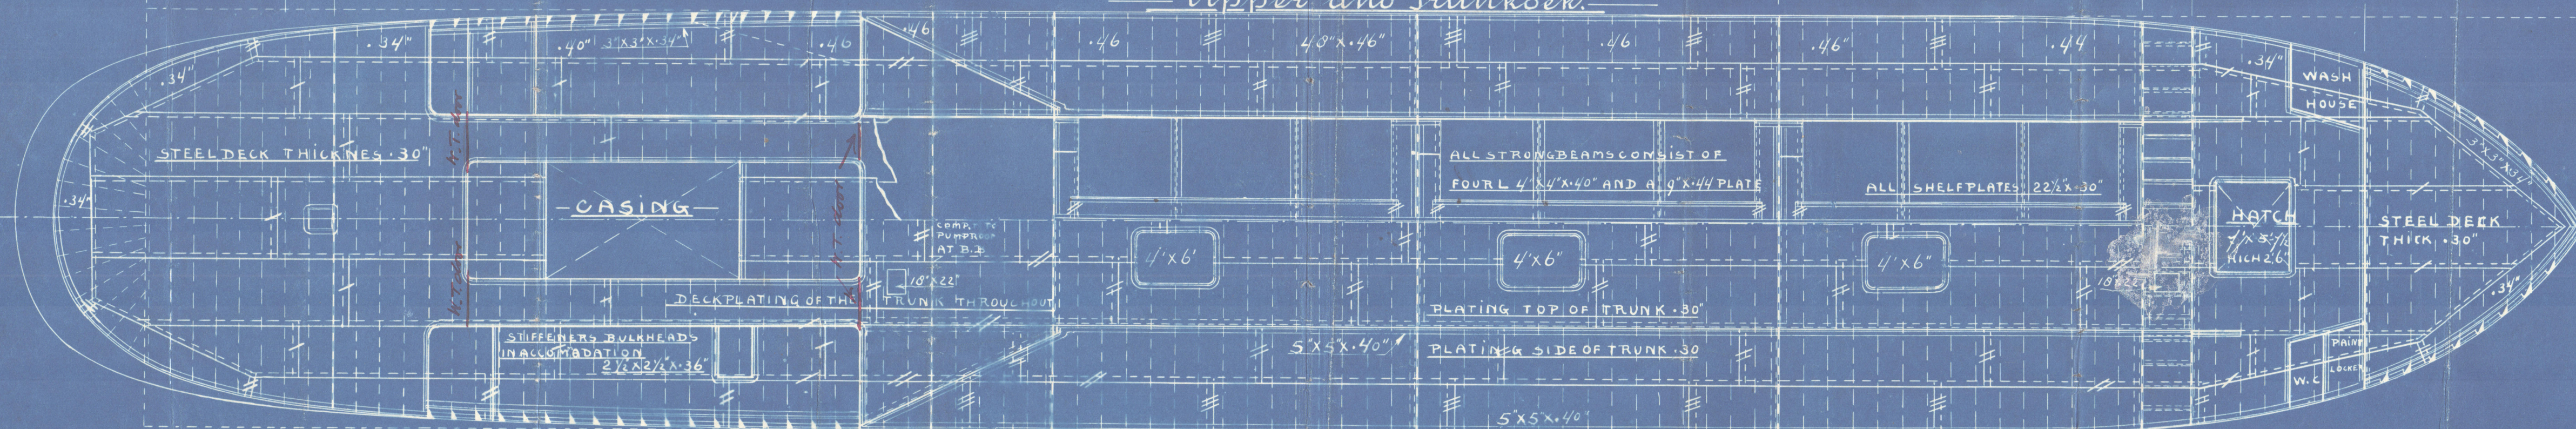

Sketch showing construction of  
Transverse bulkheads to be submitted

Section below Upper deck

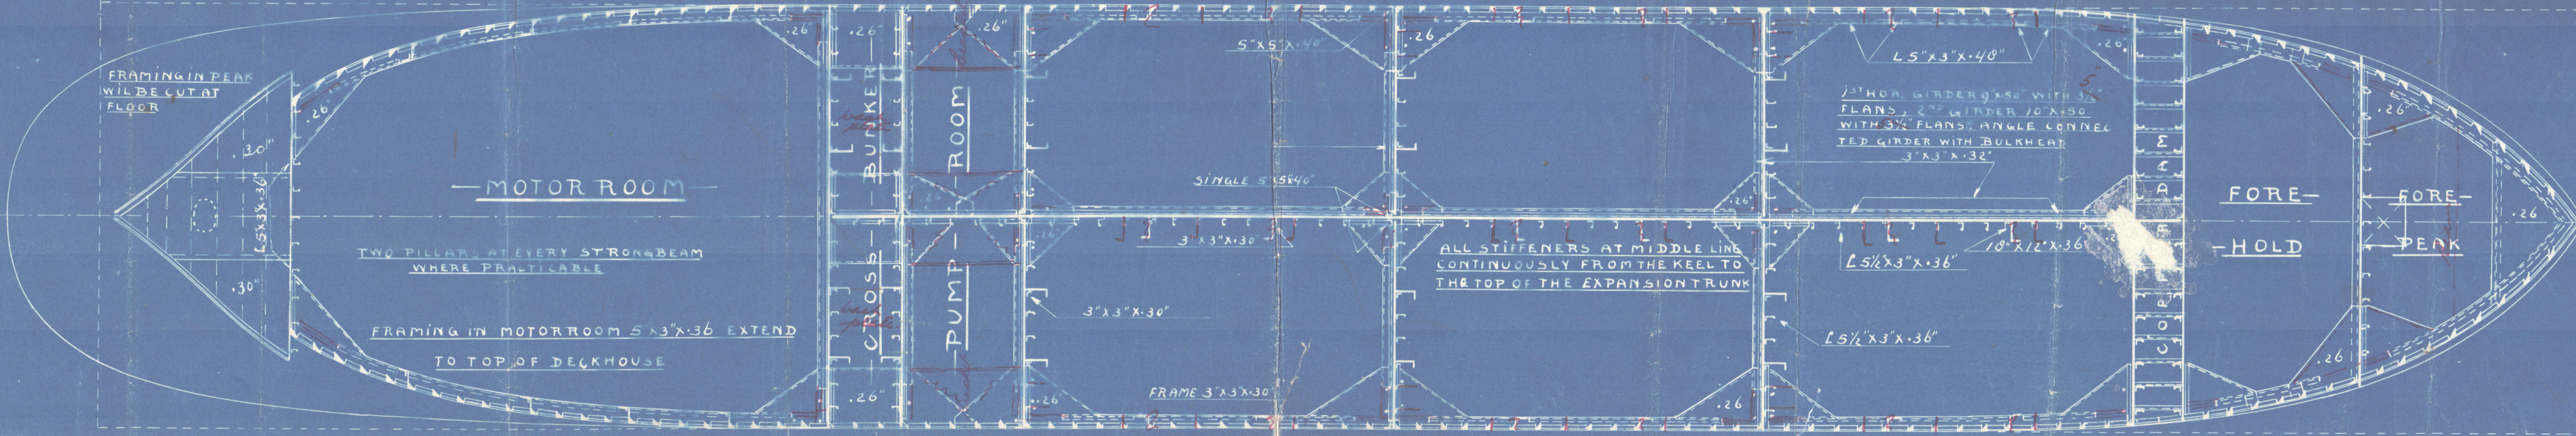

C.T.  
16.1.14





W1300-0276






© 2020

Lloyd's Register  
Foundation



*Peter Gal.*  
*696*

*Motorship*  
*"Lara"*  
*Profile and*  
*Deckplan*  
*Rotterdam Report*  
*No 9394*

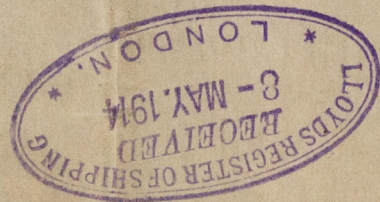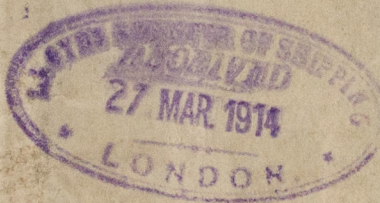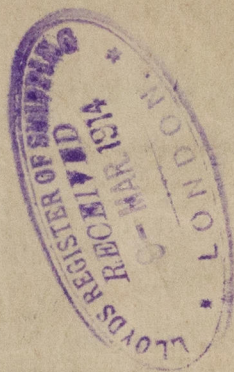

W1300-0276



© 2020

Lloyd's Register  
Foundation