



5-6-19

THE SCANTLING & DETAILS OF CONSTRUCTION NOTED  
HEREON ARE SUBMITTED WITH THE UNDERSTANDING THAT  
THEY ARE THE MINIMUM WHICH WILL BE ACCEPTED  
FOR CLASS, & IF NOT THEY ARE TO BE AMENDED  
ERRORS & OMISSIONS EXCEPTED.

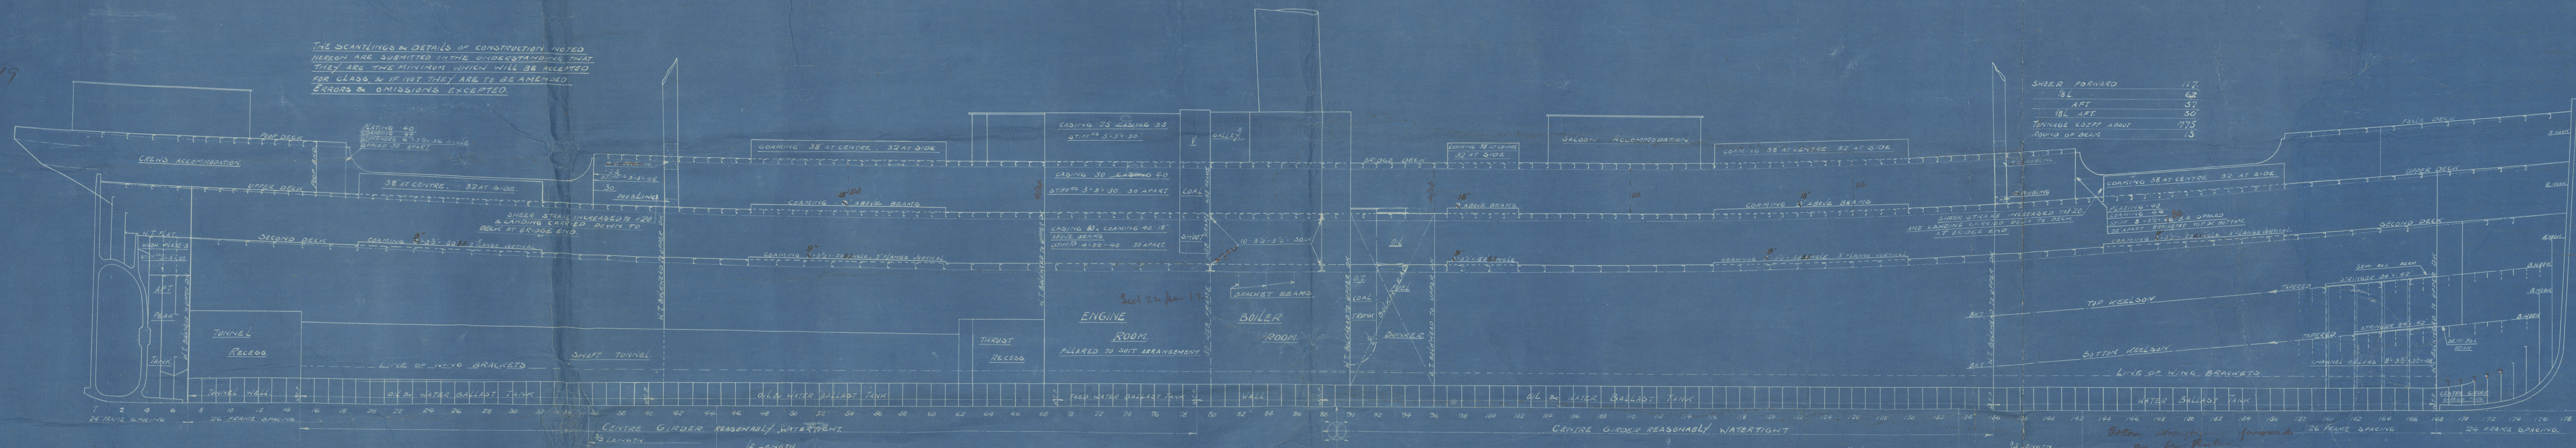


SHEER FORWARD	117
81	62
AFT	57
81 AFT	50
DOWNHILL CORNER ABOUT	175
ROUND ON BEAMS	13

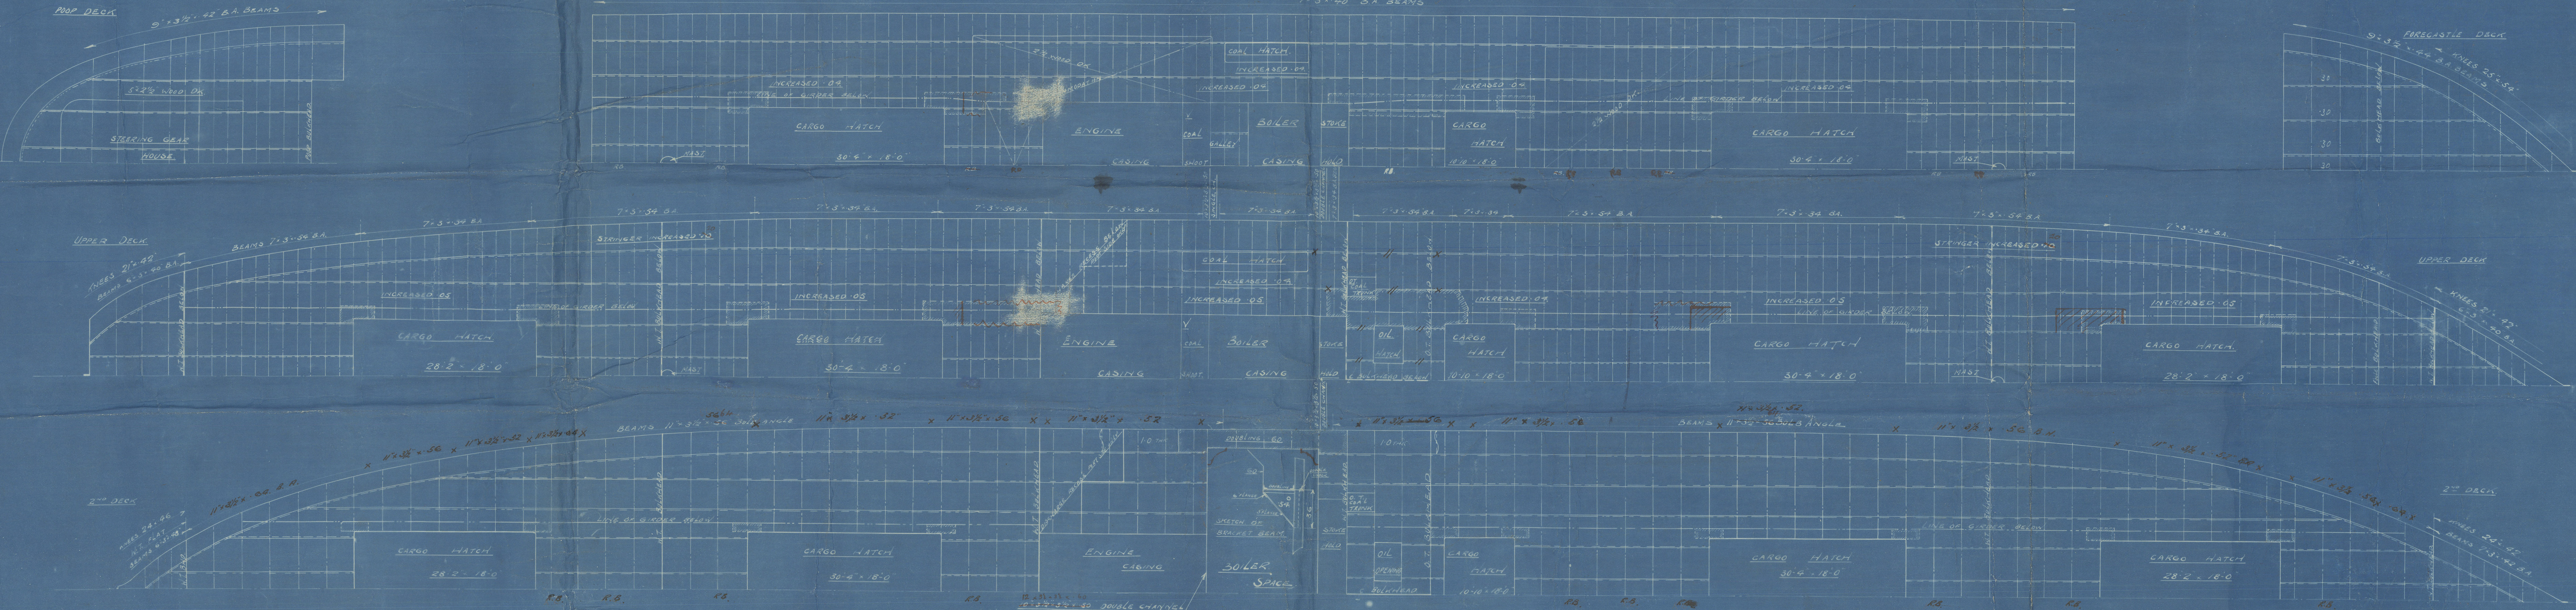

LONGITUDINAL & DECK PLANS

SHIP 724  
DIMENSIONS 385'0" B.P. 51'9" M.P. 52'0" EXT. 29'3" M.P.  
TO CLASS 100 A1 at Lloyd's Special Survey  
Scale 1/8" = ONE FOOT

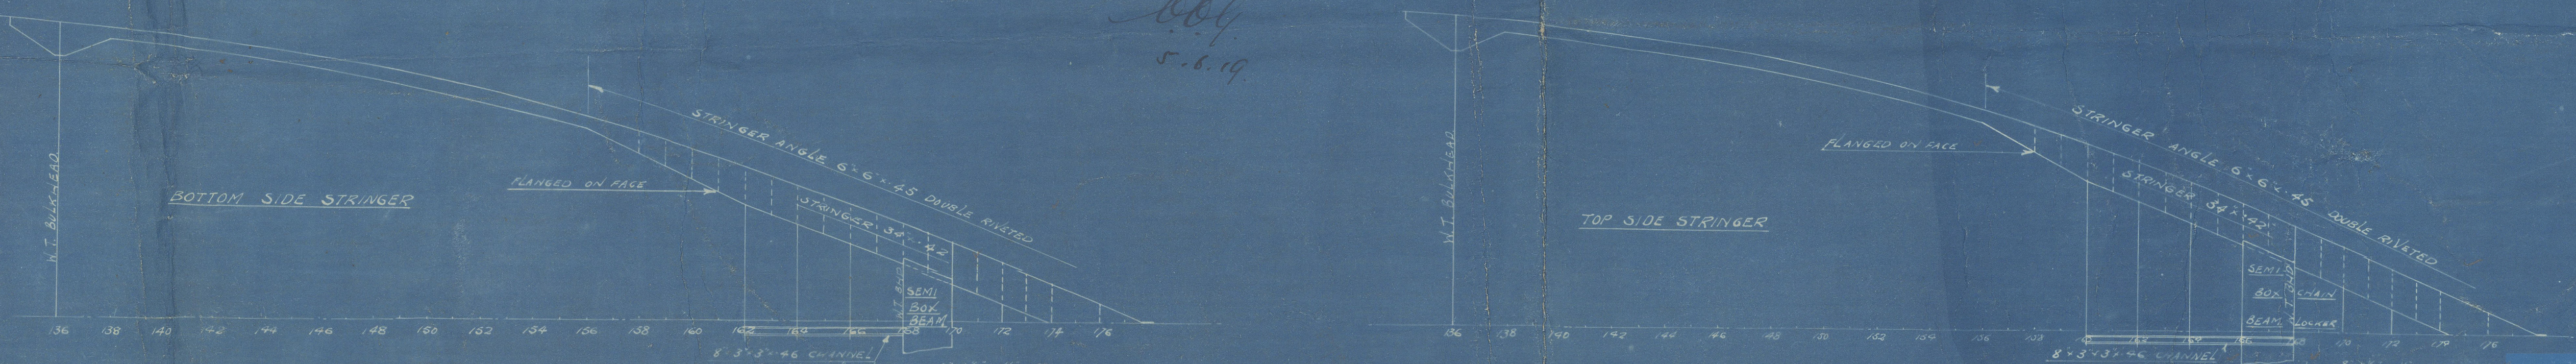



Johnston Limited  
No. 724  
Organizational Plan



SS Hoegstad  
Ink pt 6 Vol no 17683

MAIN



© 2020

Lloyd's Register  
Foundation

W1301-0067