


27" 44" 73" x 180" / 48"

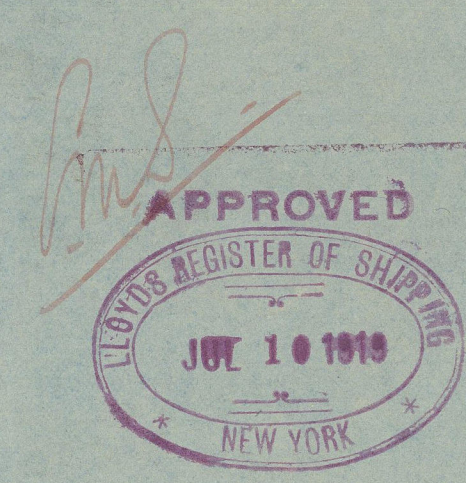

MARK	Nº REQ ^d	MATERIAL	DESCRIPTION	PATTERN	REMARKS
A	3	Forged steel	Crank shaft Ends		Sketch 67/1
B	2	"	"		"
C	1	"	"		"
D	3	"	Pins		"
E	6	"	Web		"
F	6	Steel	shaft End keys		"
G	6	"	Pin Keys		"
H	18	Forged steel	shaft Coupling bolts		"
J	18	"	"	Nuts	"

CRANK SHAFT

SCALE 1" = 1'-0"

Quantities marked for One (1) Ship only
Finish all over

Prints issued to
following depts
Eng shop

DRAWING Nº 67/31

THE JOHN INGLIS CO LTD
TORONTO CANADA

ENGINE Nº

© 2020
Lloyd's Register
Foundation