

✓ / A
✓ /

<u>EQUIPMENT NO 5060.</u>				
✓ 1	ANCHOR	5 ¹ / ₄	CWTS,	EX STOCK.
✓ 1	"	4 ³ / ₄	"	" "
✓ 1	"	2 ¹ / ₂	"	" "
✓ 90	FATHOMS	1"	STUD LINK CHAIN.	
✓ 60	"	6"	HAWSER.	
✓ 60	"	4 ¹ / ₂ "	WARP.	

DIMS:- 116'-9" BP x 21'-6" x 13'-0" M.L.G.


TO GLASS 100 A.I. LLOYDS. FOR FISHING PURPOSES.

FLUSH OK. NO ERECTIONS.

SCALE $\frac{1}{2}$ IN. = 1 FT.

$$\frac{L}{B} = 5.38 \checkmark$$

$$L/D = 8.57. \checkmark$$

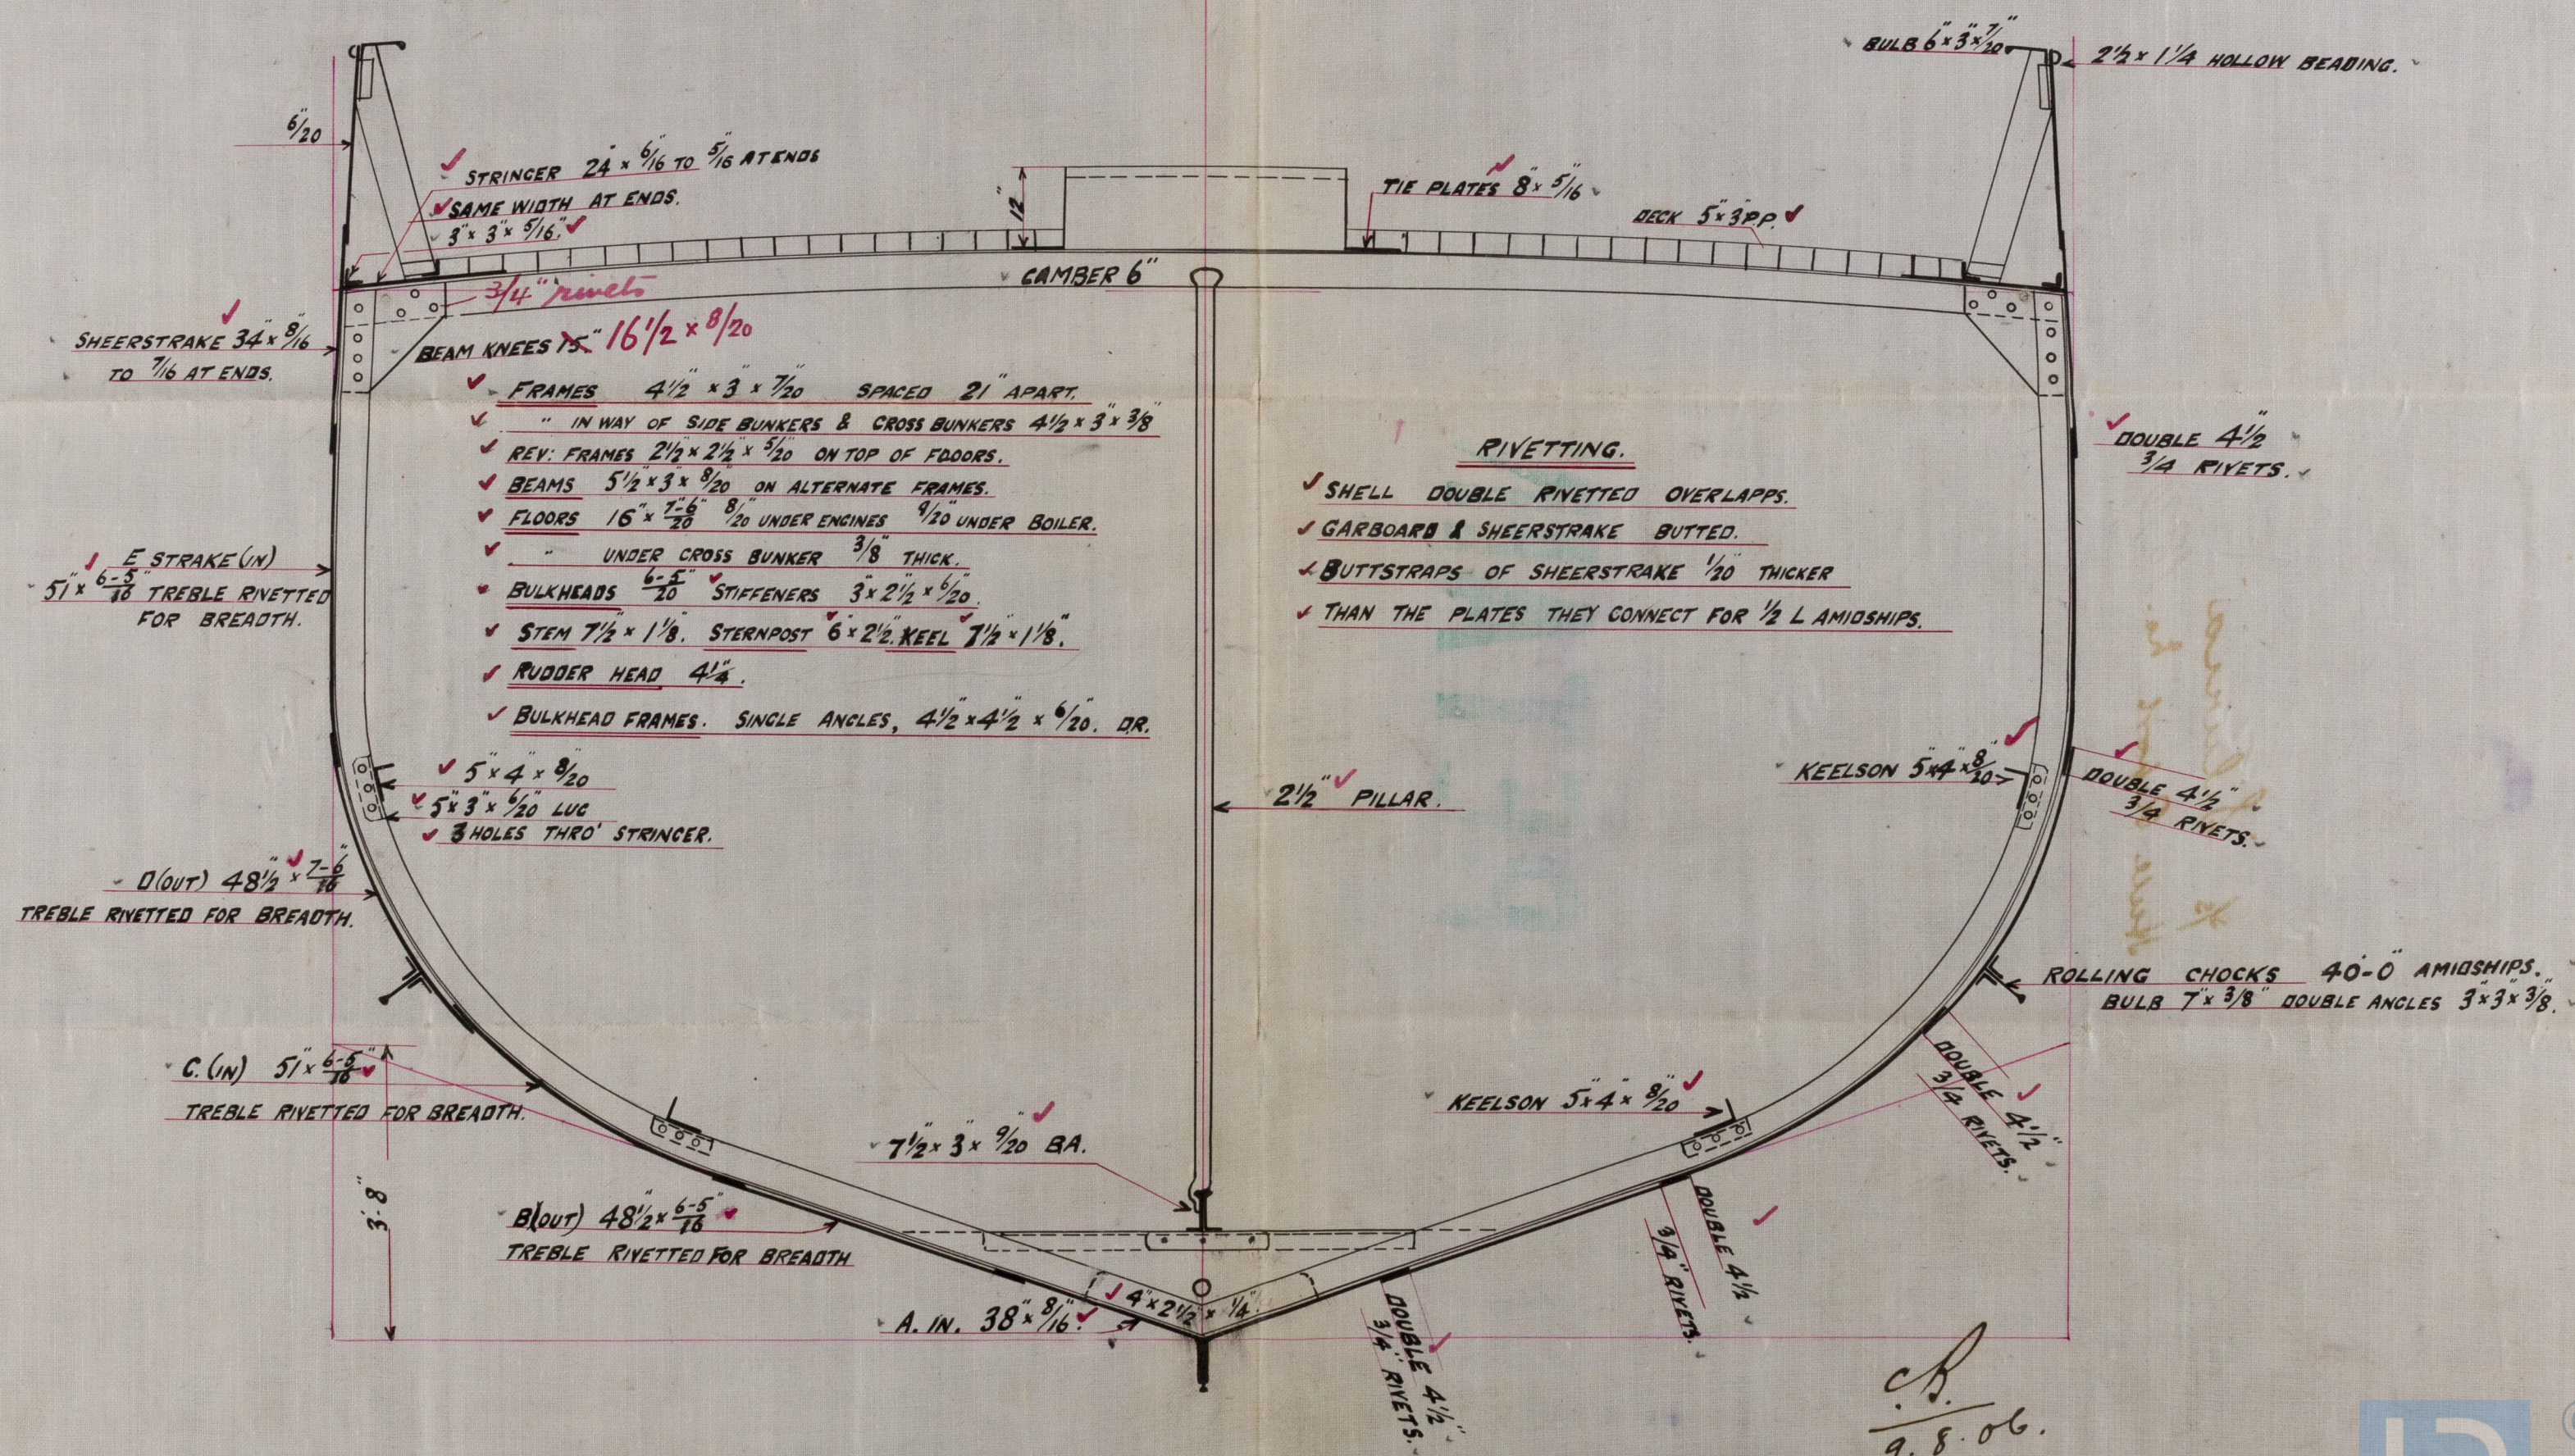

C.B.
9.8.06

Boole S + R Cas

N. 94

Midship Section

s/s Siluria
Hull Report No. 1876-4



© 2020

Lloyd's Register
Foundation

W1302-0042