



Nº 959 S.S. HEIJIN MARU.
STRUCTURAL ARRANGEMENT
SCALE 1/8 IN TO ONE FT

OSAKA IRONWORKS
APR 25 1944
大阪鐵工所


PROFILE

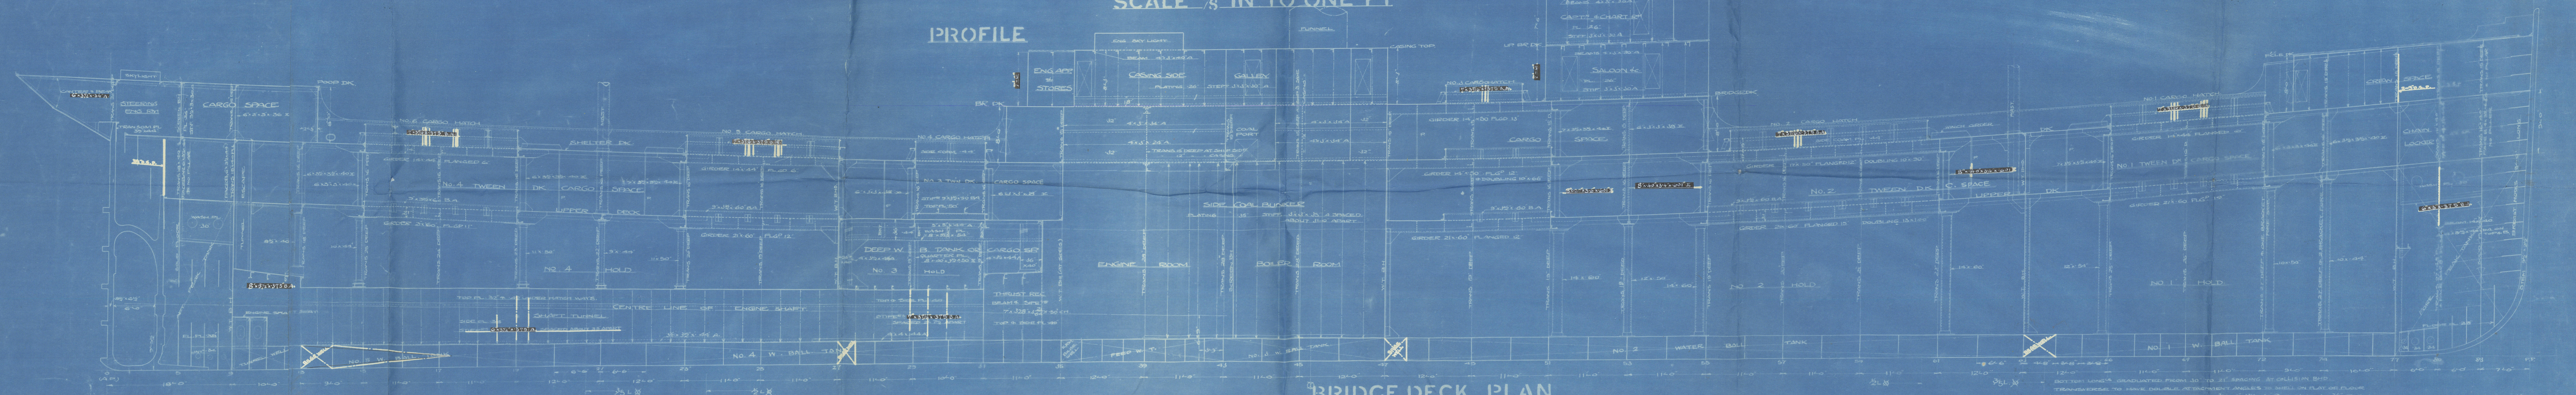


BRIDGE DECK PLAN

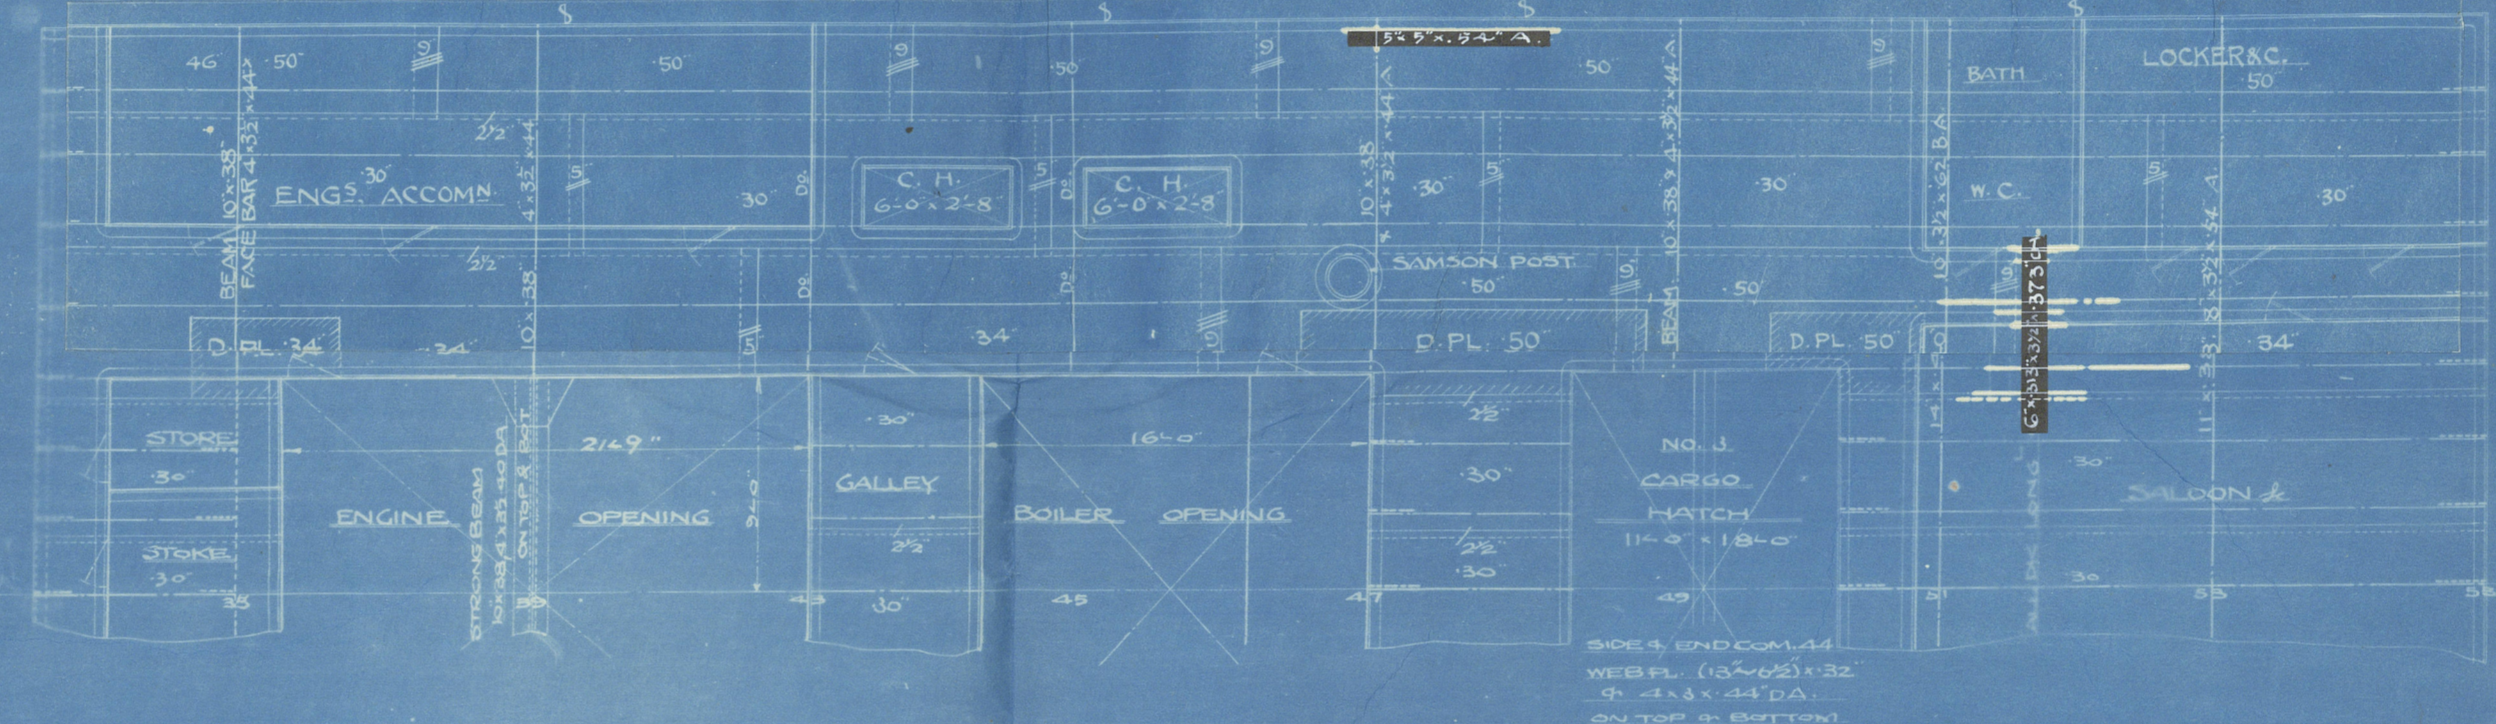


FORECASTLE DECK PLAN

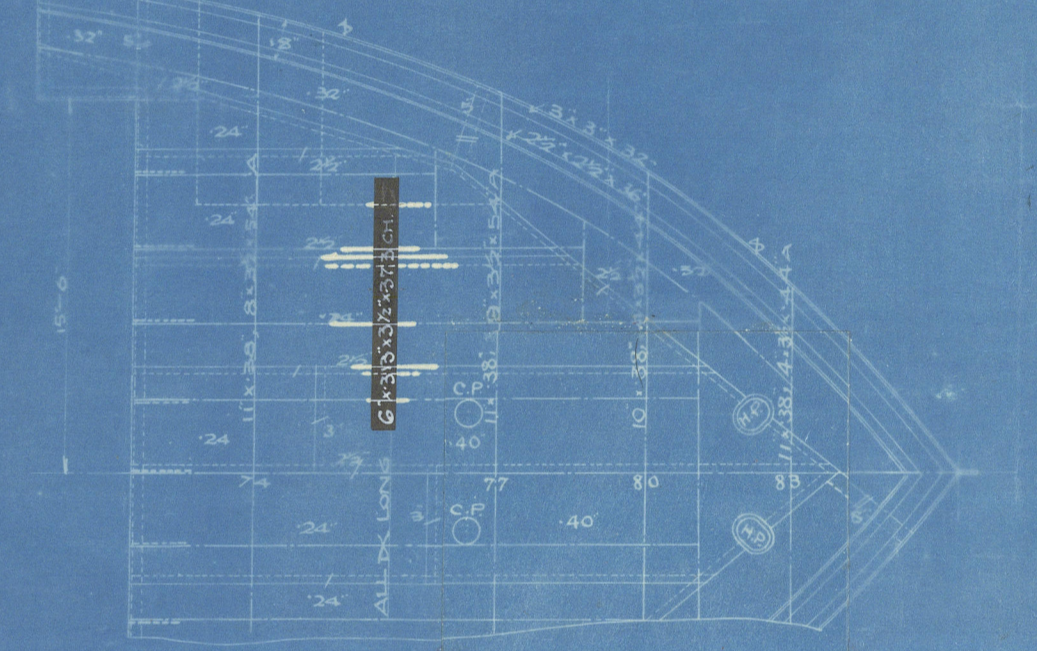


POOP DECK PLAN

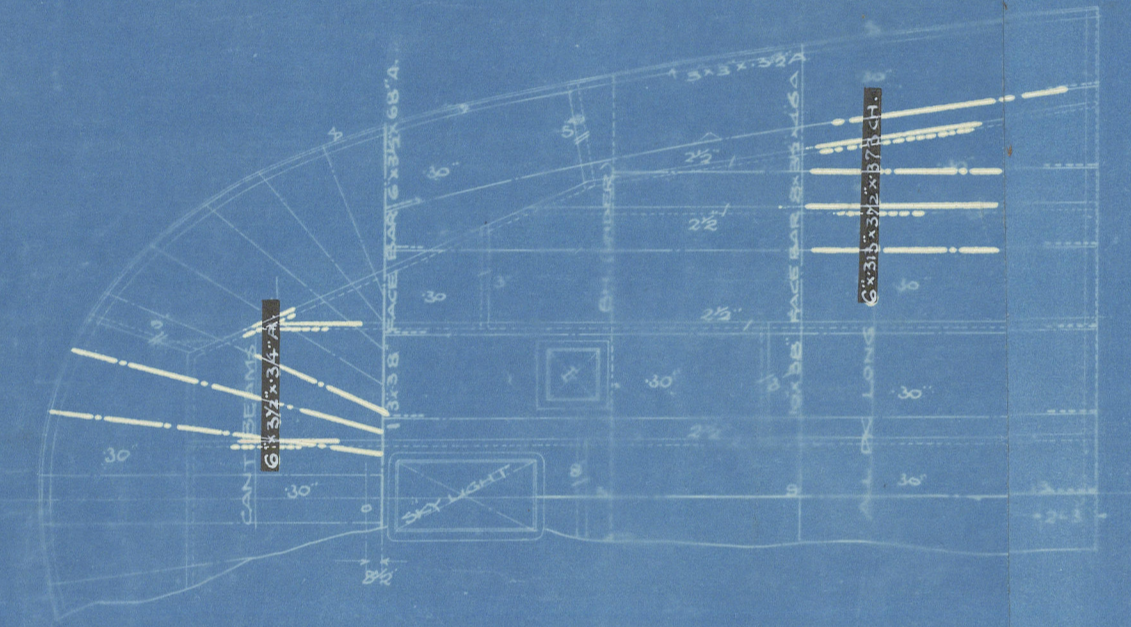

SHELTER DECK PLAN

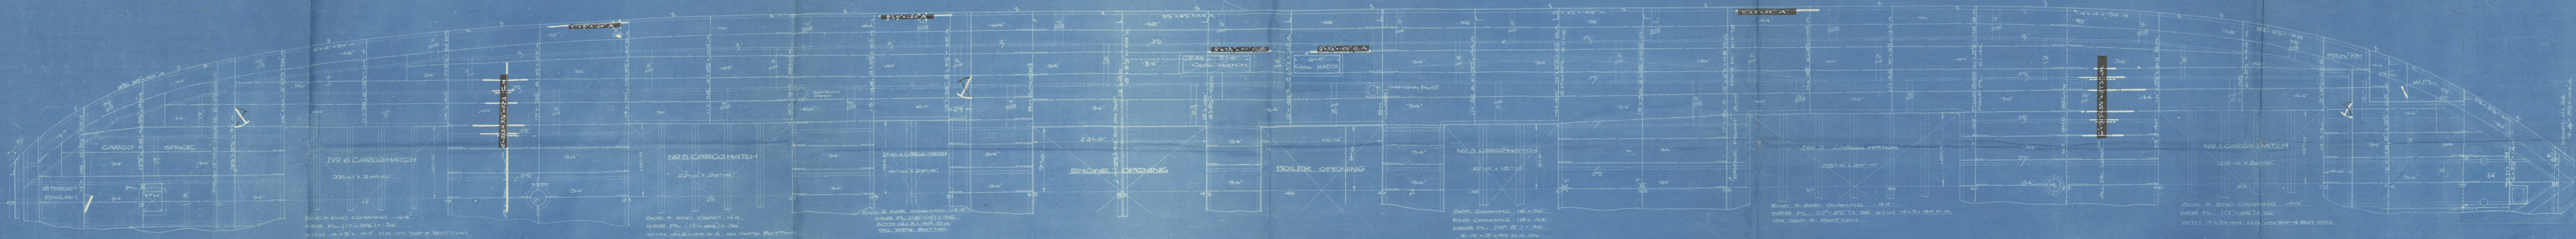

UPPER DECK PLAN

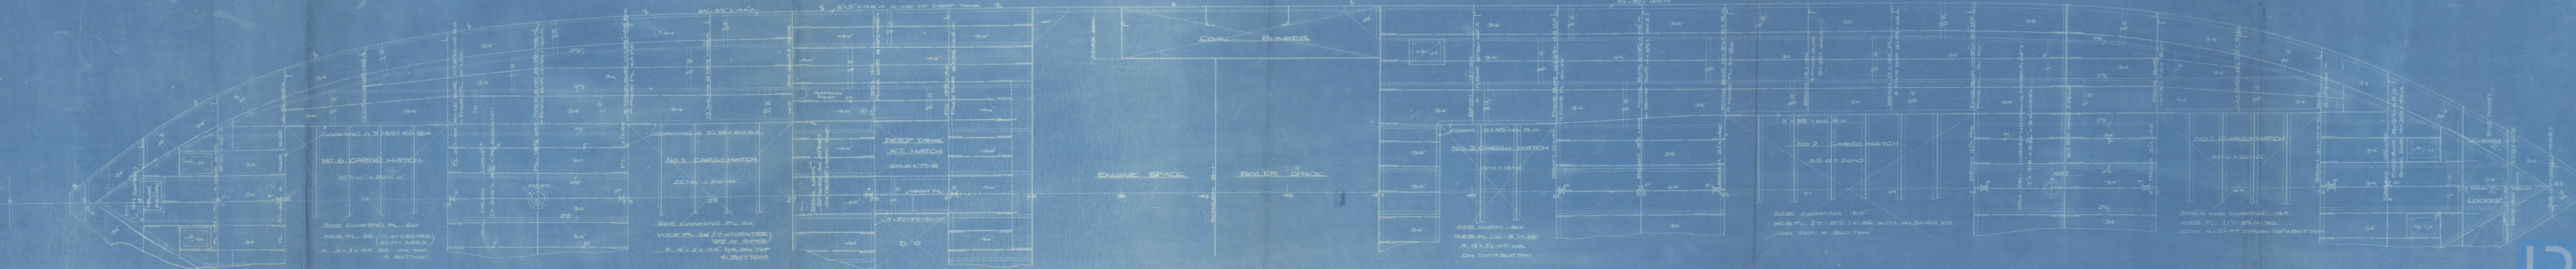

O.I. W. No 959

Profile & Deck
3/8 "Heijun Morn"
Kobe Rpt No 2416

RETAIN

RETAIN



© 2021

Lloyd's Register
Foundation

W1303-0032