

No 434



MIDSHIP SECTION.

TO CLASS TEISHINSHO RULE 1ST CLASS VESSEL

& LLOYD'S 100 A1 WITH FREE BOARD.


SCALE 1/2 INCH TO ONE FOOT.

PRINCIPAL DIMENSIONS.	
LENGTH BETWEEN P.P.	385'-0"
BREADTH MOULDED	51'-0"
DEPTH MOULDED TO UPPER DECK	28'-0"
HEIGHT BETWEEN UPPER & LOWER DECKS	8'-0"
" " " "	8'-6"

SCANTLING NUMBERS.	
B	51
D	28
TRANSVERSE NUMBER	28
LONGITUDINAL NUMBER	30.415
LD TO AWNING DECK	10.7
" " " "	16-0

EQUIPMENT NUMBER.	
LONGITUDINAL NUMBER	30.415
AWNING DECK (385 x 8 x 75)	2.310
OK. HULLS (120 x 75 x 8)	4.65
NUMERAL	33.190

EQUIPMENT.	
3 BOW ANCHORS (STOCKLESS)	58 CWT EACH
1 STREAM ANCHOR (COMMON)	16 1/2 " EX STOCK
1 KEDGE " " "	7 " " "
2 1/2" STUD CHAIN CABLE	210 FATHOMS
2 3/4" STEEL WIRE FOR STREAM ANCHOR	90 "
4 3/4" " " TOWLINE	90 " EACH
2 COILS OF 8" MANILLA	90 " EACH

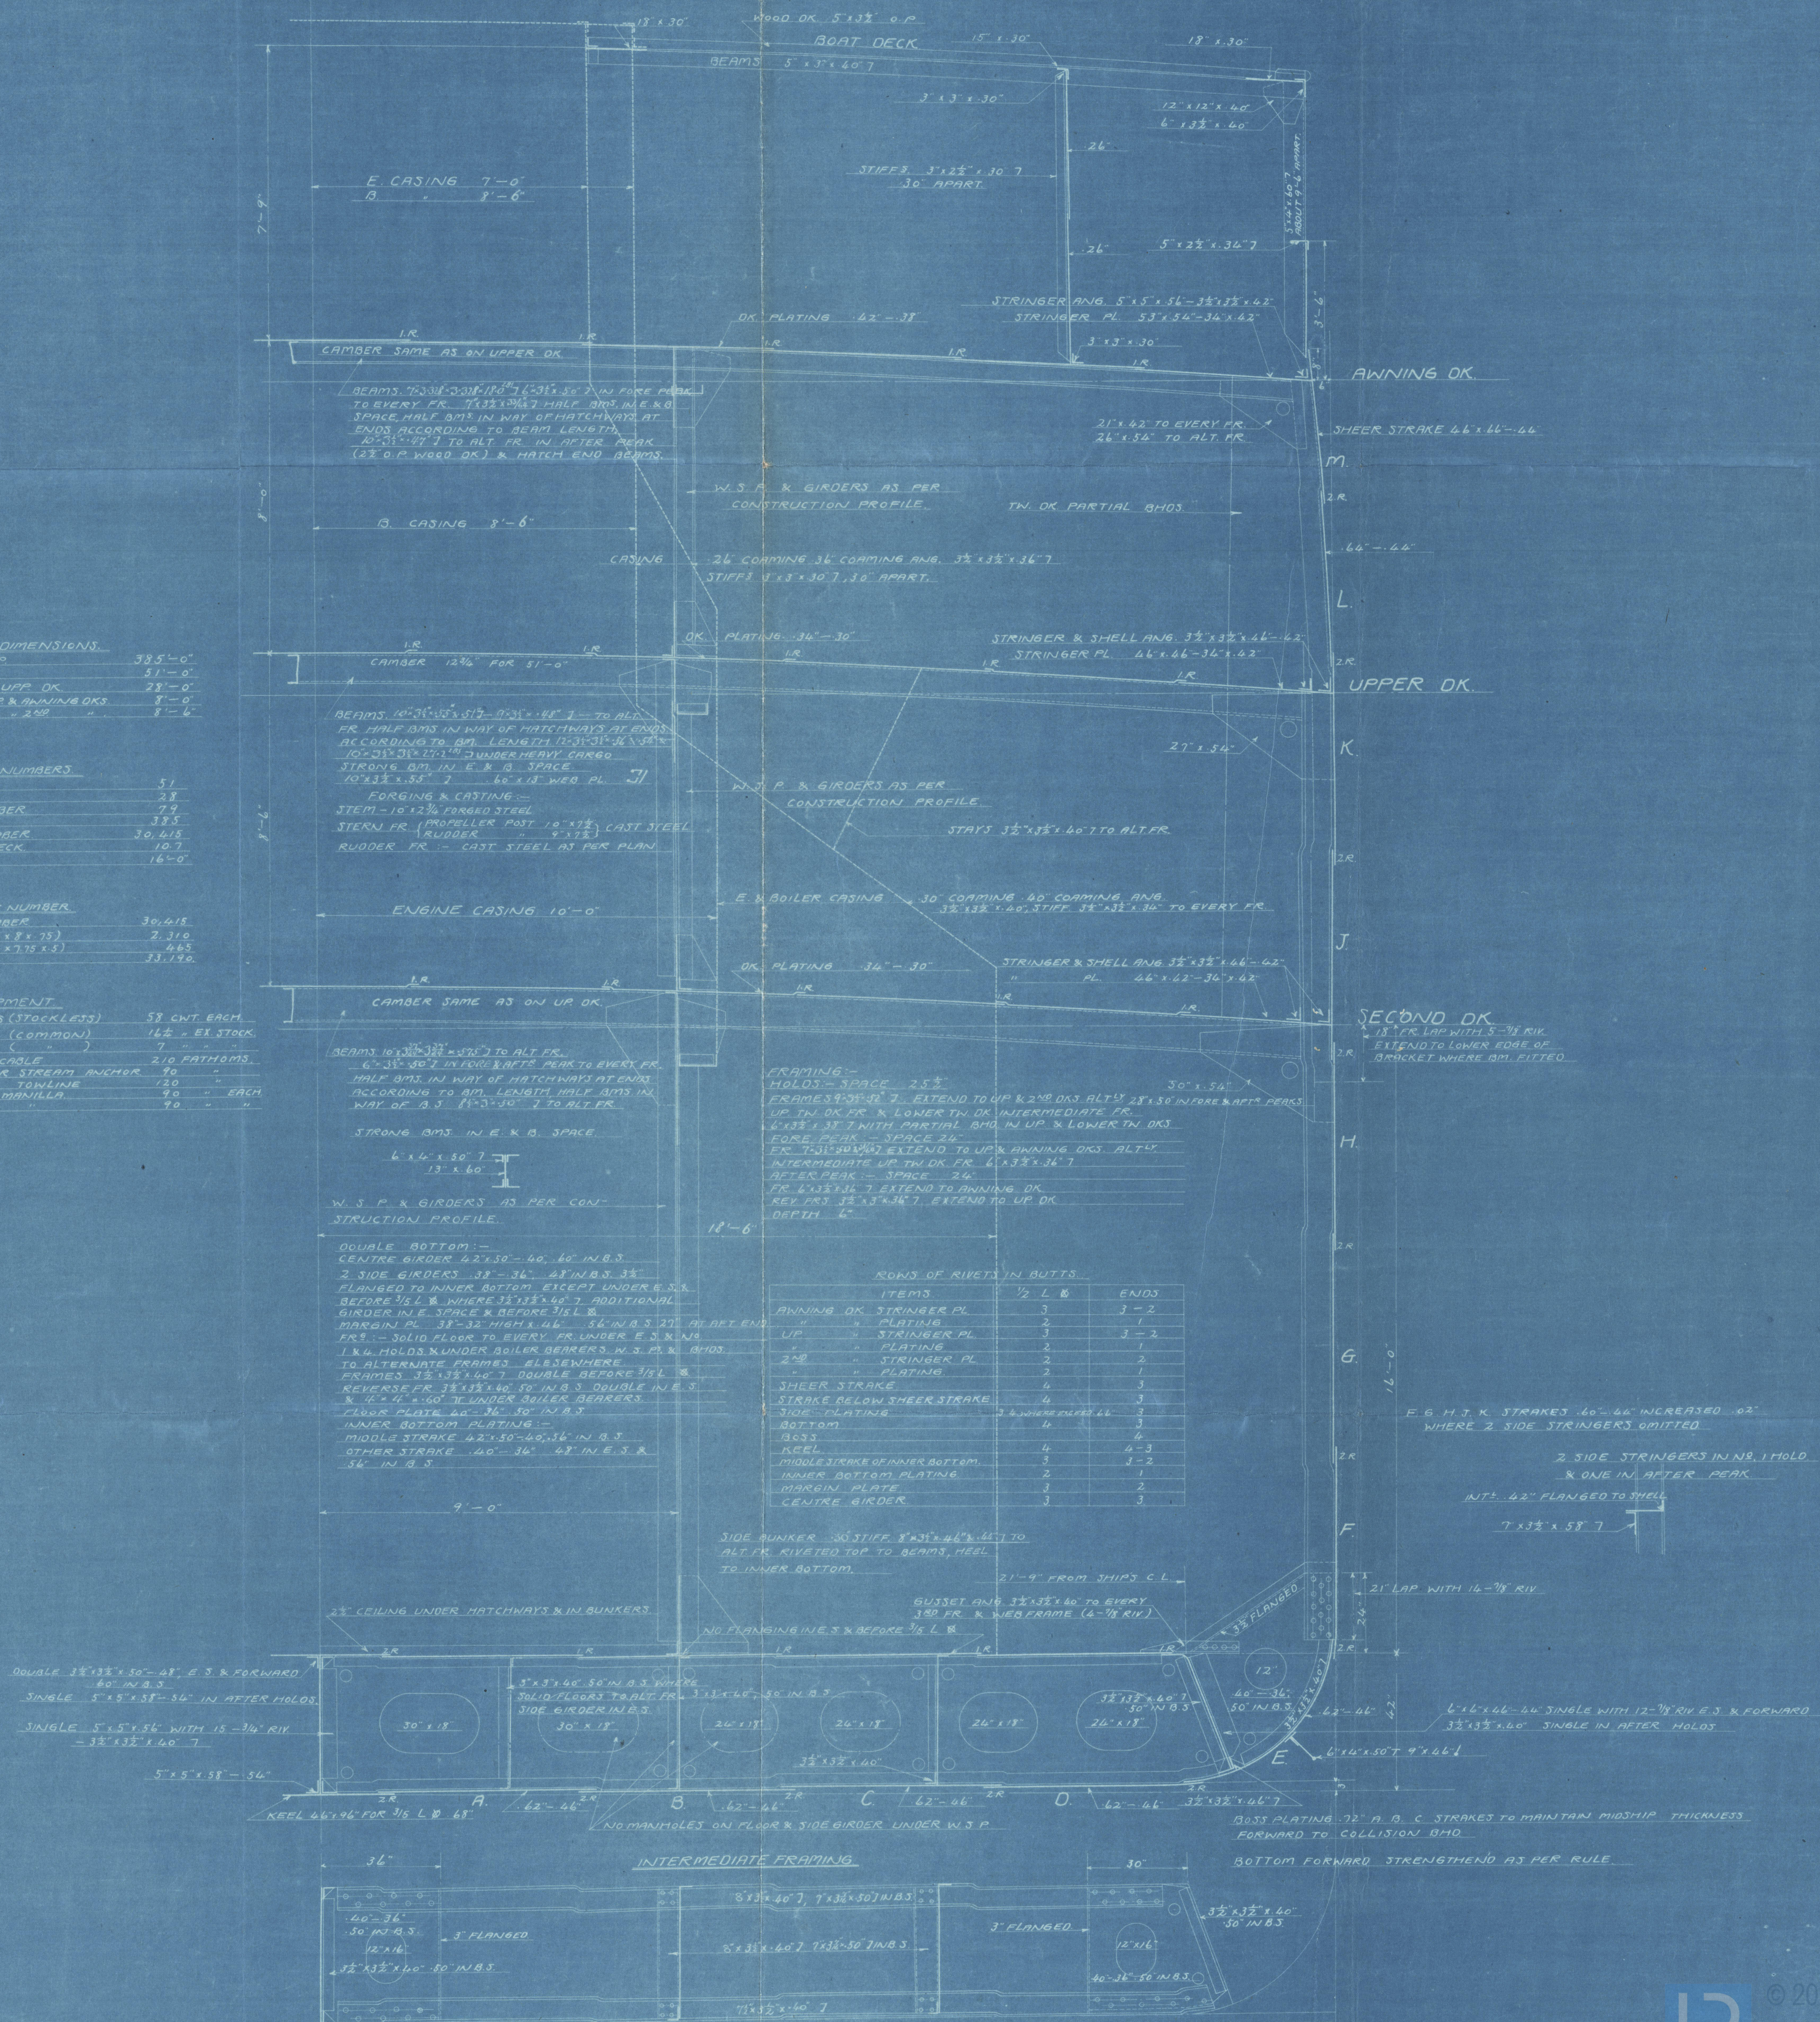

Kawasaki Dry Dock & Ship Repair Co. Ltd

Yard No. 434

"Japaku Maru"

Midship Section.

Robt Rpt. No. 2455



RETAIN

RETAIN



© 2021

Lloyd's Register
Foundation

W1305-0217