

Nº 284

PROPOSED STEEL SCREW TUG

DIMENSIONS


100'-0" B.P. x 23'-0" EXT x 11'-0" M.L.P.

SCALE 1/8" = 1 FOOT

TO CLASS A.1. COASTING RIVER PLATE

RIO DE JANEIRO AND BAHIA BLANCA


19/11/06

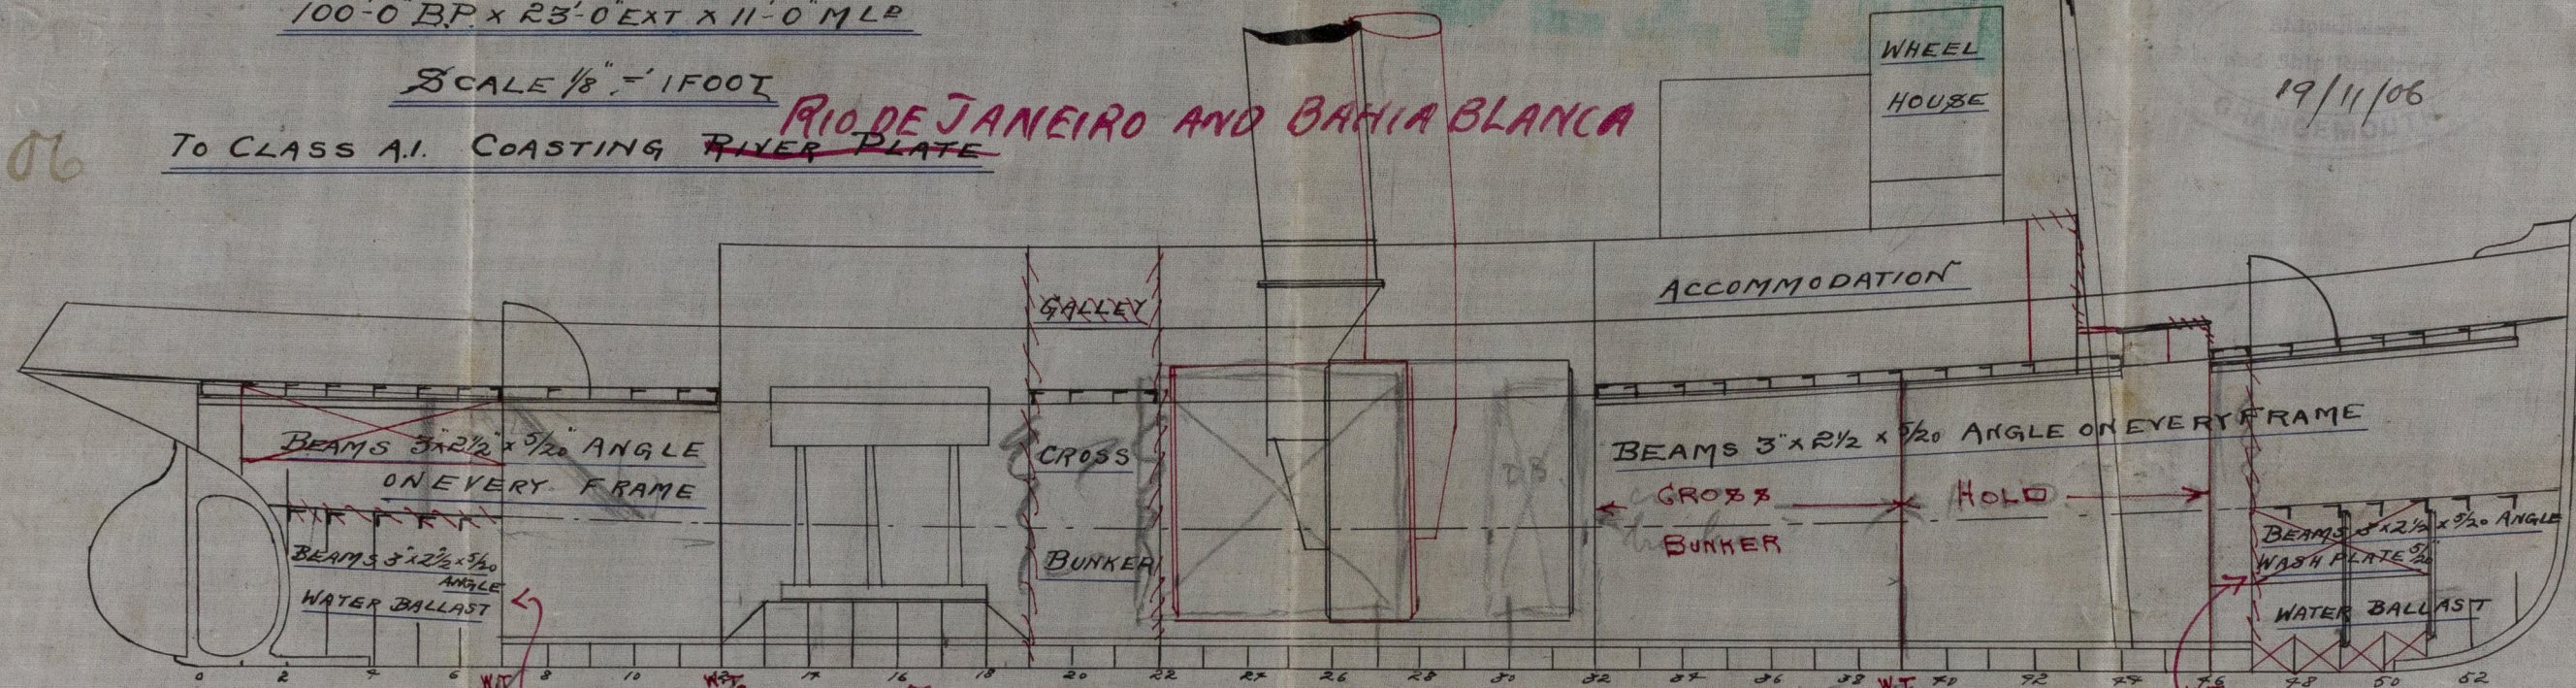

W.T. B.H.
tank bulkhead 5/16
Stiffeners 4x3x7/16 S.A. 24.

W.T. B.H.
plating 5/16 - stiffeners 4x3x7/16 S.A. 24


STRINGER 5/20" ALL FORE & AFT

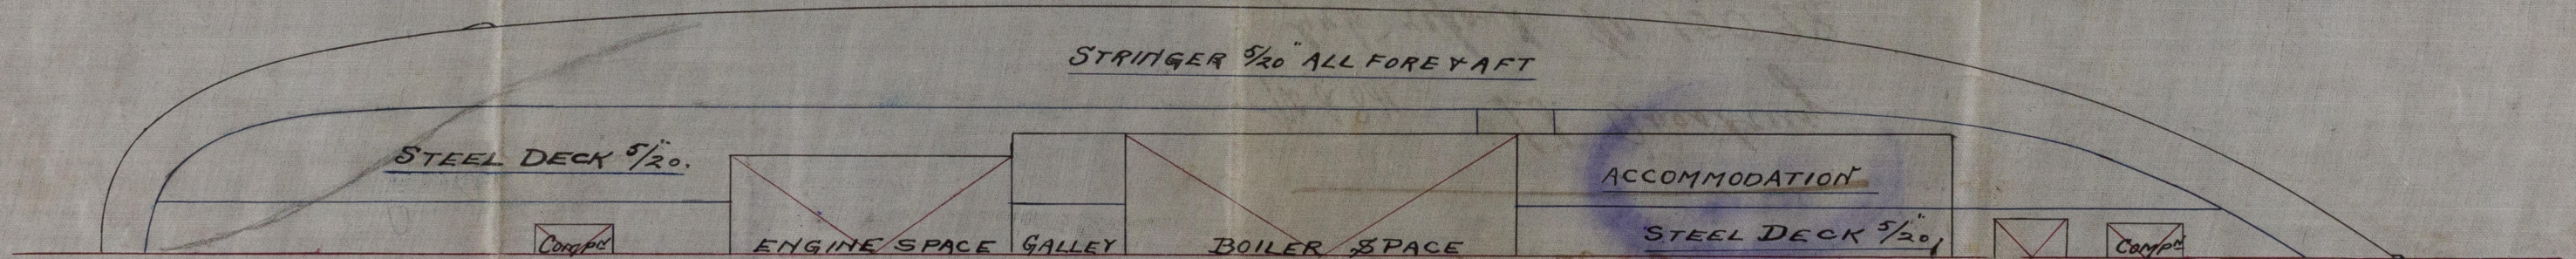

Profile & Deck Plans.

Grangemouth & Grh. Dy. Co.

Aug. No 284

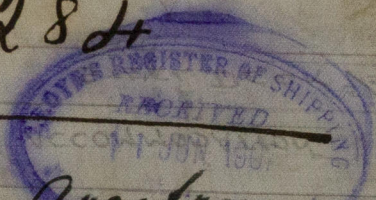

No 284 L.S. Avestrup

Grh report No 15098.



RETAIN



© 2021

Lloyd's Register
Foundation

W1305-0293