

- N° 284 -

PROPOSED STEEL SCREW TUG

NUMERALS

1/2 GIRTH ..... 20.43

1/2 BREADTH ..... 11.45

DEPTH ..... 11.5

43.38 x 99.16 = 4301.56

F.N.

P.N.

DIMENSIONS

100'-0" B.P. x 23'-0" EXT. x 11'-0" M.L.D.

SCALE 1/2" = 1 FOOT

PROPORTIONS

DEPTHS IN LENGTH ..... 8.62

BREADTHS IN LENGTH ..... 4.32

RIO DE JANEIRO and BAHIA BLANCA

TO CLASS A.1. COASTING RIVER PLATE

EQUIPMENT.

ONE ANCHOR ..... 4 3/4 GWTS EX STOCK.


ONE ANCHOR ..... 4/4 D° D°

ONE ANCHOR ..... 2 1/2 D° D°

30 FATHOMS ..... 15" GLOBE LINK CHAIN

60 D° ..... 5/8 HAWSER OR 2" S.W.

60 D° ..... 4" HAWSER.

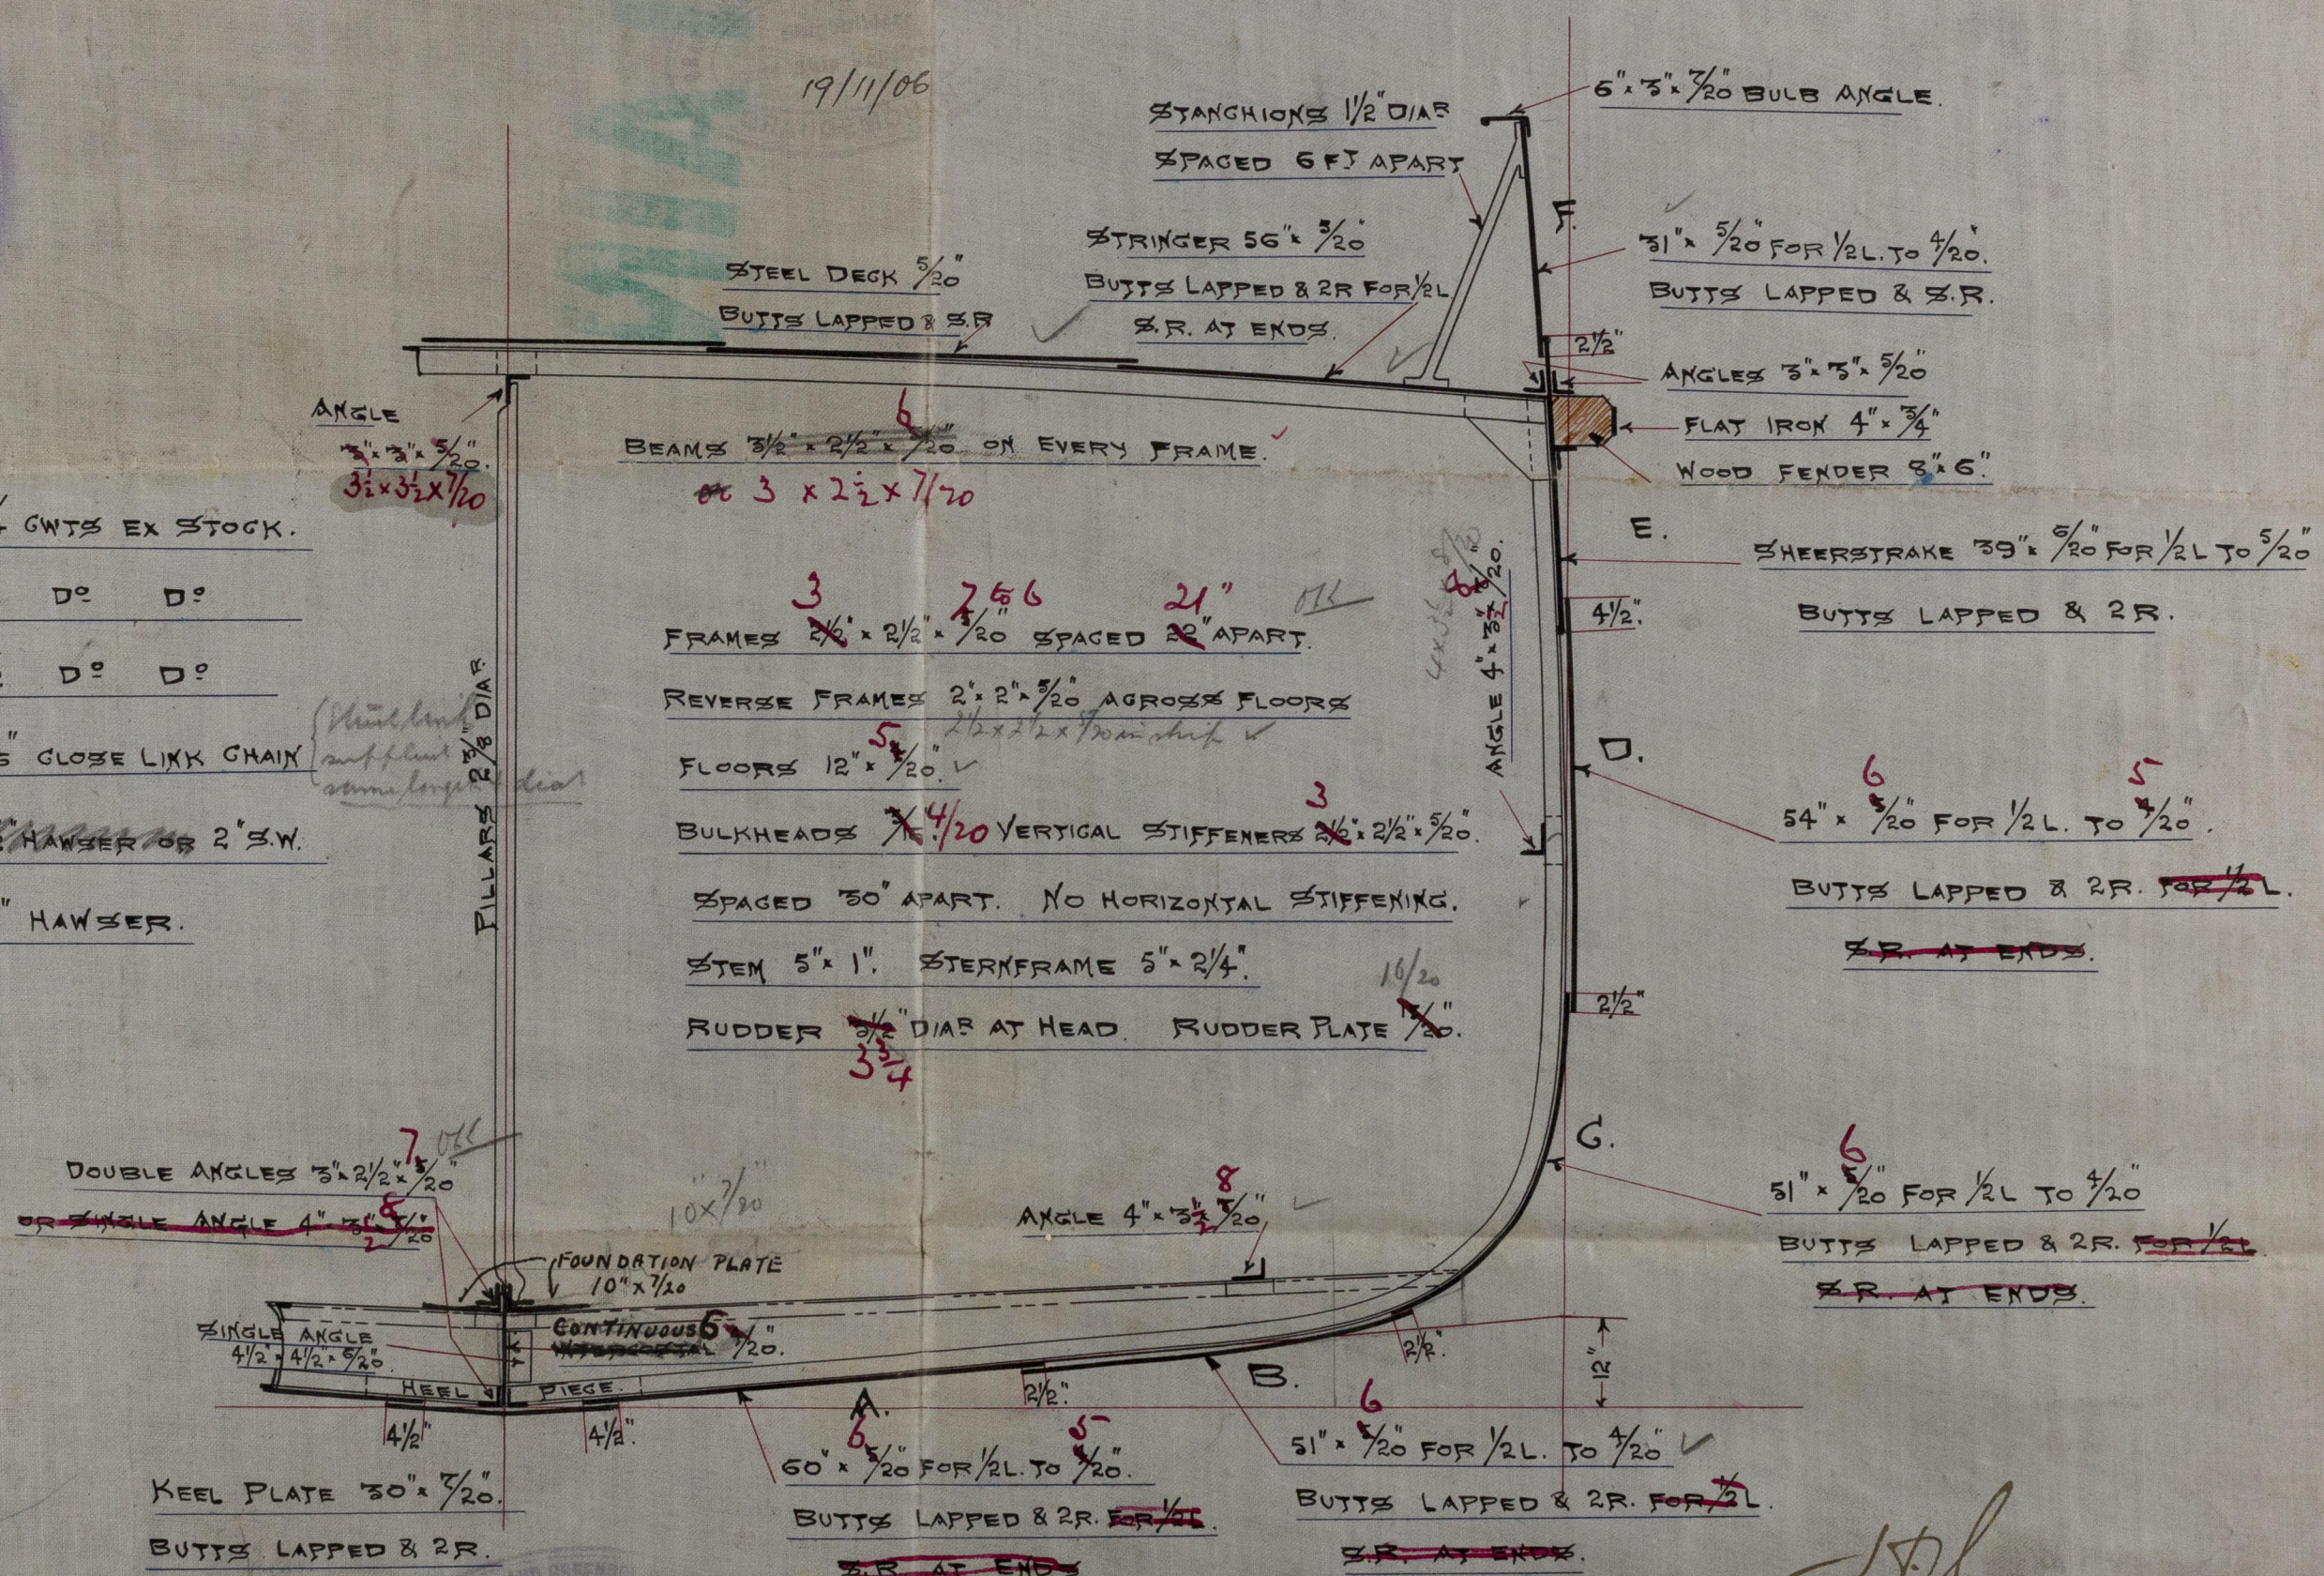

Supervisor  
and Ship Inspector  
19/11/06  

24/11/06



Midship Section

Grangemouth & Grh. Dy. Co.

Tug. No 284

No 284 H. Avestrey  
Grh report No 15098



42.28 x 22.12 x 4201.22

EN

HN

20 CLEVELAND

20 CLEVELAND



© 2021

Lloyd's Register  
Foundation