


28.4.11

**N° 145**  
**ELEVATION**

DIMS: 165'-0" x 26'-0" x 13'-5" MLD.

SCALE  $\frac{1}{8}'' = 1 \text{ FOOT}$

BOOLE SHIPBUILDING & REPAIRING CO. LTD.  
SHIPBUILDERS & ENGINEERS  
13/4/1911  
VICTORIA SHIPYARD, BOOLE

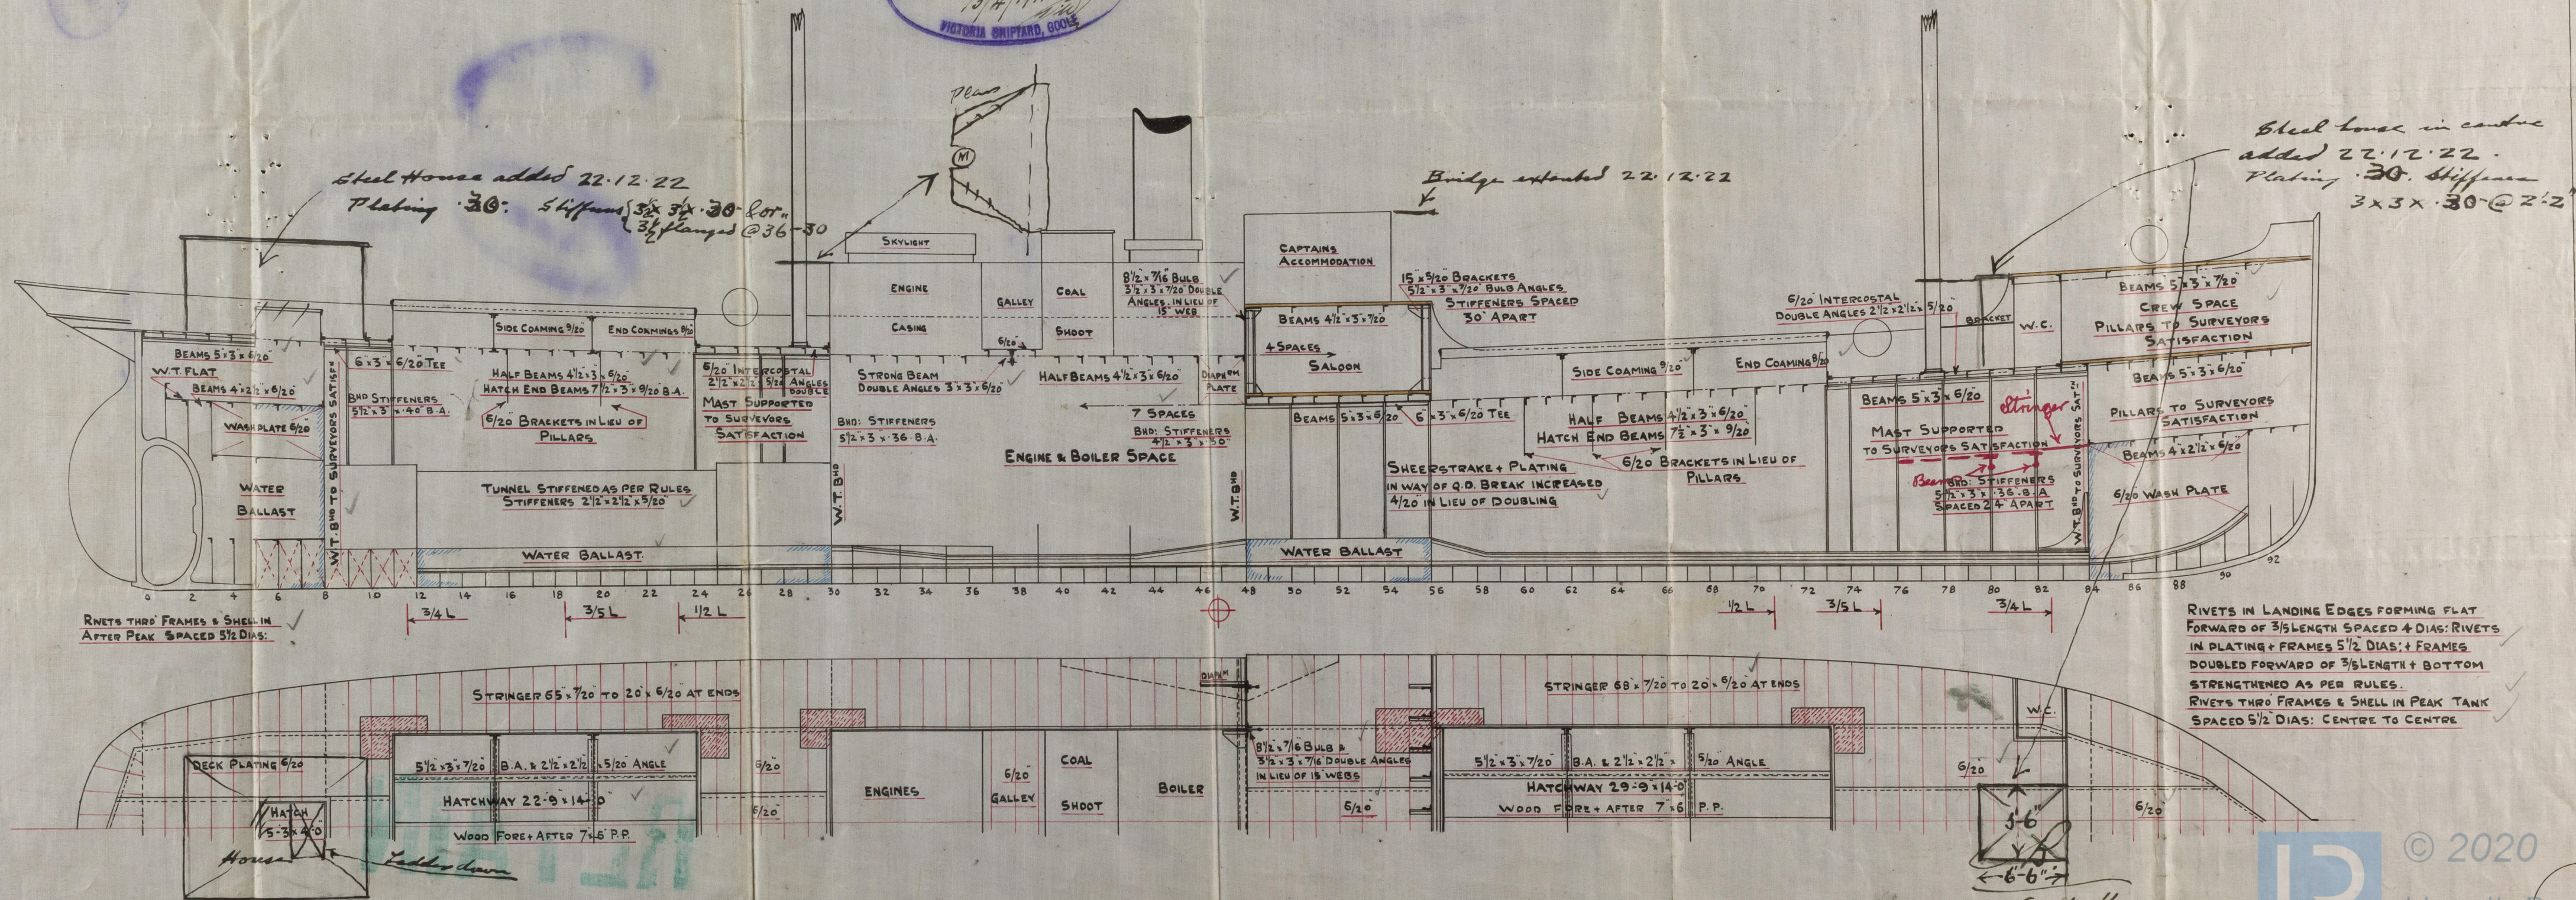

RIVETS IN LANDING EDGES FORMING FLAT FORWARD OF  $\frac{3}{5}$  LENGTH SPACED 4 DIAS: RIVETS IN PLATING + FRAMES  $5\frac{1}{2}$  DIAS: + FRAMES DOUBLED FORWARD OF  $\frac{3}{5}$  LENGTH + BOTTOM STRENGTHENED AS PER RULES. RIVETS THRU FRAMES & SHELL IN PEAK TANK SPACED  $5\frac{1}{2}$  DIAS: CENTRE TO CENTRE



© 2020

W1306-0049




Book S + R.C. = 2d

№ 145.

Profile + Deck.

$\frac{1}{2}$  Lbs Hull Rpt No. 24482.

11.4.22

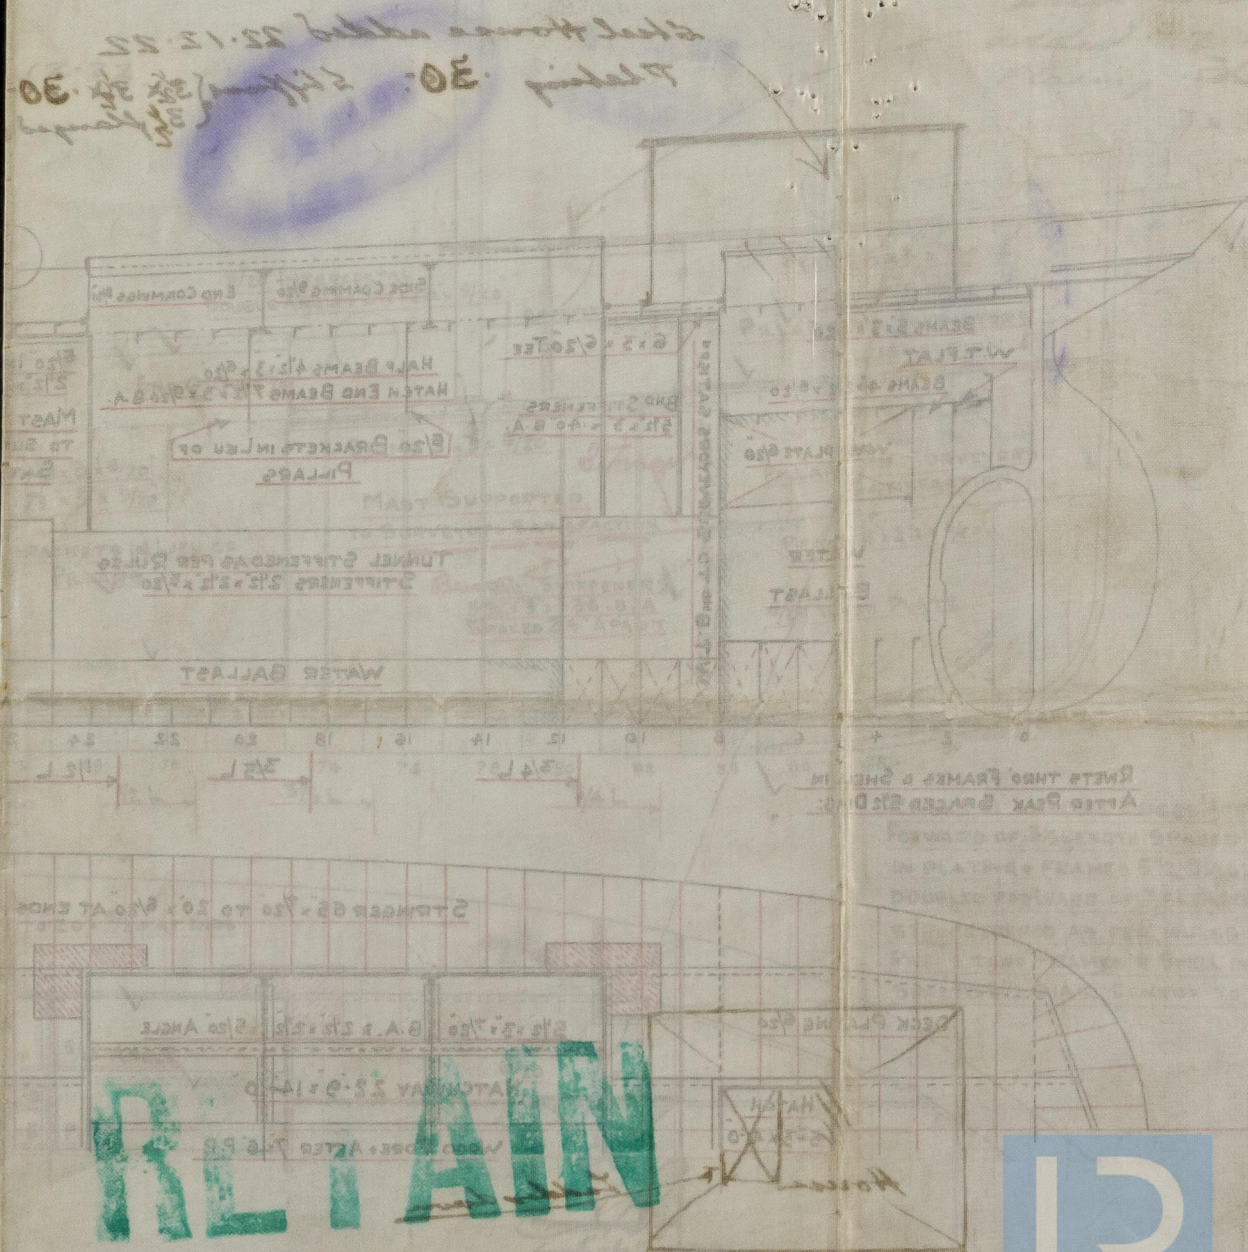

© 2020

Lloyd's Register  
Foundation

W1306-0049