

N^o 145

MIDSHIP SECTION

DIMS: 165'-0" x 26'-0" x 13'-5" MOULDED

TO CLASS 100A.I. AT LLOYDS

SCALE 1/2" = 1 FOOT

L/D = 12.2

DISPL. COEFF. .73

EQUIPMENT N^o 7005

R.Q.D. = (87.5 x 3.75) + BRIDGE 3/4 (14 x 6.75) + FCSLE
3/4 (20.25 x 6.75) + N^o 6504 = 7005.5



2 BOWERS	12 1/2 CWTs	STOCKLESS
1 "	10 1/2 "	"
1 STREAM	4 "	EX STOCK
1 KEDGE	13/4 "	" "
195 FATHOMS	12 1/16 "	STUD LINK CABLE
60 "	2 3/4 "	STEEL WIRE
75 "	2 3/4 "	" "
90 "	6 "	HAWSER

NUMERALS

BREADTH 26'-0"
DEPTH 13'-4 1/2"
TRANS. N^o 39-42
LENGTH 165'-0"
LONG. N^o 6504-30

28.4.11

4-1-17

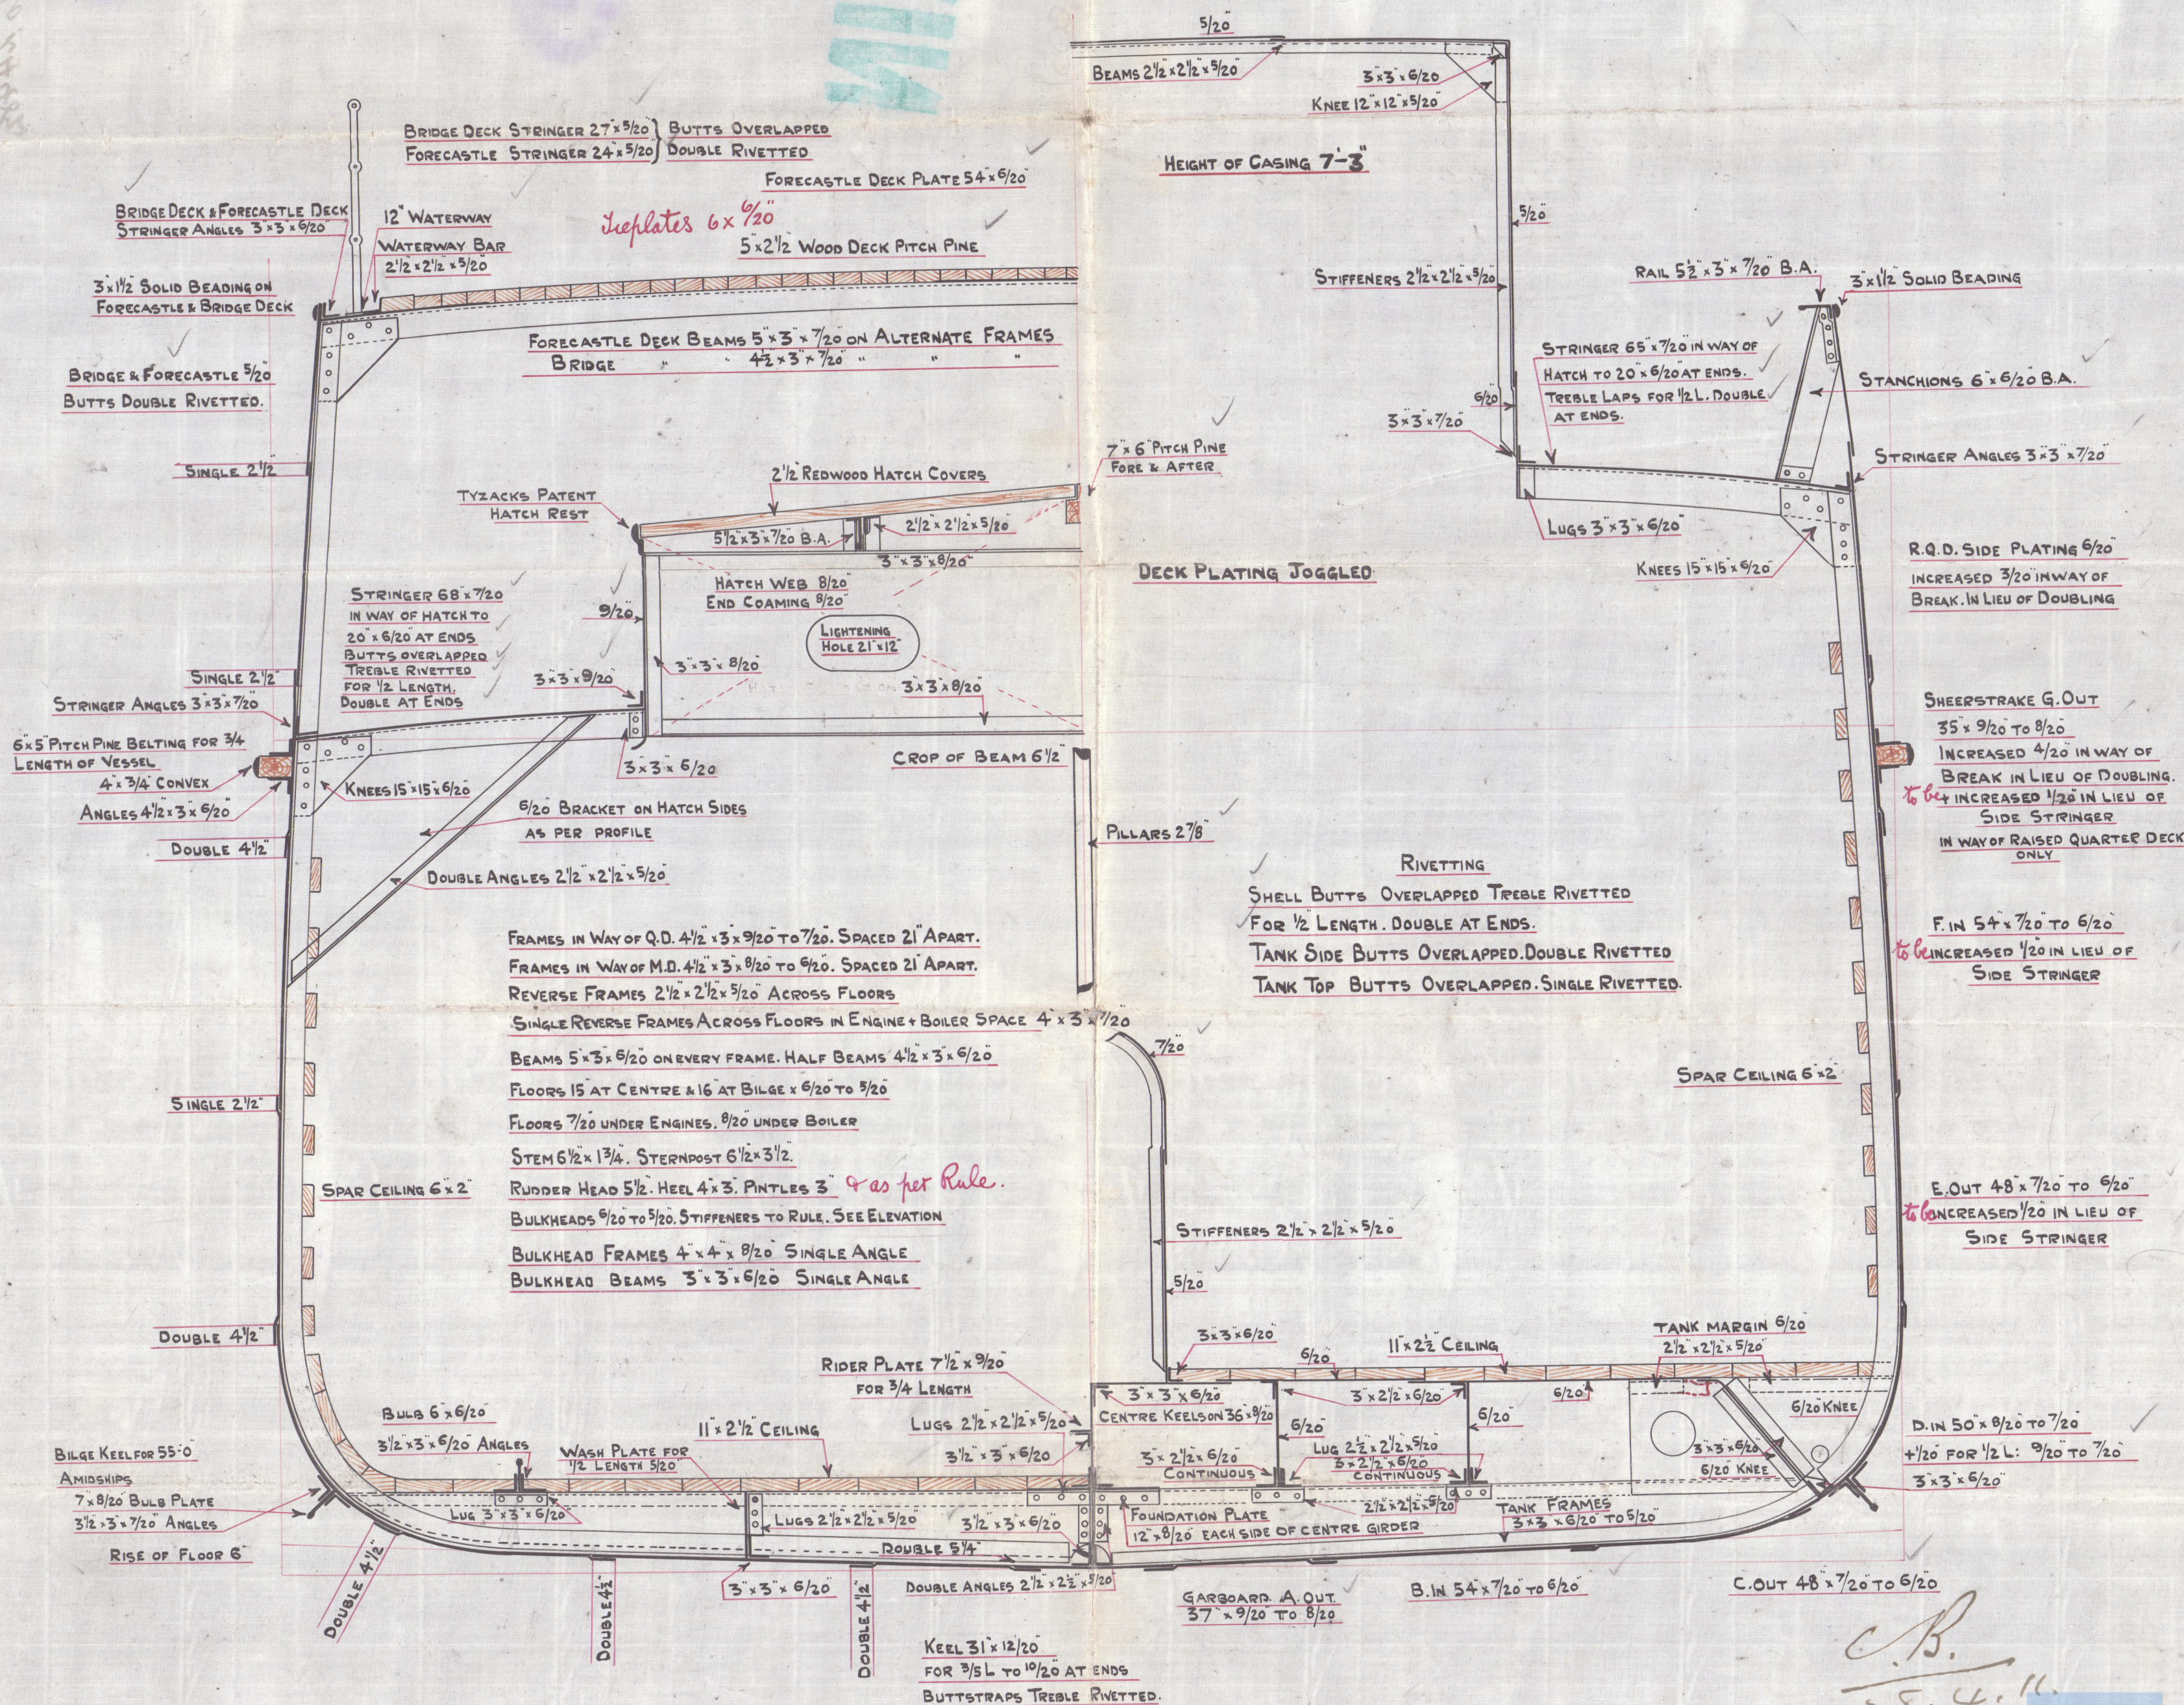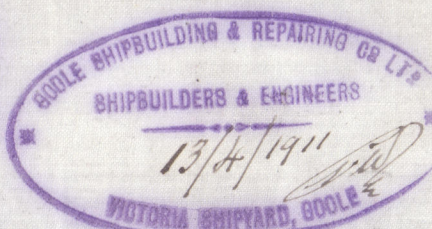

© 2020

Lloyd's Register Foundation

W1306-0051

Boole S. & R. C. 2d

N. 145.

Midship Section.







© 2020

Lloyd's Register Foundation

W1306-0051