

21.4.10

MIDSHIP SECTION

STEEL SCREW TRAWLER

N^{OS} 466-7

DIM^{NS} LENGTH 120' 0" B.P. x 21' 6" EX. x 12' 3" DEPTH MOULDED

SCALE 1/2" = ONE FOOT

TO CLASS 100-A1 AT LLOYDS FOR FISHING PURPOSES

DECK PLATED OVER IN WAY OF MACHINERY SPACE

ENGINE & BOILER CASING AS PREVIOUSLY APPROVED

PLAN No. 9183

For ENCLOSURE To
Messrs Lloyd's Surveyors
Hall




DATE 19/4/10. R.K.

Handwritten notes in pencil:

Handwritten notes in red ink:
"3 x 3/4 Solid"

RIVETING
BUTTS OF SHELL PLATING LAPPED +
DOUBLE RIVETED EXCEPT GARBOARD*
SHEERSTRAKE WHICH ARE TO BE
STRAPPED + DOUBLE RIVETED
LANDINGS DOUBLE RIVETED BOLWARKS
SINGLE RIVETED

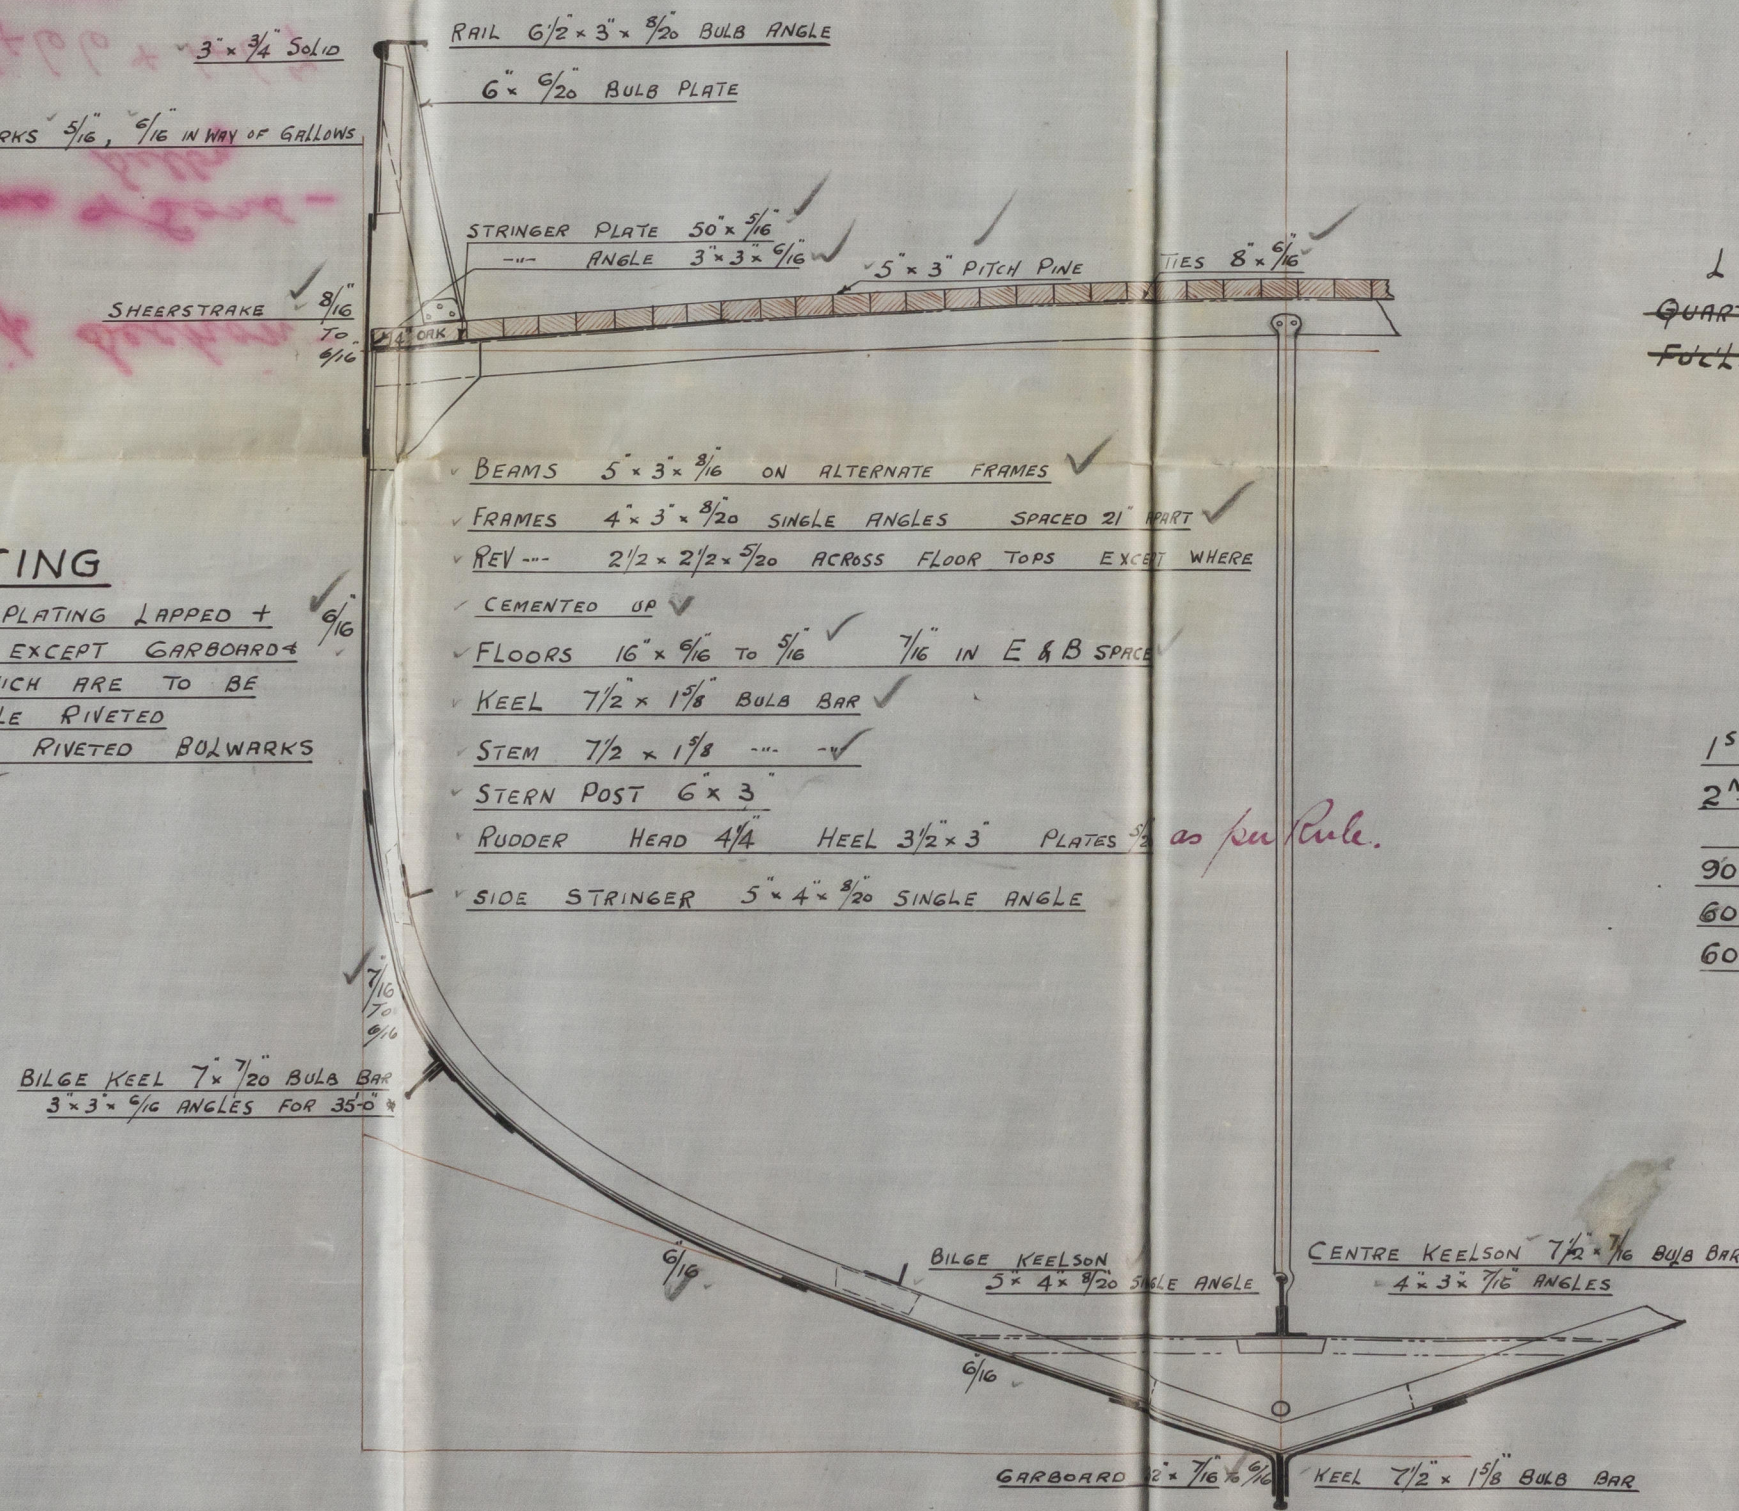

NUMERALS


B + D = 33.625 ✓
L x (B + D) = 4035 ✓
QUARTER D^K 68 x 1 = 68 ✓
FULL D^K 185 x 375 x 75 = 5203 ✓
EQUIPMENT N^o ~~4188-655~~ 4035

PROPORTIONS

L/D = 9.75 ✓
B/D = 5.61 ✓

EQUIPMENT

1 ST	BOWER ANCHOR	5 5/8 CWTs	EX STOCK	✓
2 ND	"	4 1/2	"	✓
	HEAD ANCHOR	2 1/2	"	✓
90	FATHOMS	1"	CABLE	✓
60	"	5 1/2	HAWSER	✓
60	"	4 1/4	WARP	✓

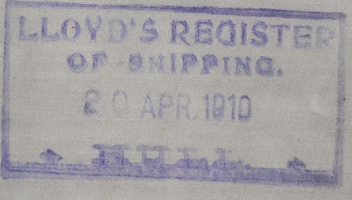

Handwritten notes:
C.F.
21/4/10.

- Midship Section -

- Cochrane & Sons -
Selby

s/s Nos. 466 & 467

s/s Arcan Hull Rpt No. 22847
" Berrian - - - 22971



© 2020

Lloyd's Register
Foundation

W1306 - 0141