



— SCALE $\frac{1''}{2} = 1 \text{ FOOT.}$ —

COPY OF PLAN APPROVED BY LLOYDS 30/1/05.

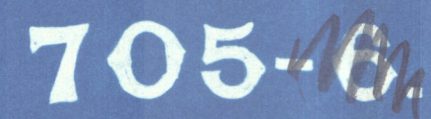

705-6.

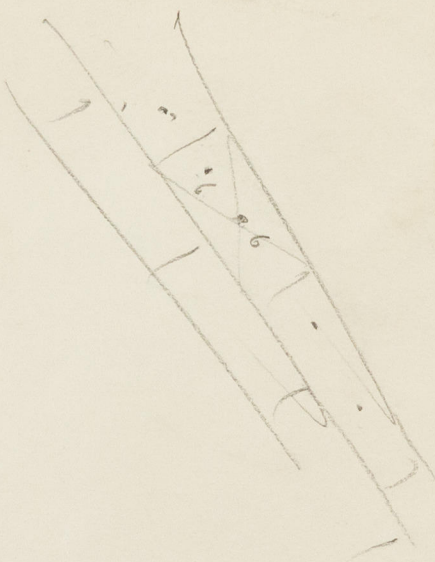

W1306-0160



© 2020

Lloyd's Register
Foundation


W Gray & Co Ltd

No 705

Midship Section

88 "bambyes"

Hpl Report No. 12656

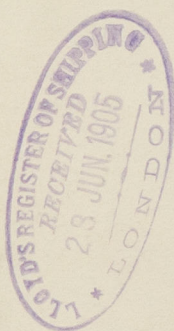

RETAIN



© 2020

Lloyd's Register
Foundation

W1306-0160