

# PROFILE.

SCALE 1/8"=1 FOOT.

COPY OF PLAN APPROVED BY LLOYDS. 30/1/05.


Beams marked A. Built 12" x 1 1/2" / Angle 6" x 4" x 1 1/2"  
 B. " 10 1/2" x 1 1/2" / " 6" x 4" x 1 1/2"  
 C. " 8 1/2" x 1 1/2" / " 6" x 4" x 1 1/2"  
 or 9" x 3 1/2" x 1 1/2" Built angle

Bridge Deck Beams. Built Angle 7" x 3" x 1 1/2"  
 " " " " 5 1/2" x 3" x 1 1/2" 6" x 3" x 1 1/2" angle

## Upper Deck Beams.

Upper Deck Beams. Built Angle 8 1/2" x 3 1/2" x 1 1/2"  
 Half " " 8" x 3" x 1 1/2"  
 End " 3/4" " 6 1/2" x 3" x 1 1/2"  
 Bridge Space " " 9" x 3 1/2" x 1 1/2"  
 " " 2 " 8" x 3" x 1 1/2"

Lower Deck Beams. Built Angle 9" x 3" x 1 1/2" 2 Ang. 3 1/2" x 3 1/2" x 1 1/2"  
 " " 2 " 8" x 3" x 1 1/2" 3" x 3" x 1 1/2"

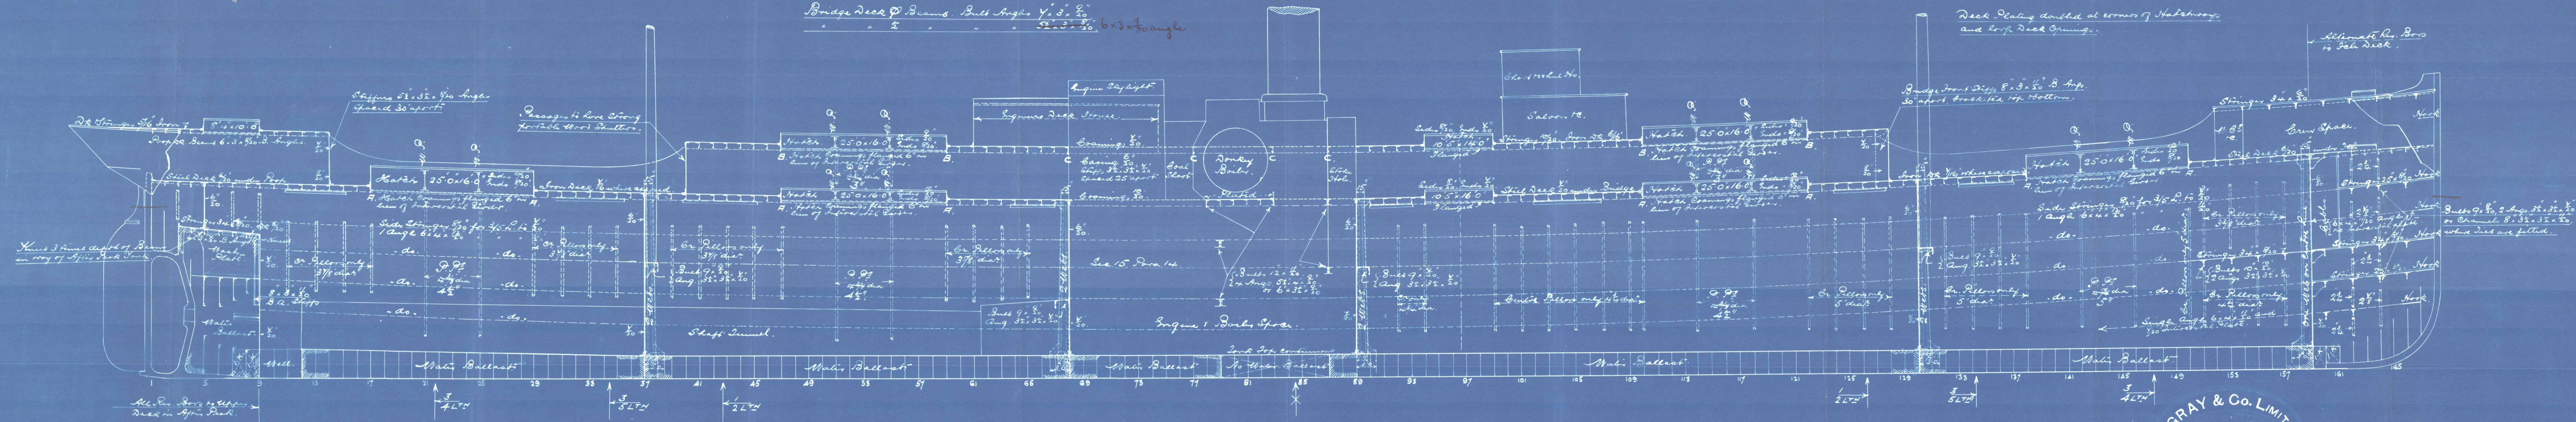

W. GRAY & CO. LIMITED  
 WEST HARTLEPOOL.

705-16



W Gray's Col d

No 705

Profile

88" Cambysses 4.

Apl. Report to. 12656

Now.

APOLLO ✓

D. 157.

RETAIN



© 2020

Lloyd's Register  
Foundation

W1306-0161