

arr'd & unarr'd
 P.T. and P.T. 571
 watered quibab, MO

2-10-11

PLAN No. 1316
 FOR ENCLOSURE TO
 Messrs Lloyd's Surveyors
 FROM
 COCHRANE & SONS,
 SHIPBUILDERS, SELBY
 DATE March 12th 1912 RK

MIDSHIP SECTION.

STEEL SCREW TRAWLERS.

No 517 & 18.

DIM^S 130'-0" x 23'-6" E x 13'-3" MLD

SCALE $\frac{1}{2}$ INCH = ONE FT.

PLAN No. 748
 FOR ENCLOSURE TO
 Messrs Lloyd's Surveyors
 FROM
 COCHRANE & SONS,
 SHIPBUILDERS, SELBY
 DATE Sept 29th 11 RK

TO BE CLASSED 100 A1 AT LLOYDS FOR FISHING
 PURPOSES. ENGINE & BOILER CASING AS
 PREVIOUSLY APPROVED. DECK PLATED OVER IN
 WAY OF MACHINERY SPACE.

NUMERALS

B + D = 56.62

L x (B + D) = 4700.6

PROPORTIONS

DIV D/B = 5.5


DIV D/L = 9.8

EQUIPMENT

1 ST BOWER ANCHOR	7 $\frac{1}{2}$ 53 CWT ^S E ^X STOCK
2 ND " "	6 $\frac{1}{2}$ 53 " " "
3 RD " "	3 " " "
105 FATHOMS	116 CABLE
60 " "	6 " HAWSER
60 " "	5 " WARP.

RIVETING

BUTTS OF SHELL PLATING LAPPED &
 DOUBLE RIVETED EXCEPT CARBOARD
 9 SHEERSTRAKE, WHICH ARE BE STRAPPED.
 LANDINGS DOUBLE RIV^D BULWARKS
 SINGLE RIV^D BUTTS OF STRINGER
 9 TIE PLATES OVERLAPPED & DOUBLE RIV^D

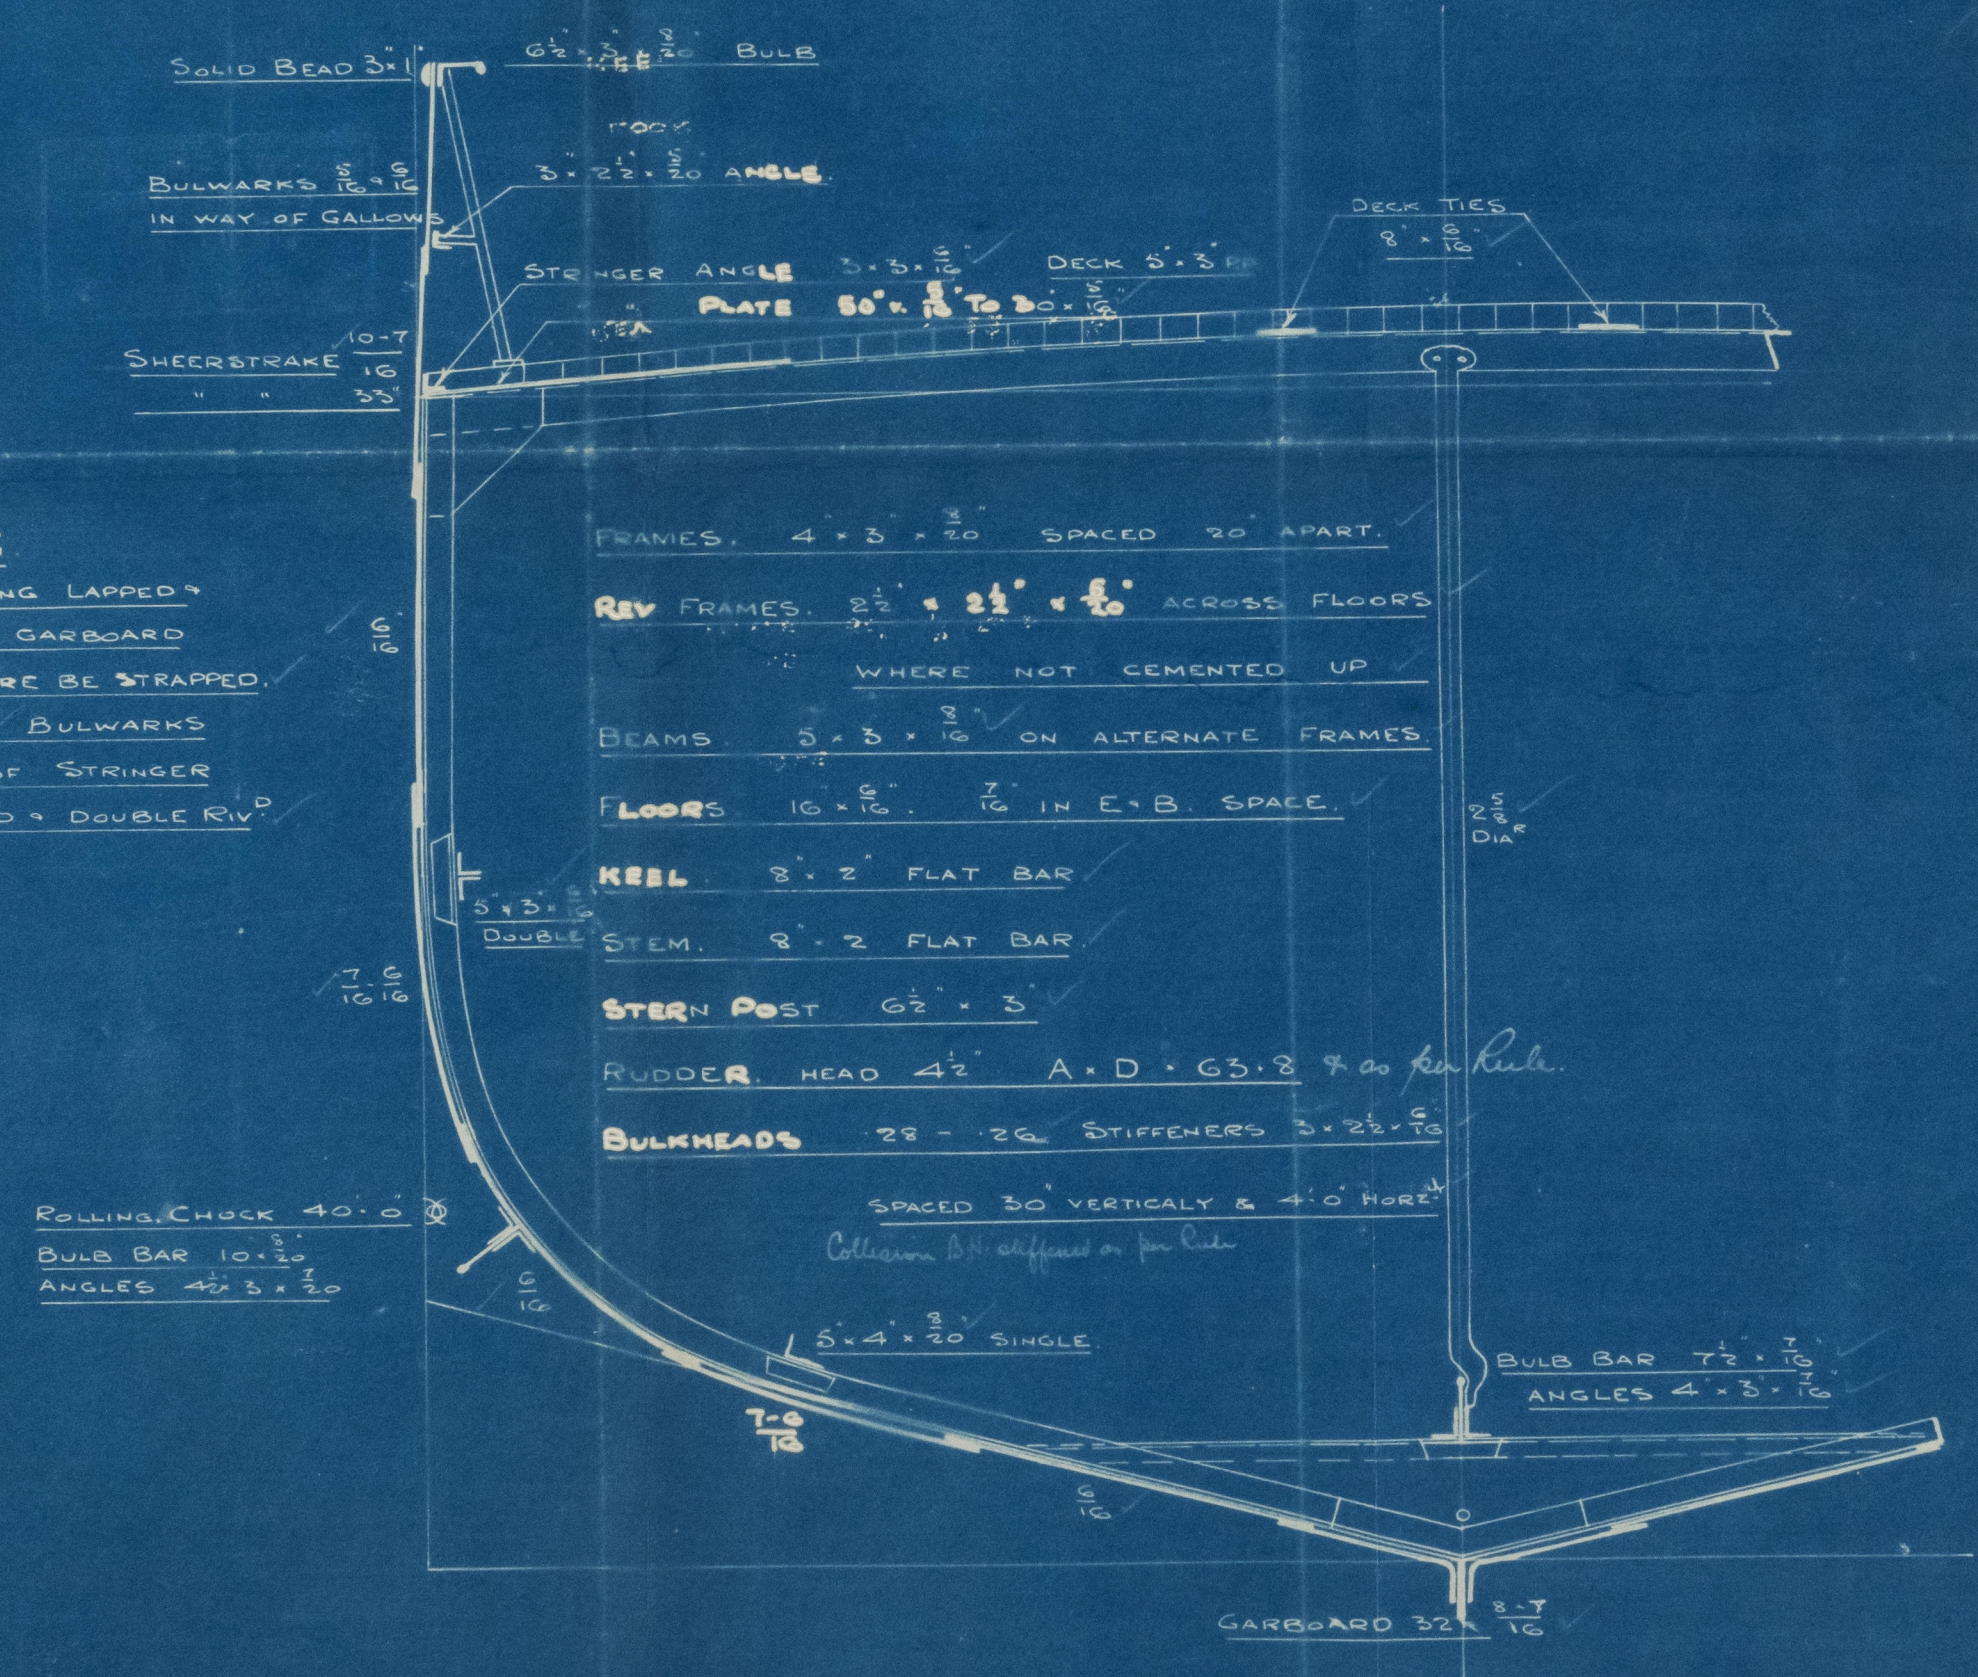

JS 2/10/11



Cochran + Sons.
~~No 517~~ No 518.

Duplicate
Midship Section.

s/s Merisa

Hull Rpt. No- 24780

RETAIN



© 2021

Lloyd's Register
Foundation

W1311-0011