

Arab & ...  
 35E-71  
 ...

# MIDSHIP SECTION

STEEL SCREW TRAWLER

SS 362

DIM = 115' 0" x 21' 6" x 11' 6" HOLD 12' 3" M<sup>LD</sup>

SCALE 1/2" = 1' 0"

ENGINE & BOILER CASING AS PREVIOUSLY APPROVED  
 DECK PLATED IN WY OF E&B CASING

## NUMERALS AS PER RULES

1/2 GIRTH 18.85  
 1/2 BREADTH 10.70  
 DEPTH 12.79  
 42.324 1<sup>ST</sup> NO  
 = 113.87 LENGTH AS PER RULE.  
 4818.9784 2<sup>ND</sup> NO  
 21

## PROPORTIONS

D TO L 8.9  
 B L 5.3

## EQUIPMENT


1 <sup>ST</sup> BOWER	5 CWTs	EX	STOCK
2 <sup>ND</sup> "	4 1/2 "	"	"
3 <sup>RD</sup> "	2 1/2 "	"	"
90 FATHOMS	1	CABLE	
60 "	5 1/2	HAWSER	
60 "	4	WARP	

COCHRANE & SONS  
 IRON AND STEEL  
 15/1/06. 4968  
 SHIPBUILDERS  
 SELBY

COCHRANE & SONS

SELBY

YORKS

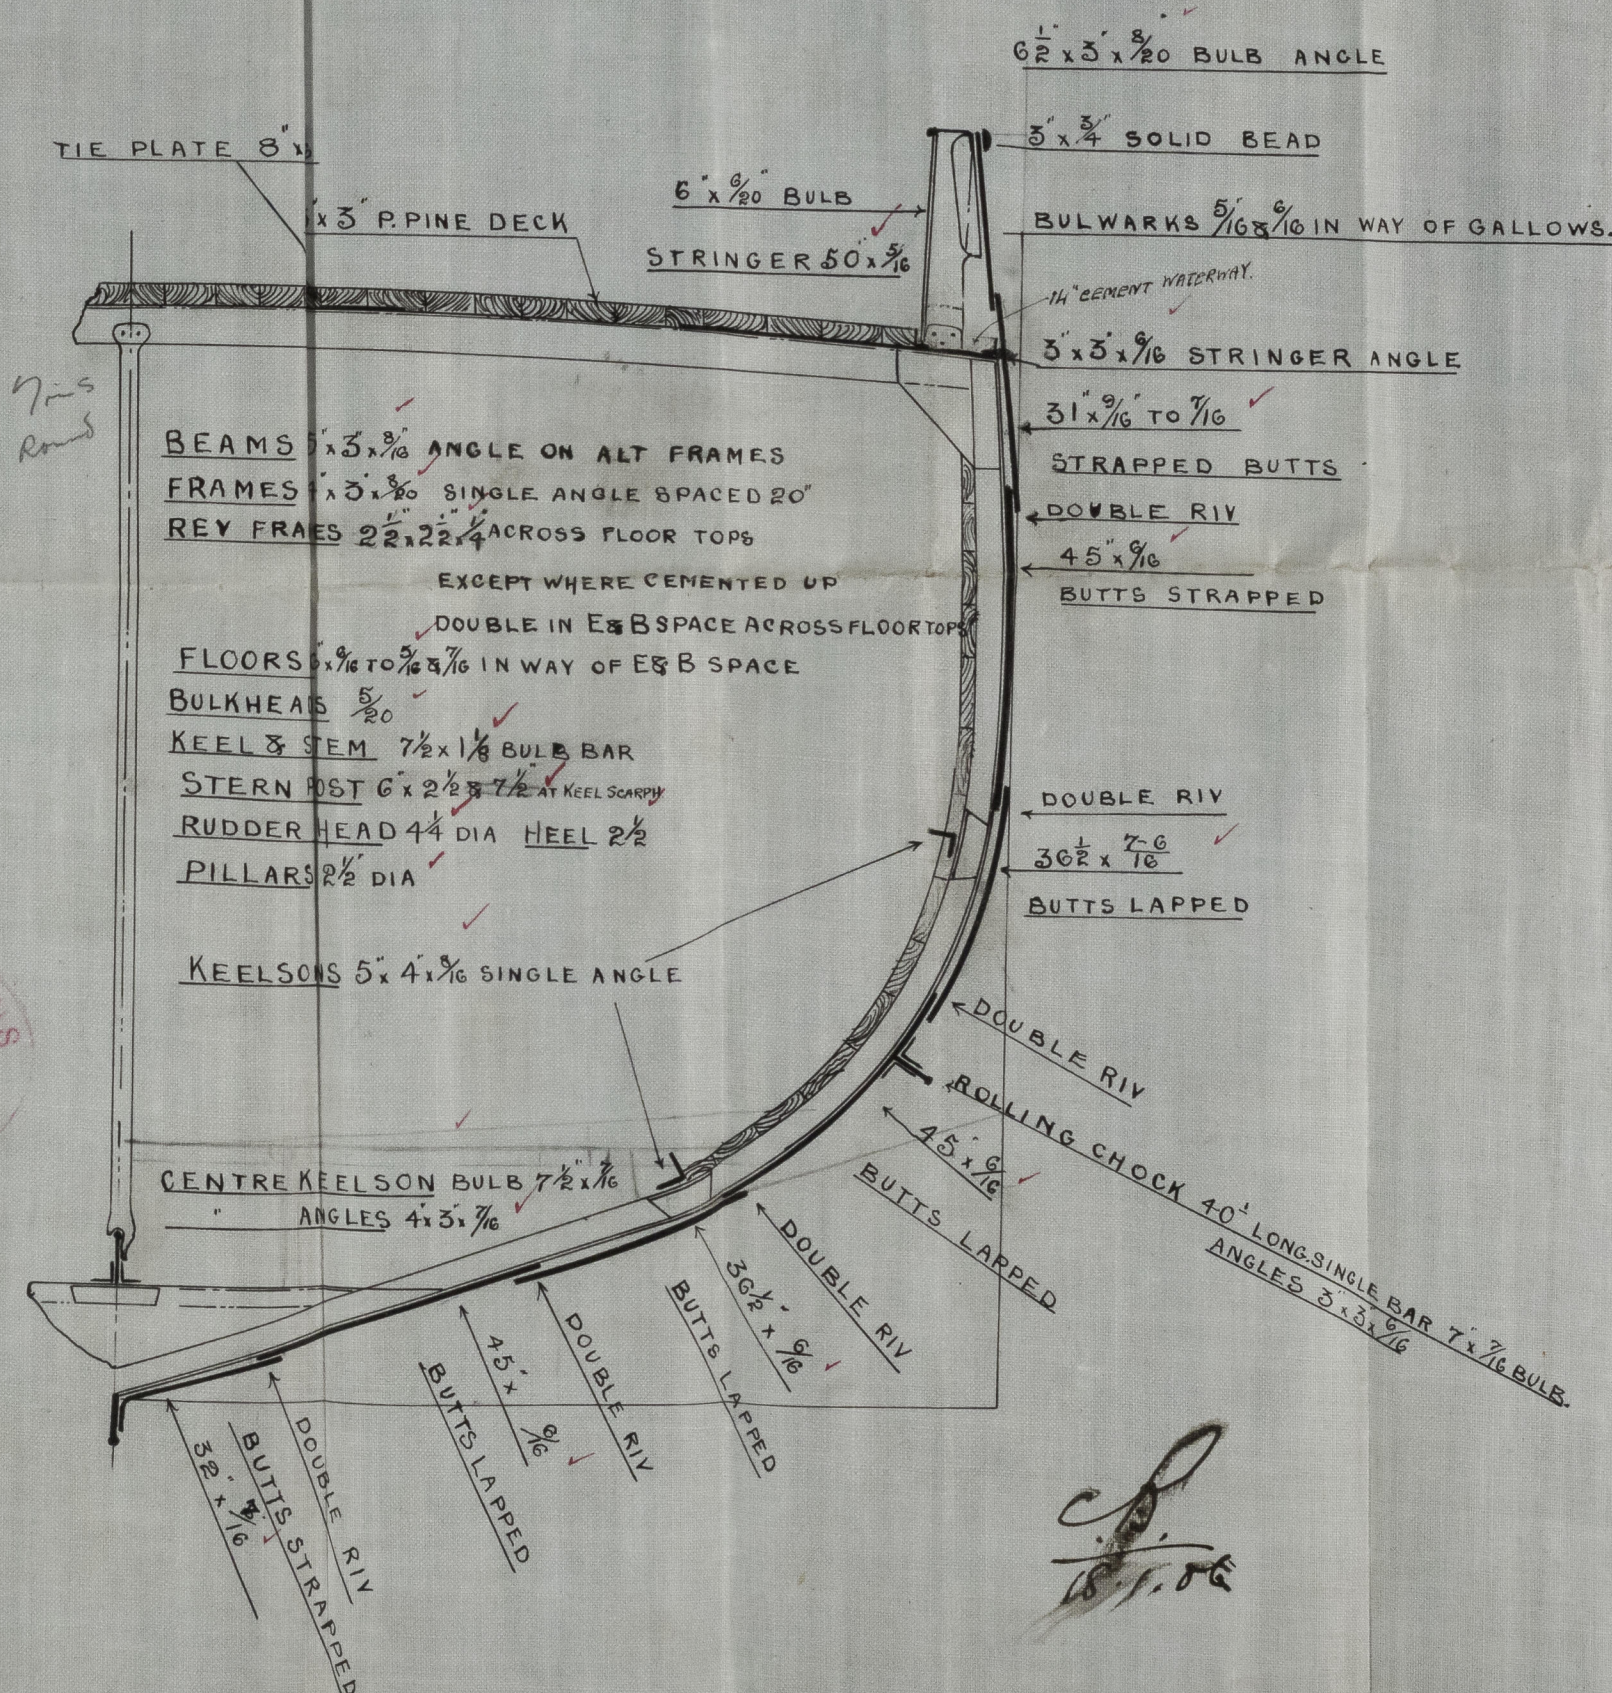



Cochrane & Sons.

N<sup>o</sup>. 362

Amended.

Midship Section

s/s Thistle.

Hull Report No. 17913



© 2021

Lloyd's Register  
Foundation



W1312-0018

2/6

Lloyd's Register  
Foundation