


Croft
1704
Wm Croft

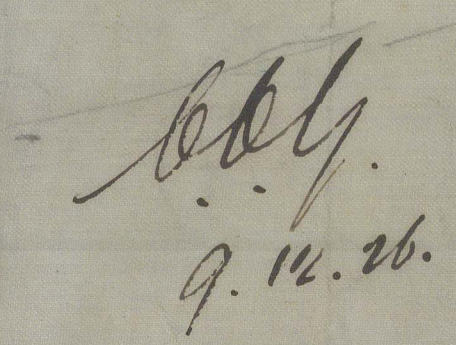


Profile

N^o 1494

Workman & Clark
Belfast

→ M.S. "CORABANK" ←

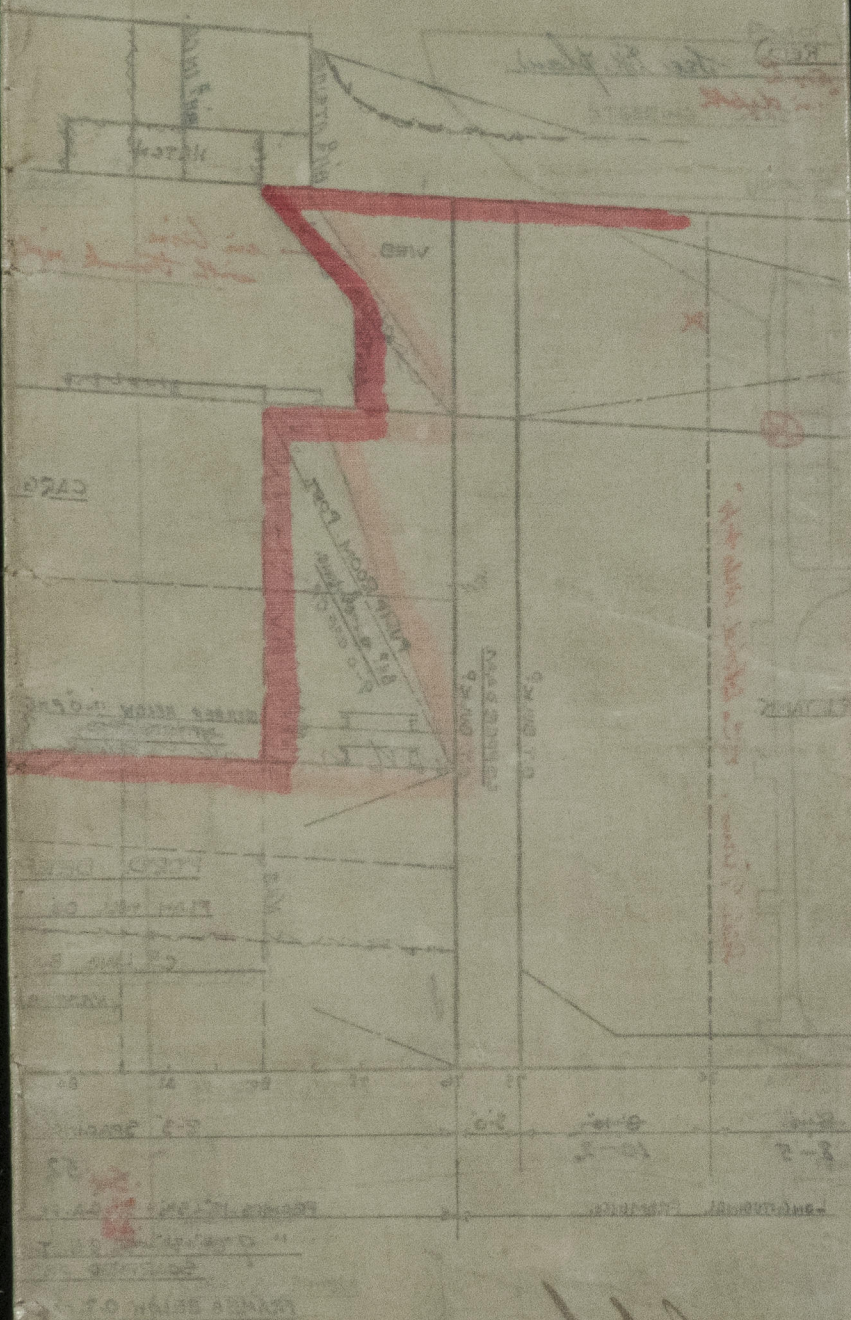

[Handwritten signature]
do. 11. 11. 11



© 2021

Lloyd's Register
Foundation