



Nº 494.

DECK PLATING & BEAMS.


SCALE: 1/8" = 1 FOOT.

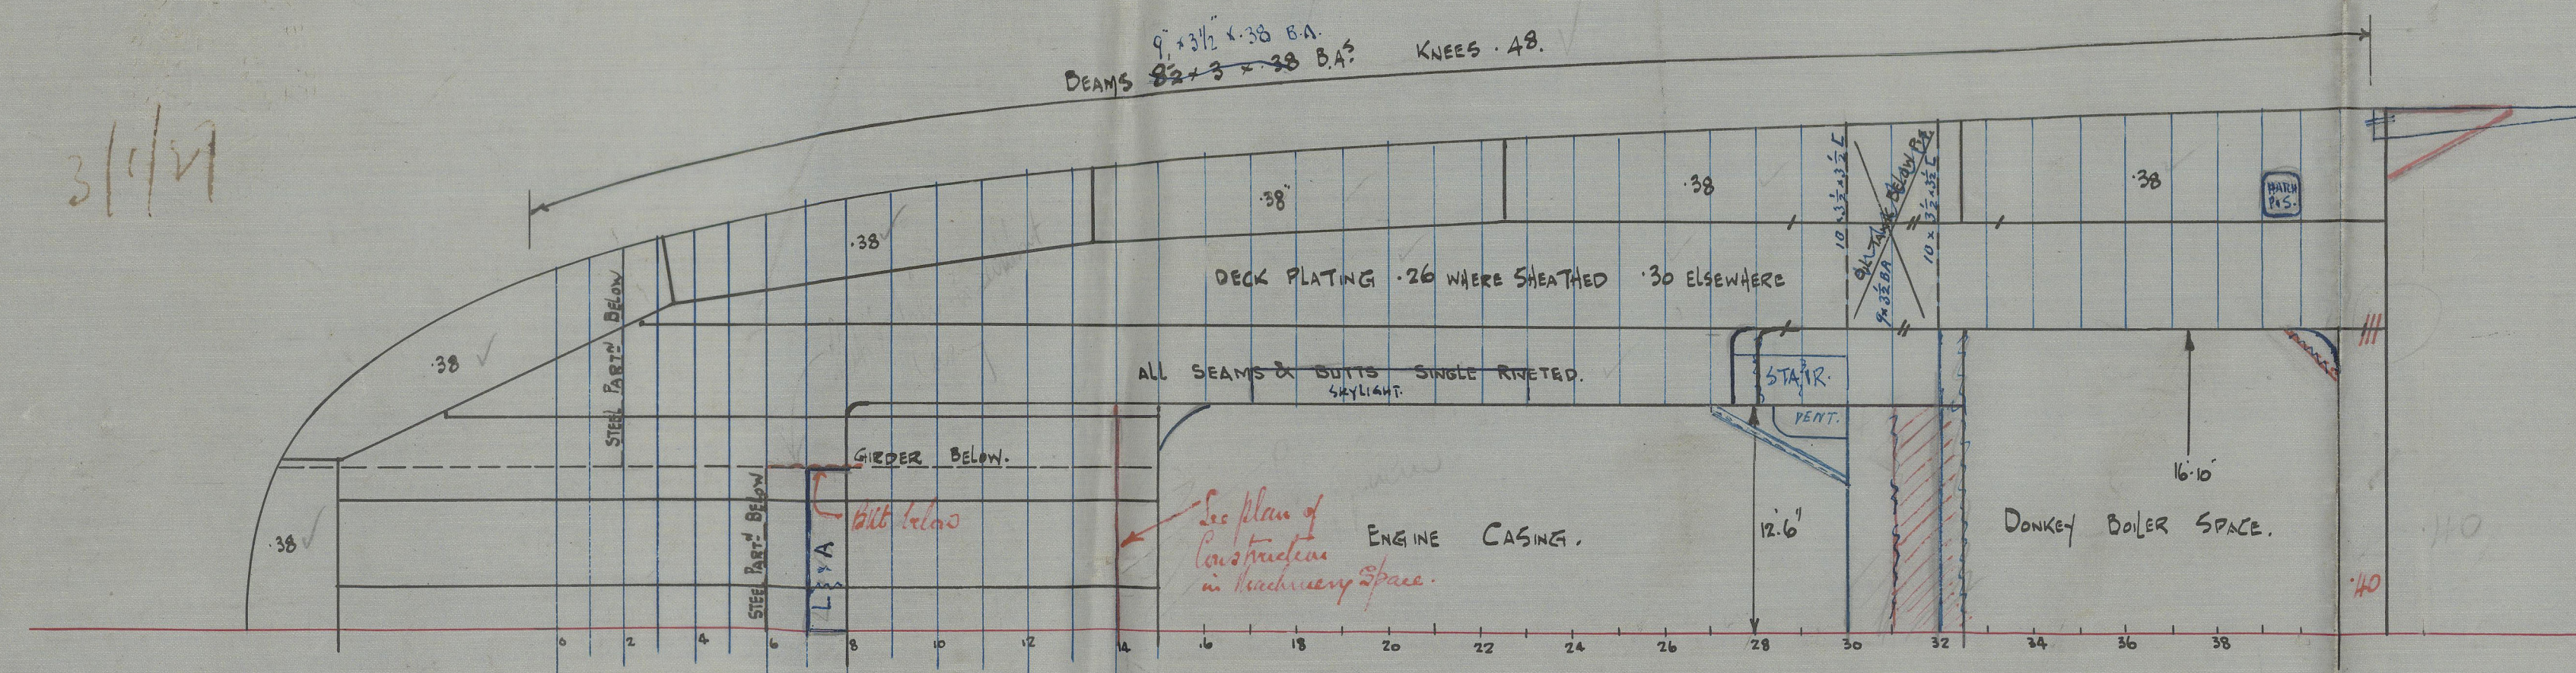

POOP DECK.

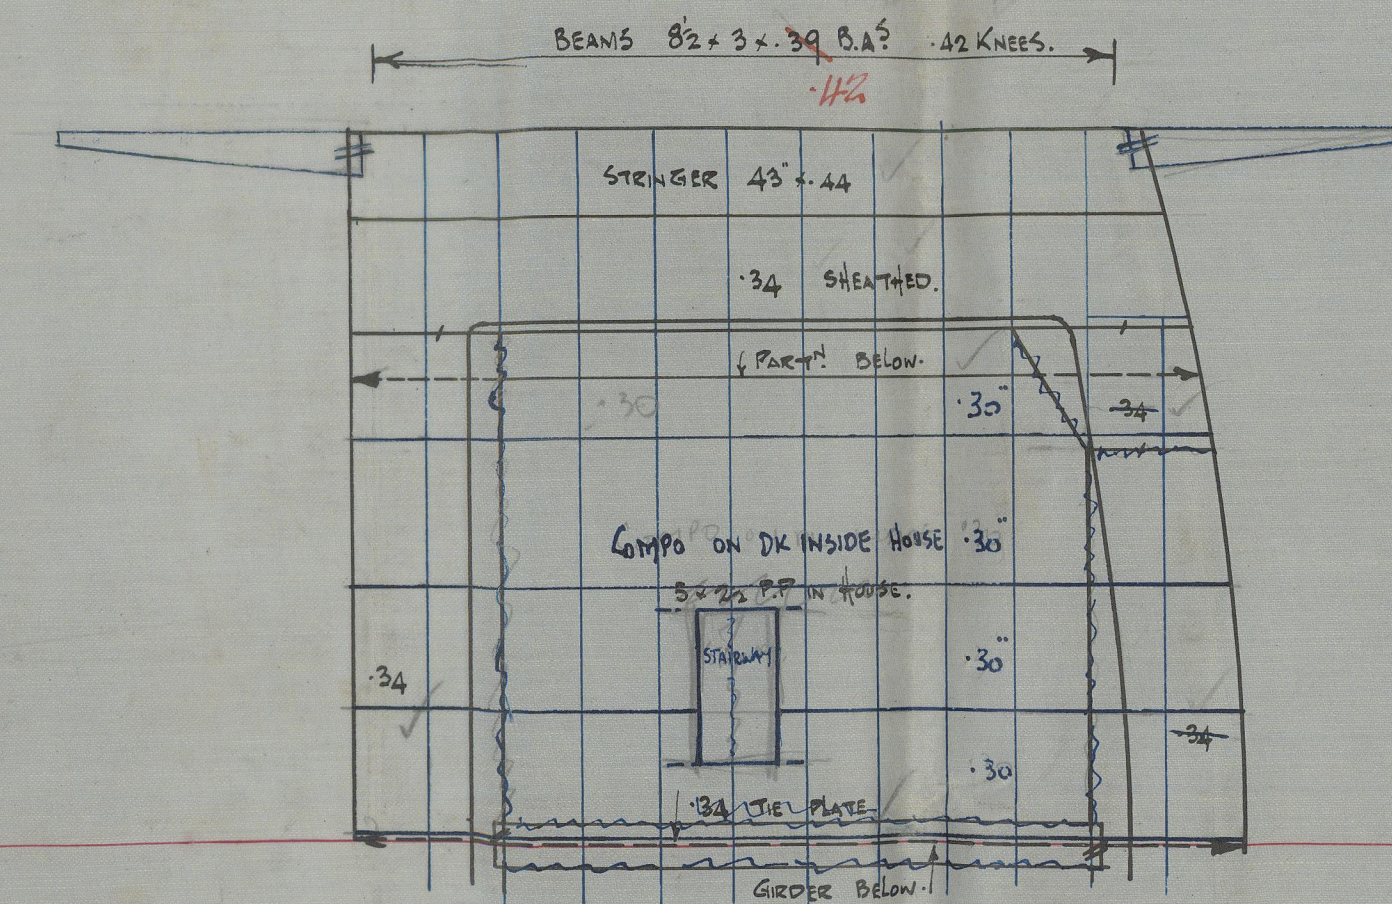


BRIDGE DECK.

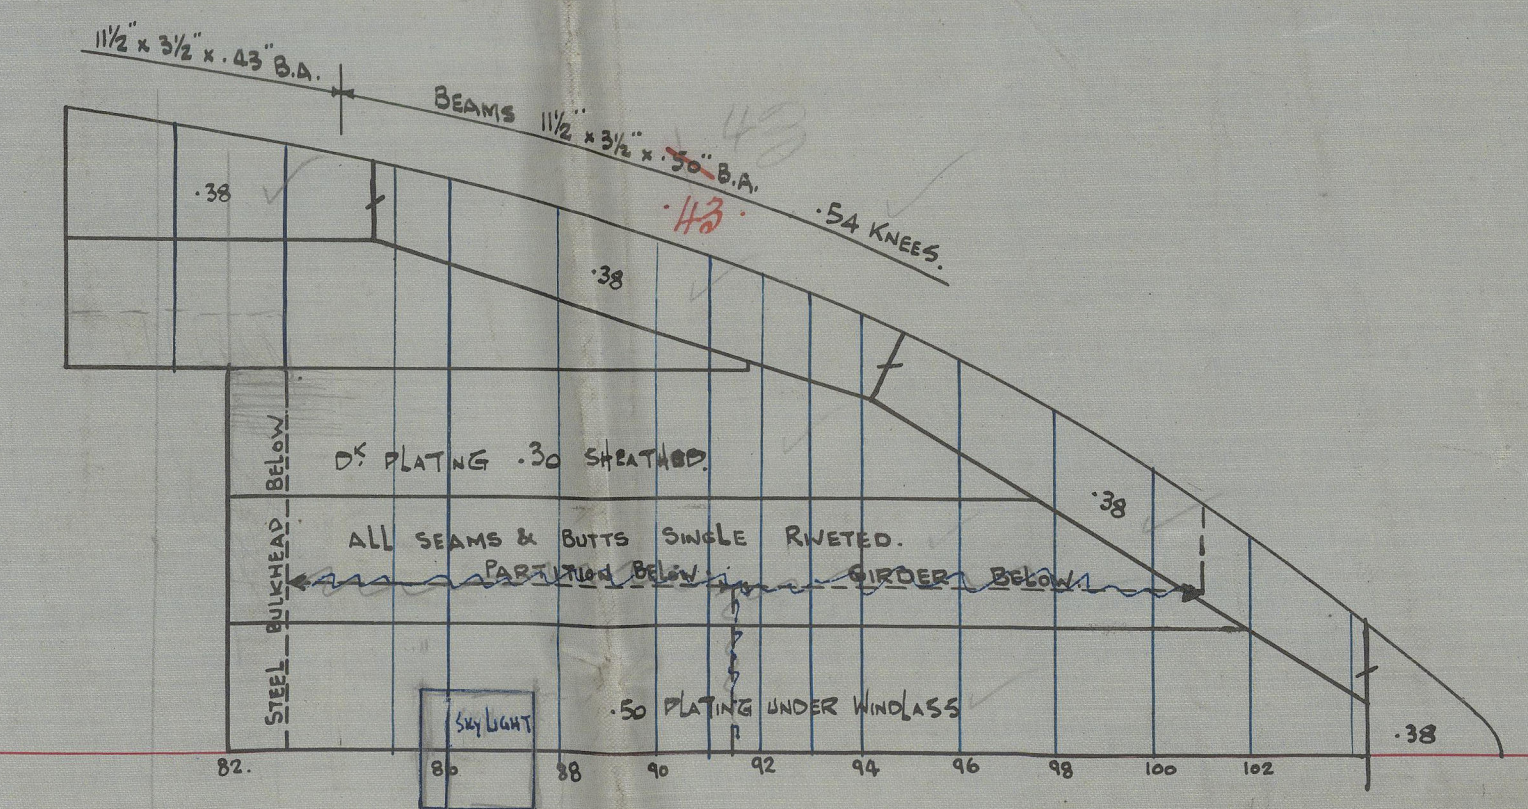

FORECASTLE DECK.


UPPER DECK STRINGER TO BE INCREASED 10" FROM 5'0" WIDE FORECASTLE TO 10'0" INSIDE POOP. (OWNER'S REQUIREMENT).

Scale: 1/8" = 1 FOOT.

 


UPPER DECK.

UPPER DECK.

 

2ND DECK.

2ND DECK.

 

LOWER DECK.

Deck Plan

No 494

Workman & Clark

Belfast

M.S. CORABANK

REMAIN



© 2021

Lloyd's Register
Foundation