

For the information of Surveyors and the Committee only.

Received at



Lloyd's Register of British & Foreign Shipping.

(Report on Vessel No. 27768 Port Hull)

No.

SHIP FORGINGS OR CASTINGS.

I have to report that the undermentioned Iron or Steel Forgings or Castings, manufactured by *J. S. Forster & Sons Ltd* of *Sunduland* for the Vessel No. *164*, being built by *Goole S. B. Co* of *Goole* have been inspected by me as set forth below and found to be, so far as can be seen, *Sound*

Mark on Forgings or Castings.

Lloyd's

No. 5968




MR

M. Robertson

Sunduland, 24-2-14

	STERN FRAME.	RUDDER FRAME.	STEM.
Material*	Scrap Iron	Scrap Iron	
How made	Forged	Forged	
Dimensions	6 1/2" x 2 3/4"	4 1/4" dia to 3 1/4" x 3"	
Progress on Inspection	Forged & Smithed	Forged & Smithed	
Date when Inspected	12.12.13 to 18.12.13	19.1.14 to 20.2.14	
CASTINGS.			
Tests on Standard Test Pieces.			
Tensile Test—			
Tons per square inch			
Extension per cent.			
Cold Bending Test—			
Angle before fracture			
Drop Test—			
Height from ground			
Hammering Test—			
If made according to Rules and found satisfactory			

SKETCHES OF FRAMES SHOWING POSITION AND DESCRIPTION OF WELDS OF FORGINGS.

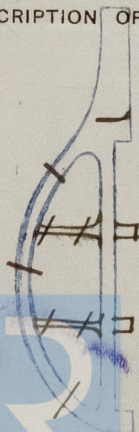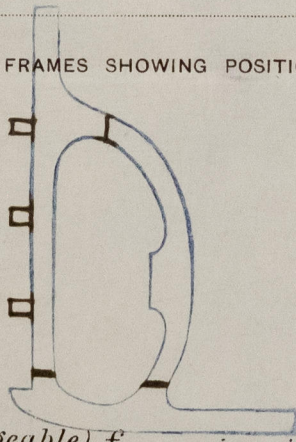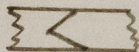

Fee (if any chargeable) £

To be paid at

* If of Iron, state whether scrap or puddled Iron. If of steel, state whether made on the Open Hearth process.