

PRINCIPAL DIMENSIONS:-

LENGTH B.P	315-0
BREADTH EXT.	46-6
" MOULDED	46-2½
DEPTH MOULDED	23-2

DEPTH TO LENGTH = 12.98

S. S. N^o 430.


SCALE $\frac{1}{2}$ = 1 FOOT.

CLASS 100A LLOYDS.

THREE DECK RULES.

NUMERALS:-	
HALF BREADTH MLD.	23.10
HALF GIRTH	43.73
DEPTH AS PER RULE	<u>24.10</u>

90.93
 LESS 4.00
 86.93 = FRAMING NO
 LENGTH AS PER RULE 313
 26270 = PLATING NO

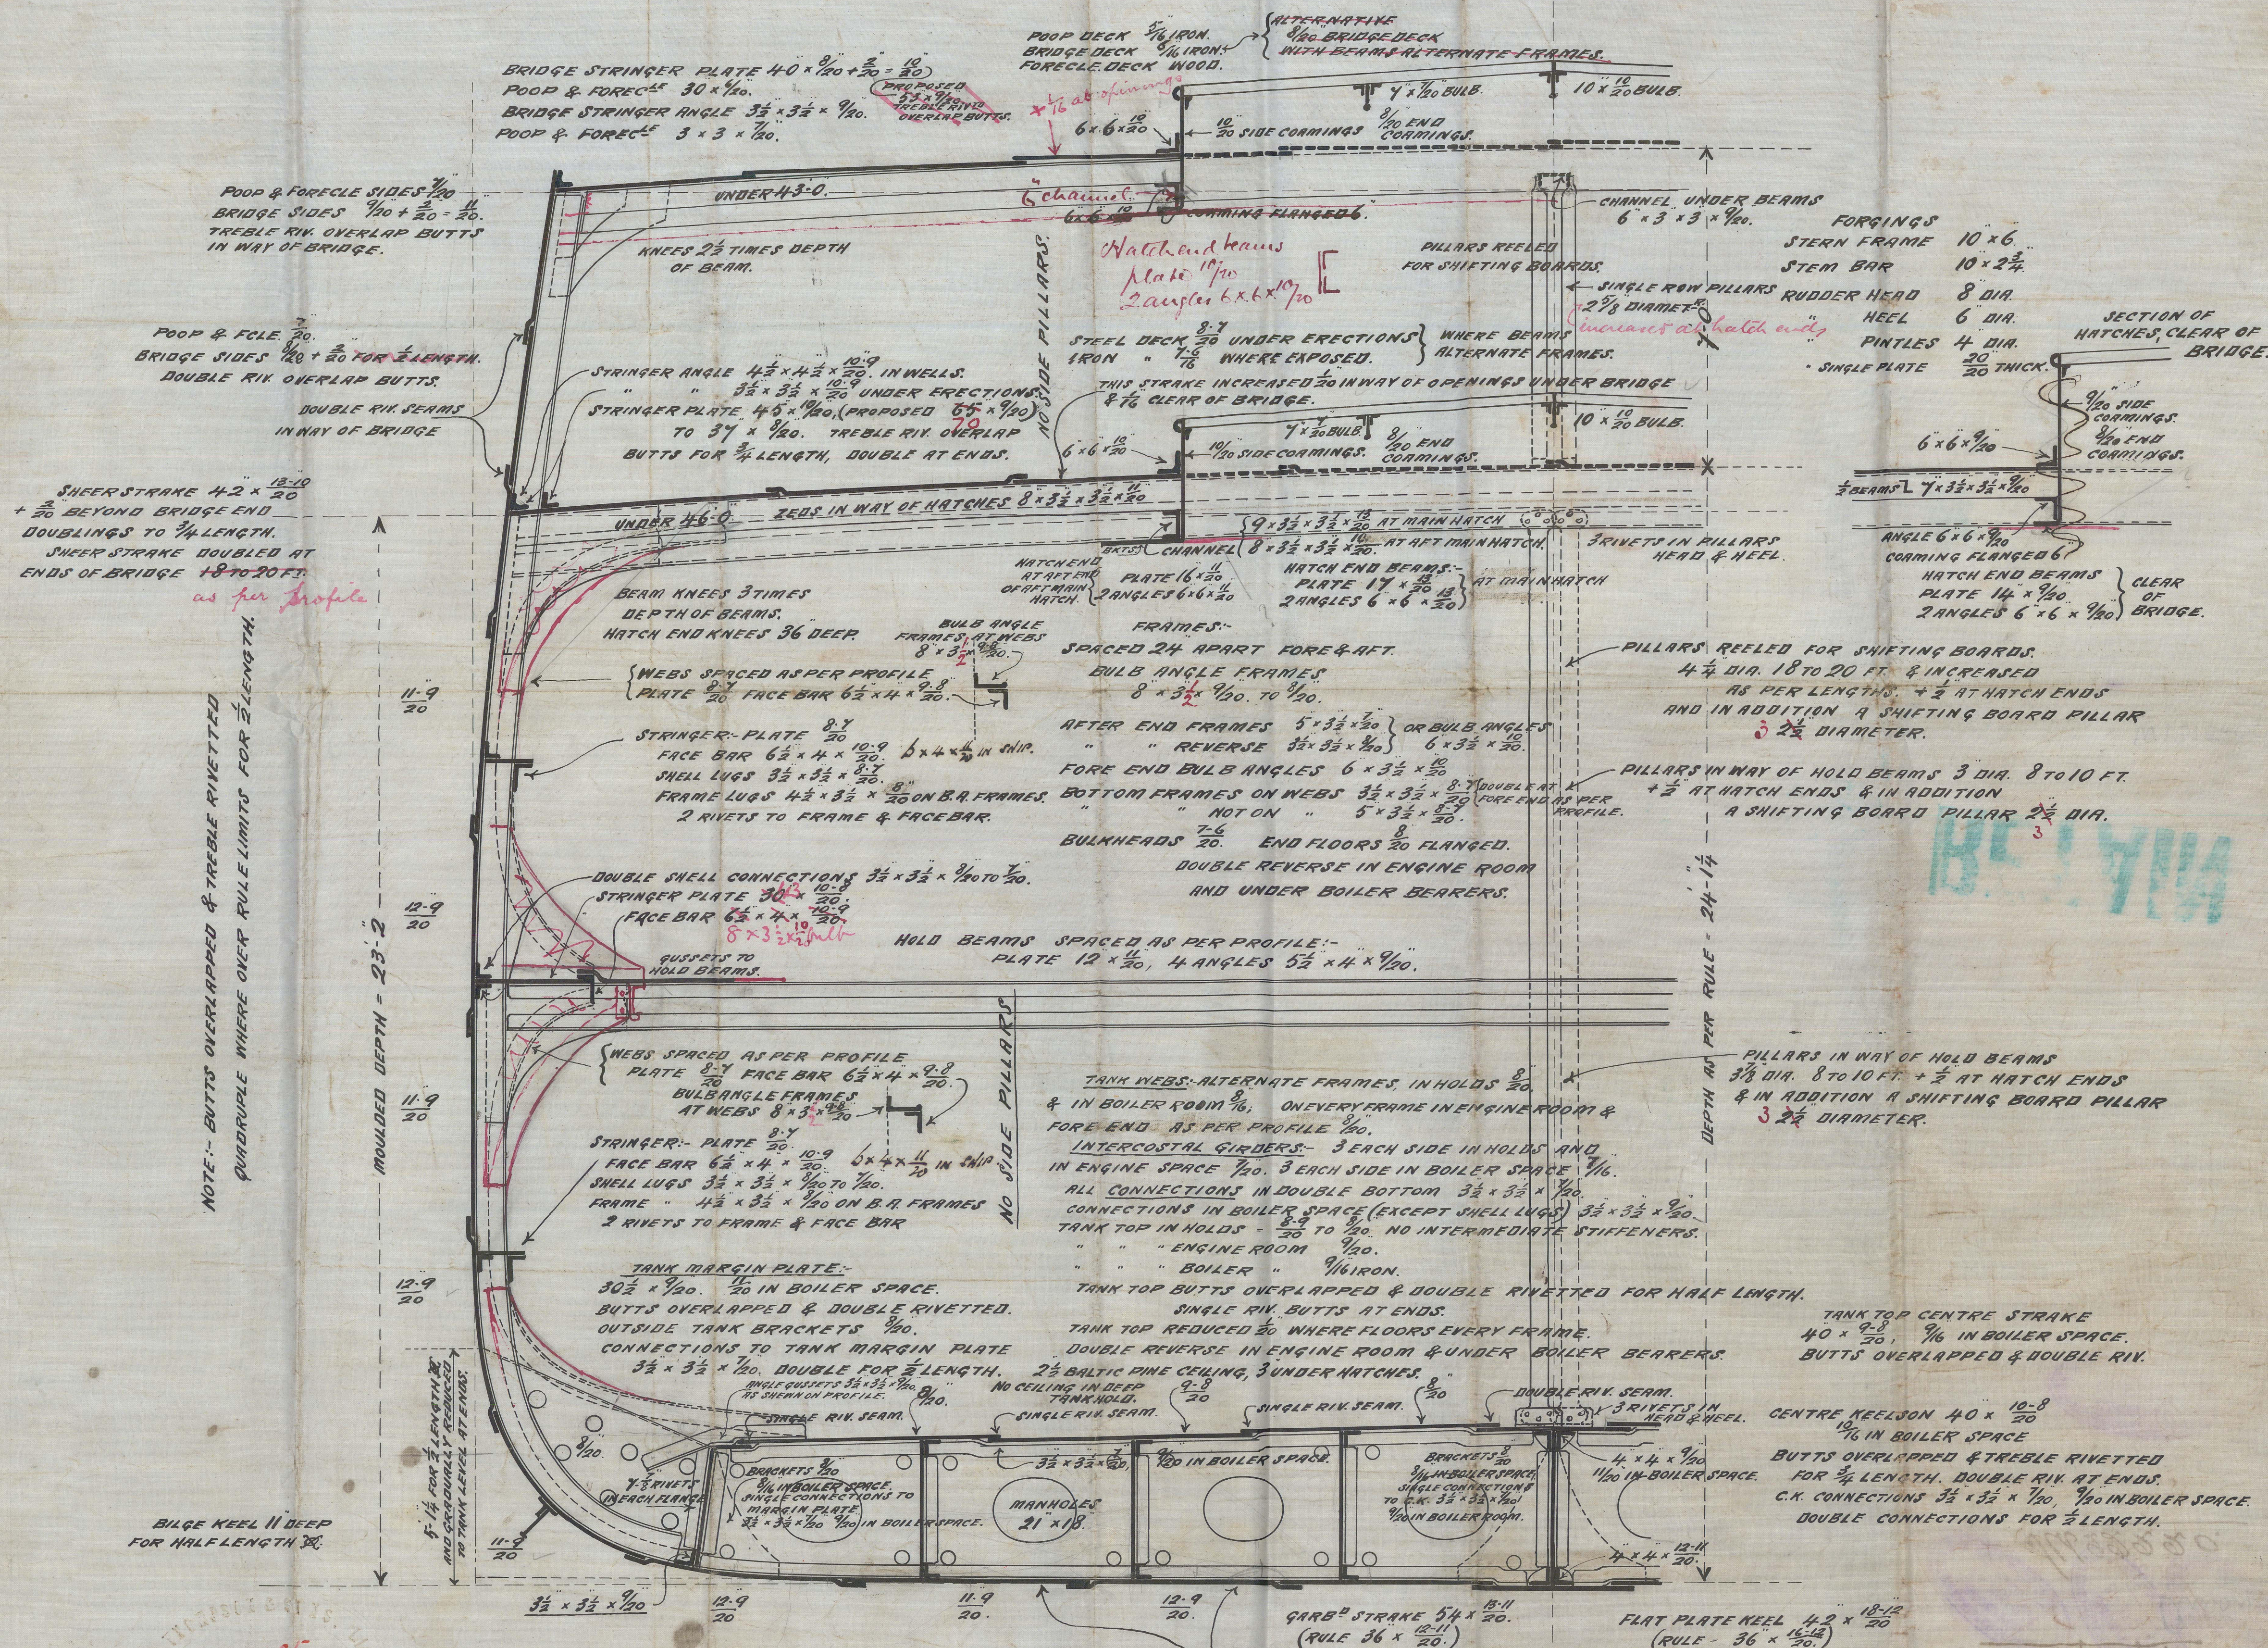

NOTE:- SHELL PLATING TO BE REDUCED $\frac{1}{20}$ WHEN
 $\frac{11}{30}$ & ABOVE WITHIN RANGE OF DOUBLE BOTTOM
 WHERE FLOORS ARE FITTED TO EVERY FRAME.

MIDSHIP THICKNESSES TO BE
MAINTAINED FORWARD TO
COLLISION BULKHEAD.

NOTE:- KEEL & GARBD^D STRAKES
ARE INCREASED IN WIDTH & THICKNESS
IN LIEU OF KEEL DOUBLING.

Messrs J. L. Thompson & Son

Tricks in Section.

No 430

S.S. "NORDAMERIKA"

Anana

Slid 22220.

REMAIN

© 2021

Lloyd's Register
Foundation