


*S. S. N<sup>o</sup> 430.*



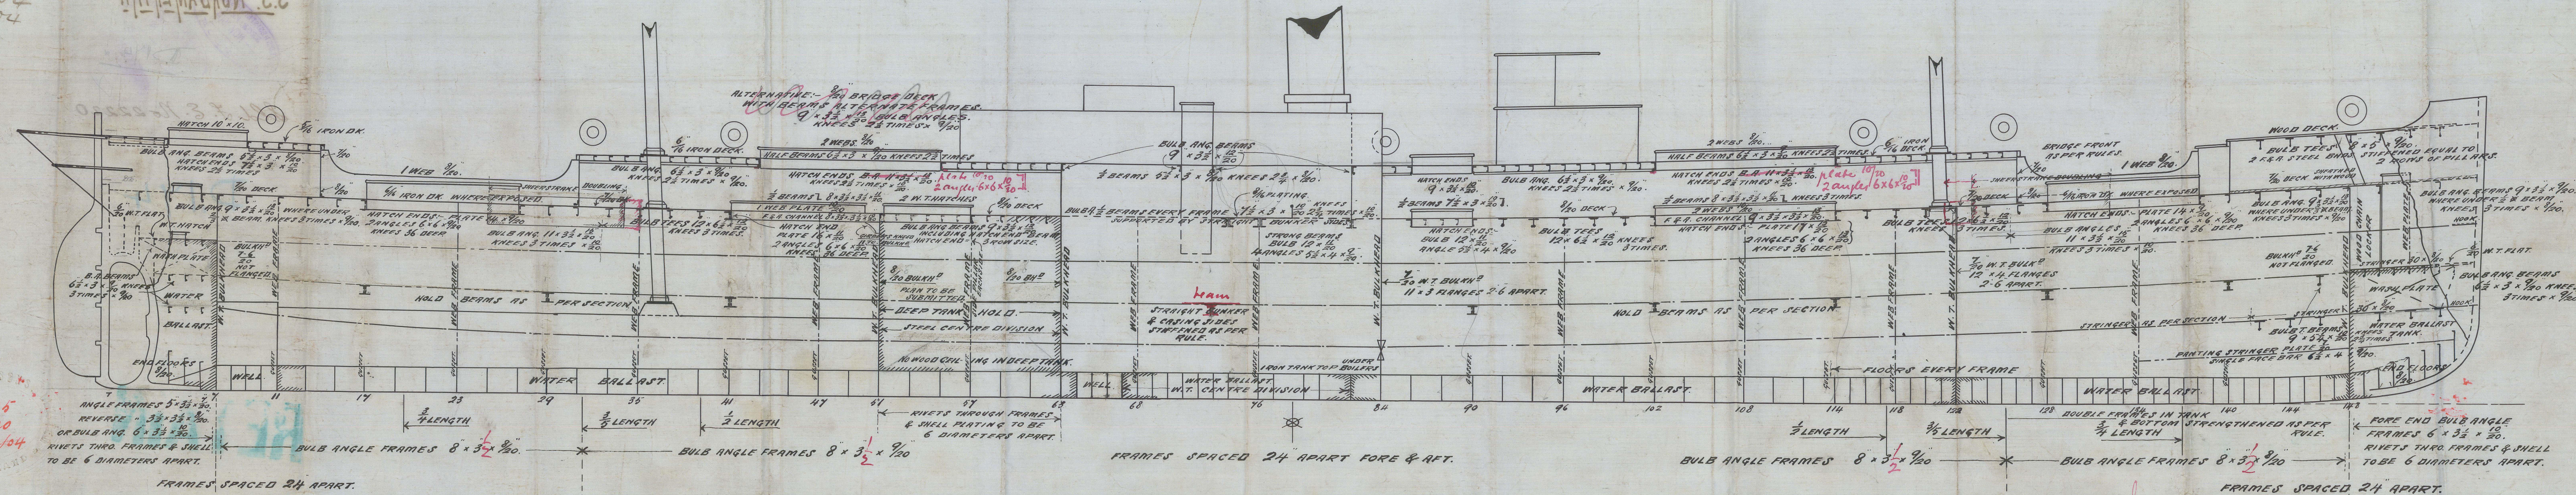

Messrs J. L. Thompson & Son

Profile

No 430

<sup>a</sup> ANGLO  
EX

S.S. "NORDAMERIKA"

D174

Sld F. E. No 22220

D174



© 2021

Lloyd's Register  
Foundation