

PLAN No. 4026

FOR ENCLOSURE TO

Messrs Lloyd's Surveyor

Hull FROM

COCHRANE & SONS, LTD.

SHIPBUILDERS, SELBY

DATE 3/3/14

MIDSHIP SECTION

STEEL SCREW TRAWLER

Nº 607


DIMENSIONS 122'-0" B.P. x 22'-3" Ex x 12'-4" MLD

SCALE 1/2" INCH

TO CLASS 100 A.I. STEAM TRAWLER

DECK PLATED OVER IN WAY OF MACHINERY

E & B CASING AS PREVIOUSLY APPROVED

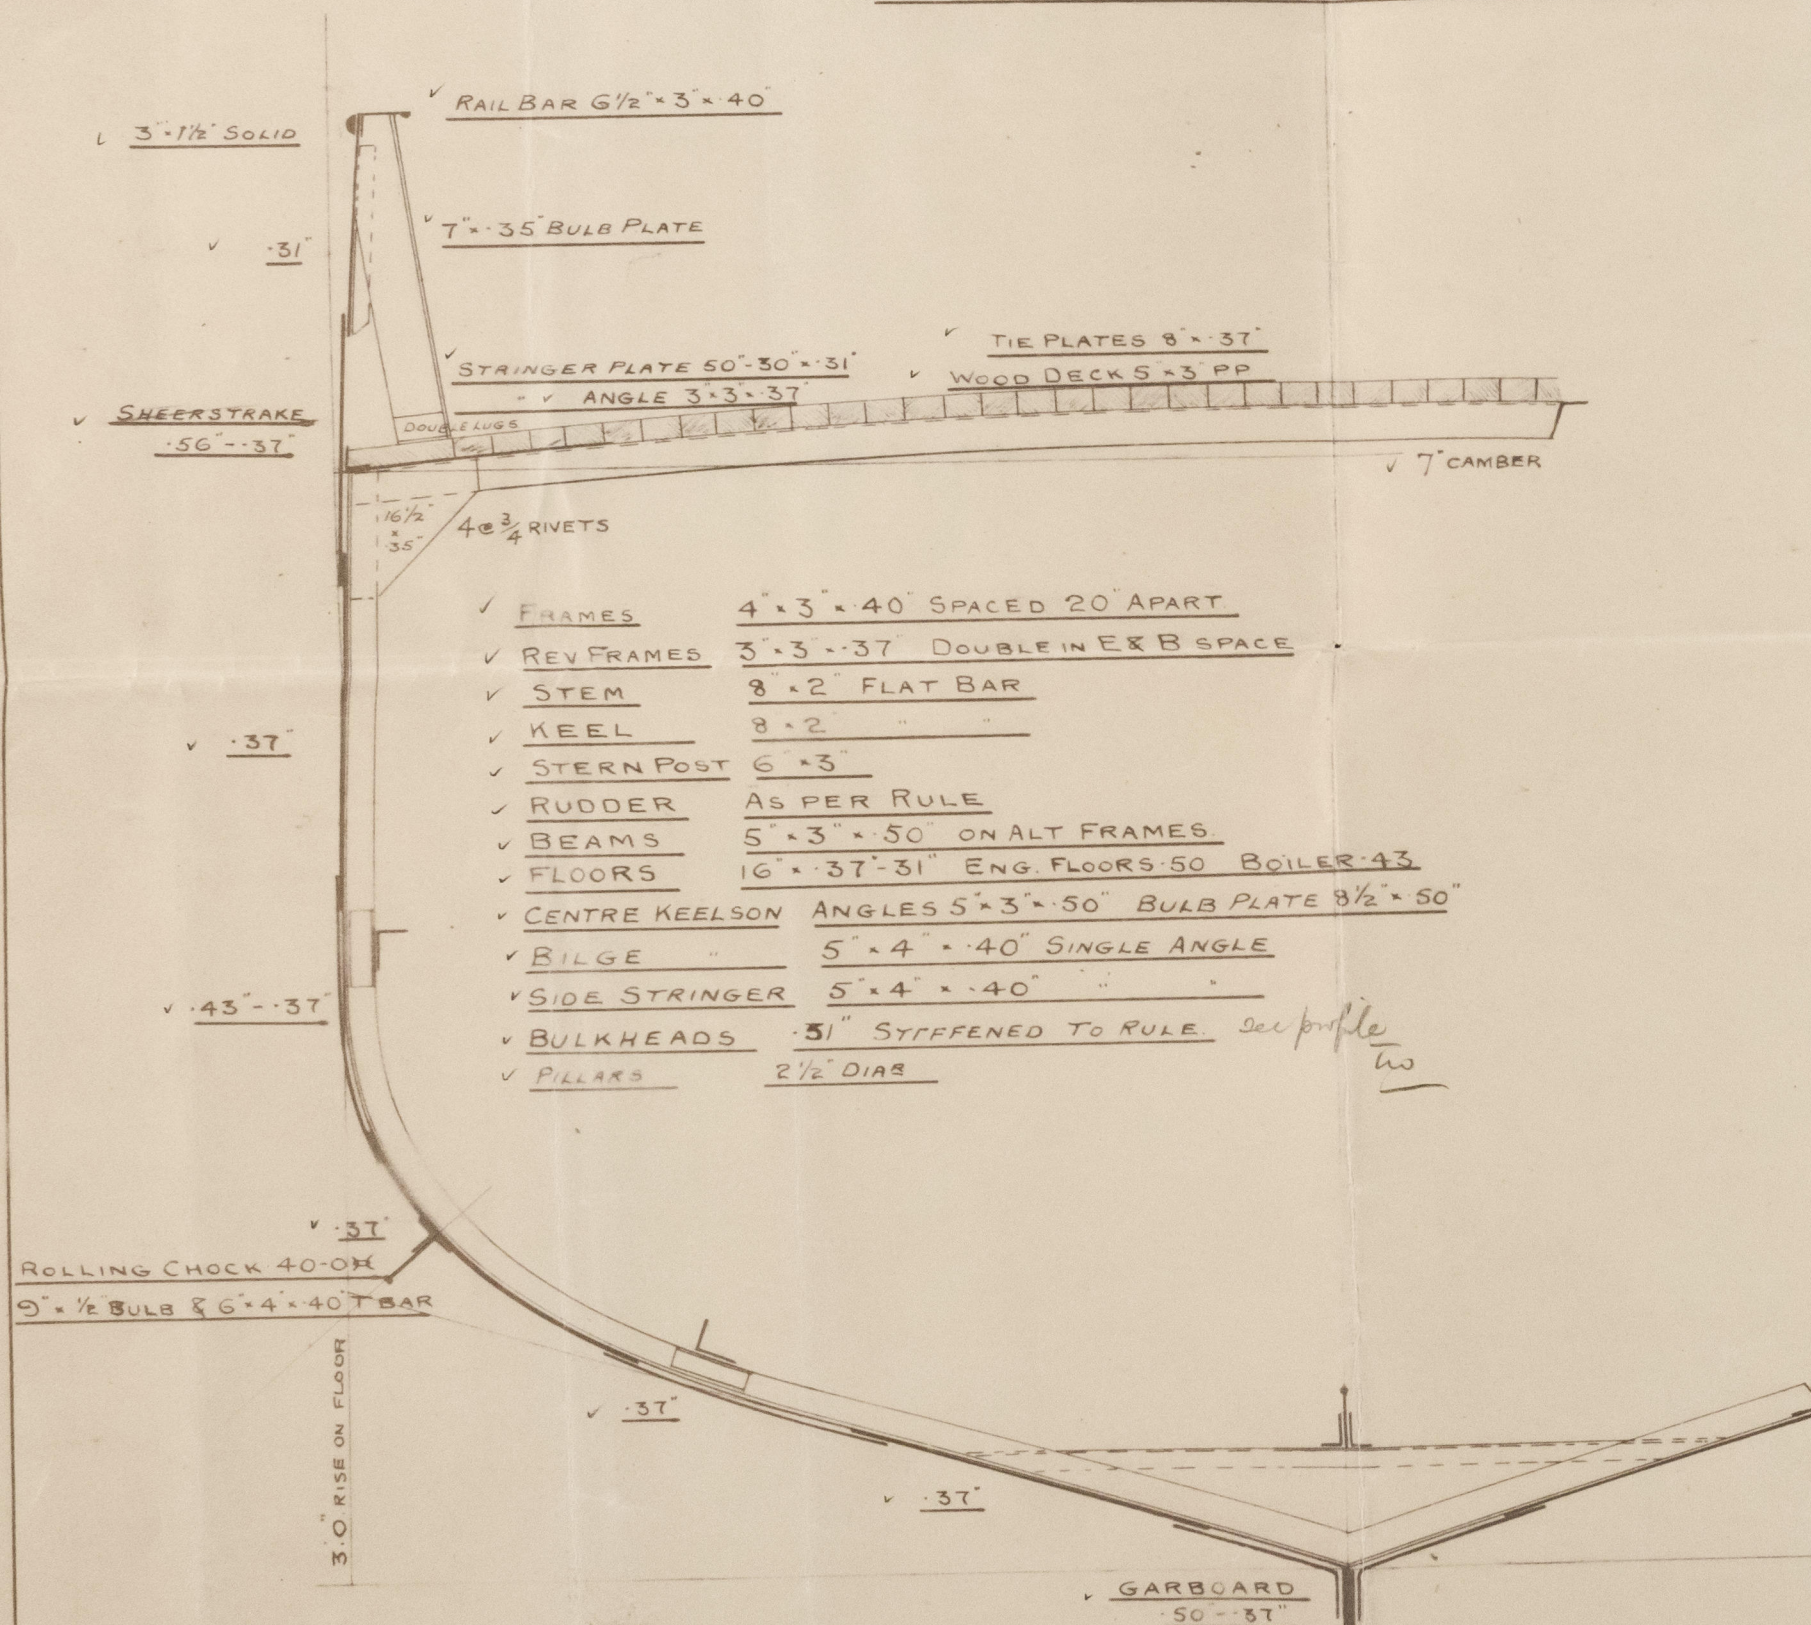

NUMERALS

B + D - - - - - 34.45

L x (B + D) - - - - - 4202.9

PROPORTIONS

L / B - - - - - 5.51

L / D - - - - - 9.89

EQUIPMENT

1 ANCHOR 5 1/4 CWTs Ex Stock or 6 1/2 CWTs Stock 15

1 " 4 3/4 " " " " 6 " "

1 " 2 1/2 " " " " " "

90 FATHOMS 1" STUD LINK CABLE

60 " 6" HAWSER

60 " 4 1/2" WARP

RIVETING

BUTTS OF SHELL PLATING TO BE

OVERLAPPED & DOUBLE RIVETED

EXCEPT GARBOARD & SHEER STRAKE

WHICH ARE TO BE STRAPPED

LANDINGS DOUBLE RIVETED

BULWARKS SINGLE RIVETED

answ
5-3-14

6.2.14.



© 2021

Lloyd's Register Foundation

W 13/7-0185

Cochrane & Sons. Ltd.

No 607.



Midship Section

Dimensions

122-0' x 22-12' x 12-33'

1/5 Mena

Hull Rpt no - 27946

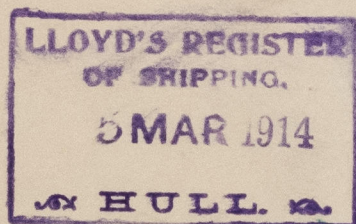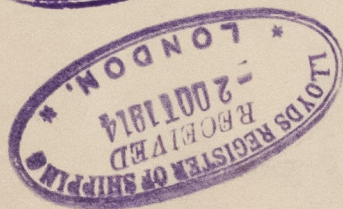

RETAIN



© 2021

Lloyd's Register
Foundation

W1317-0185